

FEE \$	10.00
TCP \$	500.00
SIF \$	292.00

PLANNING CLEARANCE
 (Single Family Residential and Accessory Structures)
Community Development Department

BLDG PERMIT NO. 85310



Your Bridge to a Better Community

BLDG ADDRESS 408 E Broken Arrow SQ. FT. OF PROPOSED BLDGS/ADDITION 1295

TAX SCHEDULE NO. 2943-174-19-010 SQ. FT. OF EXISTING BLDGS -0-

SUBDIVISION Flint Ridge TOTAL SQ. FT. OF EXISTING & PROPOSED 1295

FILING 1 BLK 1 LOT 10 NO. OF DWELLING UNITS:
 Before: 0 After: 1 this Construction

(1) OWNER TML Enterprises Inc NO. OF BUILDINGS ON PARCEL
 Before: 0 After: 1 this Construction

(1) ADDRESS Box 2569, Gr Jet CO 81502 USE OF EXISTING BUILDINGS Single Family Res.

(1) TELEPHONE 201-8022 DESCRIPTION OF WORK & INTENDED USE New Single Family

(2) APPLICANT TML Enterprises Inc TYPE OF HOME PROPOSED:
 Site Built Manufactured Home (UBC)
 Manufactured Home (HUD)
 Other (please specify) _____

(2) ADDRESS Box 2569 Gr Jet CO 81502
 (2) TELEPHONE 201-8022

REQUIRED: One plot plan, on 8 1/2" x 11" paper, showing all existing & proposed structure location(s), parking, setbacks to all property lines, ingress/egress to the property, driveway location & width & all easements & rights-of-way which abut the parcel.

THIS SECTION TO BE COMPLETED BY COMMUNITY DEVELOPMENT DEPARTMENT STAFF

ZONE RMF-8 Maximum coverage of lot by structures 70%

SETBACKS: Front 20' from property line (PL)
 or _____ from center of ROW, whichever is greater
 Side 5' from PL, Rear 10' from PL
 Maximum Height 35'

Permanent Foundation Required: YES NO

Parking Req'mt 2

Special Conditions _____

CENSUS 8 TRAFFIC 56 ANN# _____

Modifications to this Planning Clearance must be approved, in writing, by the Community Development Department. The structure authorized by this application cannot be occupied until a final inspection has been completed and a Certificate of Occupancy has been issued, if applicable, by the Building Department (Section 305, Uniform Building Code).

I hereby acknowledge that I have read this application and the information is correct; I agree to comply with any and all codes, ordinances, laws, regulations or restrictions which apply to the project. I understand that failure to comply shall result in legal action, which may include but not necessarily be limited to non-use of the building(s).


Applicant Signature [Signature] Date 6/24/02

Department Approval [Signature] Date 7/5/02

Additional water and/or sewer tap fee(s) are required:	YES <input checked="" type="checkbox"/>	NO <input type="checkbox"/>	W/O No. <u>5068</u>
Utility Accounting	<u>[Signature]</u>	Date	<u>7/2/02</u>

VALID FOR SIX MONTHS FROM DATE OF ISSUANCE (Section 9-3-2C Grand Junction Zoning & Development Code)


(White: Planning) (Yellow: Customer) (Pink: Building Department) (Goldenrod: Utility Accounting)

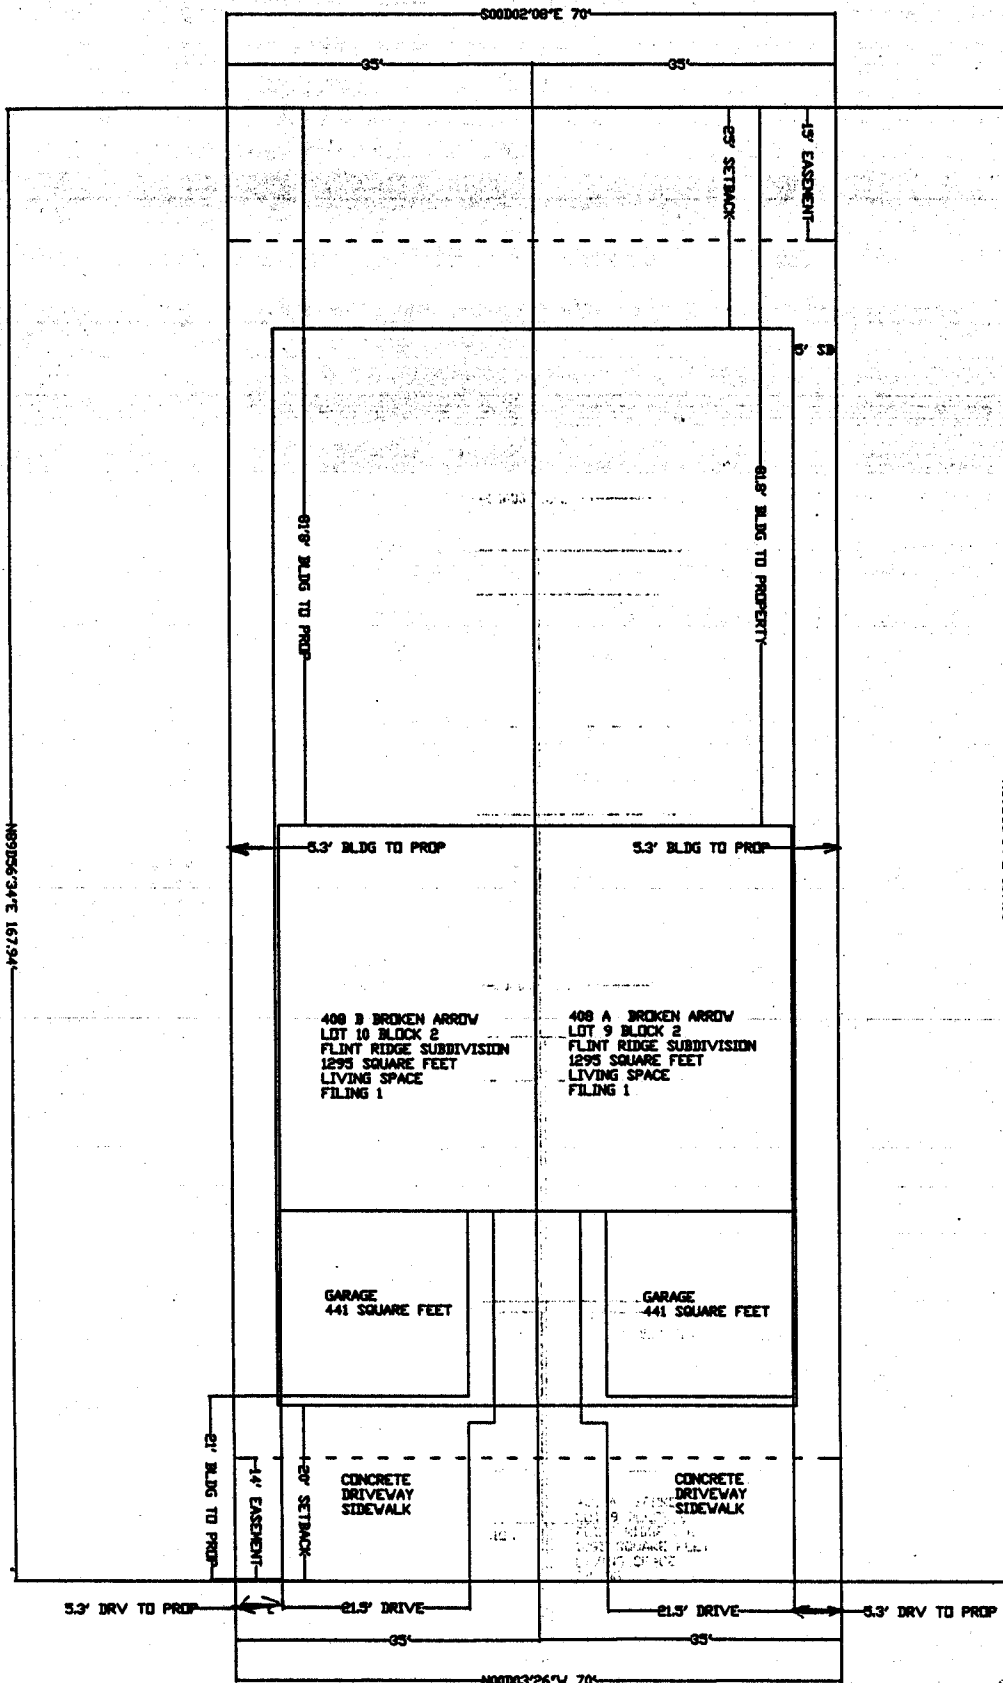

DRIVE OK
DML
7/1/02

(B)

ACCEPTED *C. Faye Wilson* 7/5/02.
 ANY CHANGE OF SETBACKS MUST BE APPROVED BY THE CITY PLANNING DEPT. IT IS THE APPLICANT'S RESPONSIBILITY TO PROPERLY LOCATE AND IDENTIFY EASEMENTS AND PROPERTY LINES

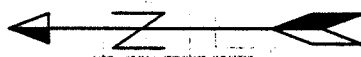

BROKEN ARROW