

FEE \$	10.00
TCR \$	500.00
SIF \$	292.00

**PLANNING CLEARANCE**  
 (Single Family Residential and Accessory Structures)  
**Community Development Department**

BLDG PERMIT NO. 85308



Your Bridge to a Better Community

BLDG ADDRESS 4084 Broken Arrow Dr SQ. FT. OF PROPOSED BLDGS/ADDITION 1295 #

TAX SCHEDULE NO. 2943-174-19-009 SQ. FT. OF EXISTING BLDGS - 0

SUBDIVISION Hunt Ridge TOTAL SQ. FT. OF EXISTING & PROPOSED 1295 #

FILING 1 BLK 1 LOT 9 NO. OF DWELLING UNITS:  
 Before: 0 After: 1 this Construction

(1) OWNER TML Enterprises Inc NO. OF BUILDINGS ON PARCEL  
 Before: 0 After: 1 this Construction

(1) ADDRESS Box 2569 Gr Jet Co 81502 USE OF EXISTING BUILDINGS Single Family Res.

(1) TELEPHONE 201-8022 DESCRIPTION OF WORK & INTENDED USE New Single Family

(2) APPLICANT TML Enterprises Inc TYPE OF HOME PROPOSED:  
 Site Built  Manufactured Home (UBC)  
 Manufactured Home (HUD)  
 Other (please specify) \_\_\_\_\_

(2) ADDRESS Box 2569 Gr Jet Co 81502  
 (2) TELEPHONE 201-8022

**REQUIRED: One plot plan, on 8 1/2" x 11" paper, showing all existing & proposed structure location(s), parking, setbacks to all property lines, ingress/egress to the property, driveway location & width & all easements & rights-of-way which abut the parcel.**

**THIS SECTION TO BE COMPLETED BY COMMUNITY DEVELOPMENT DEPARTMENT STAFF**

ZONE RMF-8 Maximum coverage of lot by structures 70%

SETBACKS: Front 20' from property line (PL) Permanent Foundation Required: YES  NO   
 or \_\_\_\_\_ from center of ROW, whichever is greater

Side 5' from PL, Rear 10' from PL Parking Req'mt 2

Maximum Height 35' Special Conditions \_\_\_\_\_

CENSUS 8 TRAFFIC 56 ANNEX# \_\_\_\_\_

Modifications to this Planning Clearance must be approved, in writing, by the Community Development Department. The structure authorized by this application cannot be occupied until a final inspection has been completed and a Certificate of Occupancy has been issued, if applicable, by the Building Department (Section 305, Uniform Building Code).

I hereby acknowledge that I have read this application and the information is correct; I agree to comply with any and all codes, ordinances, laws, regulations or restrictions which apply to the project. I understand that failure to comply shall result in legal action, which may include but not necessarily be limited to non-use of the building(s).


Applicant Signature [Signature] Date 6/26/02

Department Approval [Signature] Date 7/5/02

Additional water and/or sewer tap fee(s) are required:	YES <input checked="" type="checkbox"/>	NO	W/O No. <u>5867</u>
Utility Accounting	<u>[Signature]</u>	Date	<u>7/5/02</u>

VALID FOR SIX MONTHS FROM DATE OF ISSUANCE (Section 9-3-2C Grand Junction Zoning & Development Code)


(White: Planning) (Yellow: Customer) (Pink: Building Department) (Goldenrod: Utility Accounting)

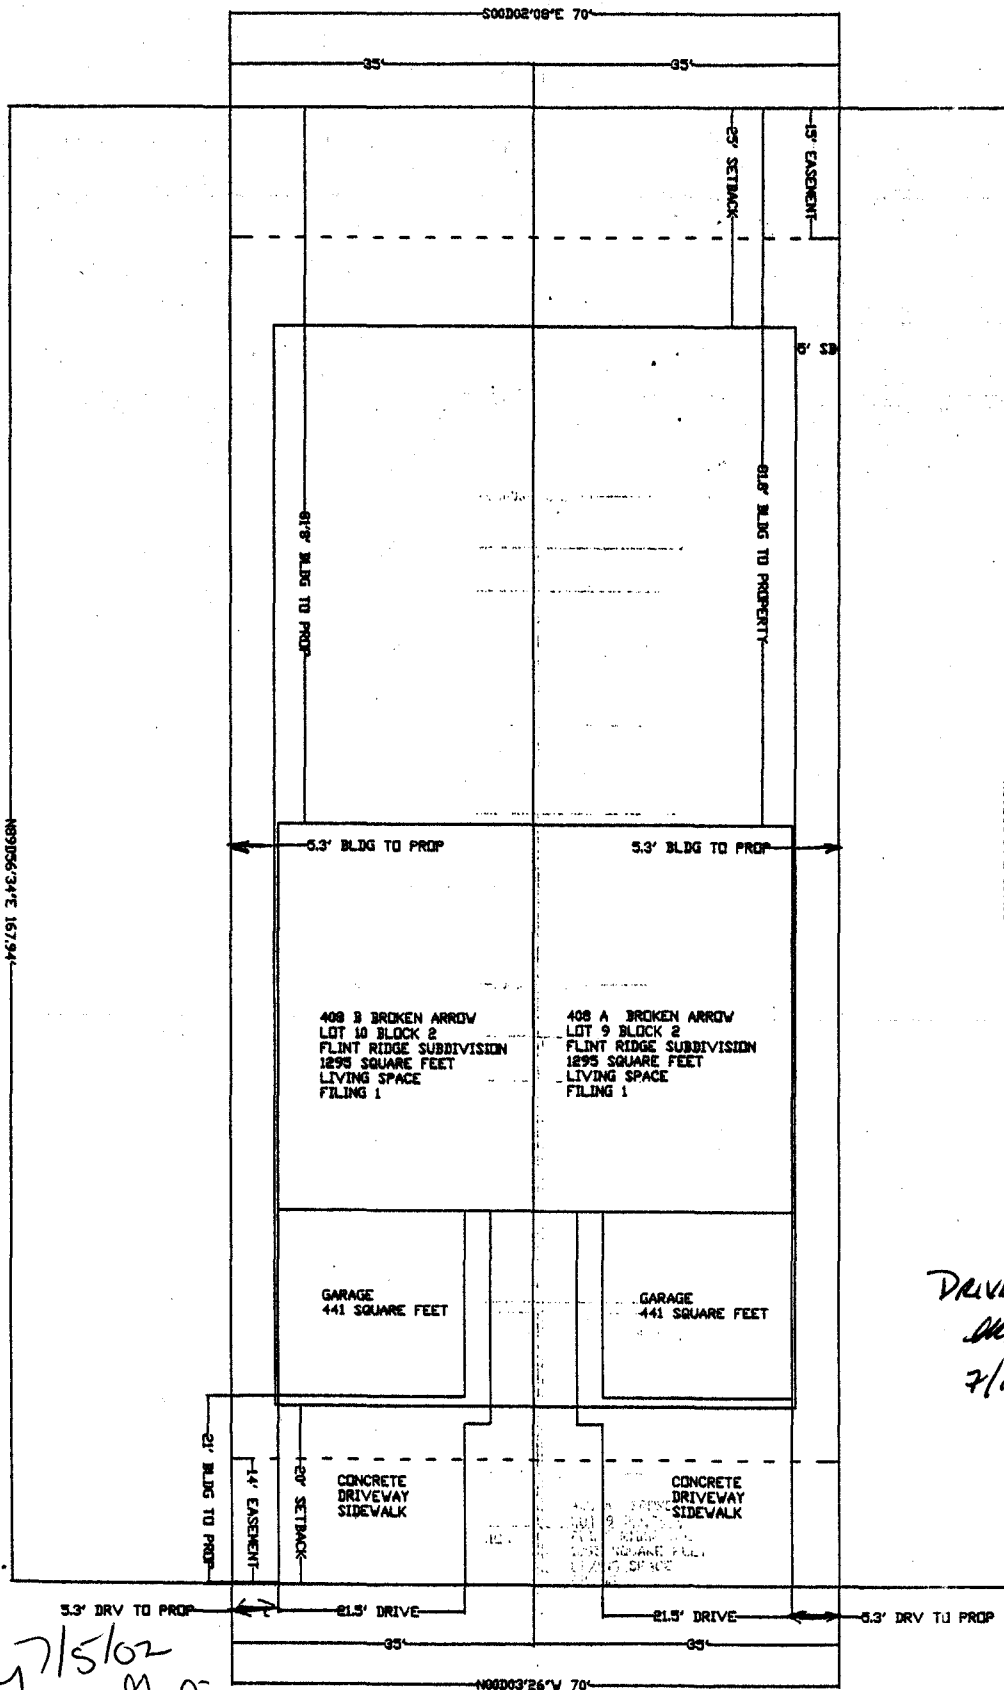

DRIVE OK  
 7/1/02

7/5/02  
 ACCEPTED *C. Jane Gibson*  
 ANY CHANGE OF SETBACKS MUST BE APPROVED BY THE CITY PLANNING DEPT. IT IS THE APPLICANT'S RESPONSIBILITY TO PROPERLY LOCATE AND IDENTIFY EASEMENTS AND PROPERTY LINES

(A)

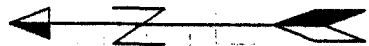

BROKEN ARROW