

FEE \$	10.00
TCP \$	0
SIF \$	292.00

PLANNING CLEARANCE
 (Single Family Residential and Accessory Structures)
Community Development Department

BLDG PERMIT NO. 83579



Your Bridge to a Better Community

BLDG ADDRESS 2973 Brookside SQ. FT. OF PROPOSED BLDGS/ADDITION 1312
 TAX SCHEDULE NO. 2943-051-07-002 SQ. FT. OF EXISTING BLDGS 0
 SUBDIVISION Brookside 2 TOTAL SQ. FT. OF EXISTING & PROPOSED 1767 w/ garage
 FILING 2 BLK 2 LOT 2 NO. OF DWELLING UNITS:
 Before: 0 After: 1 this Construction
 NO. OF BUILDINGS ON PARCEL
 Before: 0 After: 1 this Construction
 (1) OWNER Darter LLC USE OF EXISTING BUILDINGS NA
 (1) ADDRESS 786 Valley Ct DESCRIPTION OF WORK & INTENDED USE New Home
 (1) TELEPHONE 523-5555 TYPE OF HOME PROPOSED:
 Site Built Manufactured Home (UBC)
 Manufactured Home (HUD)
 Other (please specify) _____
 (2) APPLICANT Grace Homes Const
 (2) ADDRESS 786 Valley Ct
 (2) TELEPHONE 523-5555

REQUIRED: One plot plan, on 8 1/2" x 11" paper, showing all existing & proposed structure location(s), parking, setbacks to all property lines, ingress/egress to the property, driveway location & width & all easements & rights-of-way which abut the parcel.

THIS SECTION TO BE COMPLETED BY COMMUNITY DEVELOPMENT DEPARTMENT STAFF

ZONE PD Maximum coverage of lot by structures 3590
 SETBACKS: Front 20' from property line (PL) Permanent Foundation Required: YES NO
 or _____ from center of ROW, whichever is greater
 Side 5' from PL, Rear 20' from PL Parking Req'mt 2
 Maximum Height 32' Special Conditions _____
 CENSUS 11 TRAFFIC 45 ANN# _____

Modifications to this Planning Clearance must be approved, in writing, by the Community Development Department. The structure authorized by this application cannot be occupied until a final inspection has been completed and a Certificate of Occupancy has been issued, if applicable, by the Building Department (Section 305, Uniform Building Code).

I hereby acknowledge that I have read this application and the information is correct; I agree to comply with any and all codes, ordinances, laws, regulations or restrictions which apply to the project. I understand that failure to comply shall result in legal action, which may include but not necessarily be limited to non-use of the building(s).

Applicant Signature [Signature] Date 2/27/02
 Department Approval [Signature] Date 4/18/02

Additional water and/or sewer tap fee(s) are required: <input checked="" type="checkbox"/> YES <input type="checkbox"/> NO	W/O No. <u>14768</u>
Utility Accounting <u>[Signature]</u>	Date <u>4/18/02</u>

VALID FOR SIX MONTHS FROM DATE OF ISSUANCE (Section 2.2.C.1.c(1) Grand Junction Zoning & Development Code)

(White: Planning) (Yellow: Customer) (Pink: Building Department) (Goldenrod: Utility Accounting)


BROOKSIDE DRIVE

2973

71.00'


4/15/02
ACCEPTED *Cheryl Brown*
ANY CHANGE OF SETBACKS MUST BE APPROVED BY THE CITY PLANNING DEPT. IT IS THE APPLICANT'S RESPONSIBILITY TO PROPERLY LOCATE AND IDENTIFY EASEMENTS AND PROPERTY LINES

David Smith
Trust
RIGHT-OF-WAY

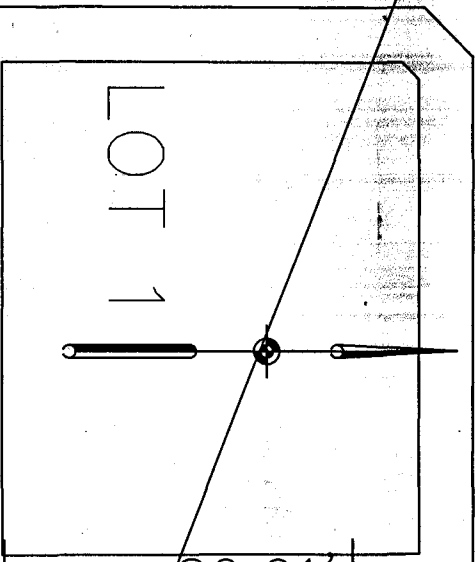

SCALE: 1 INCH = 20 FEET

LOT 1

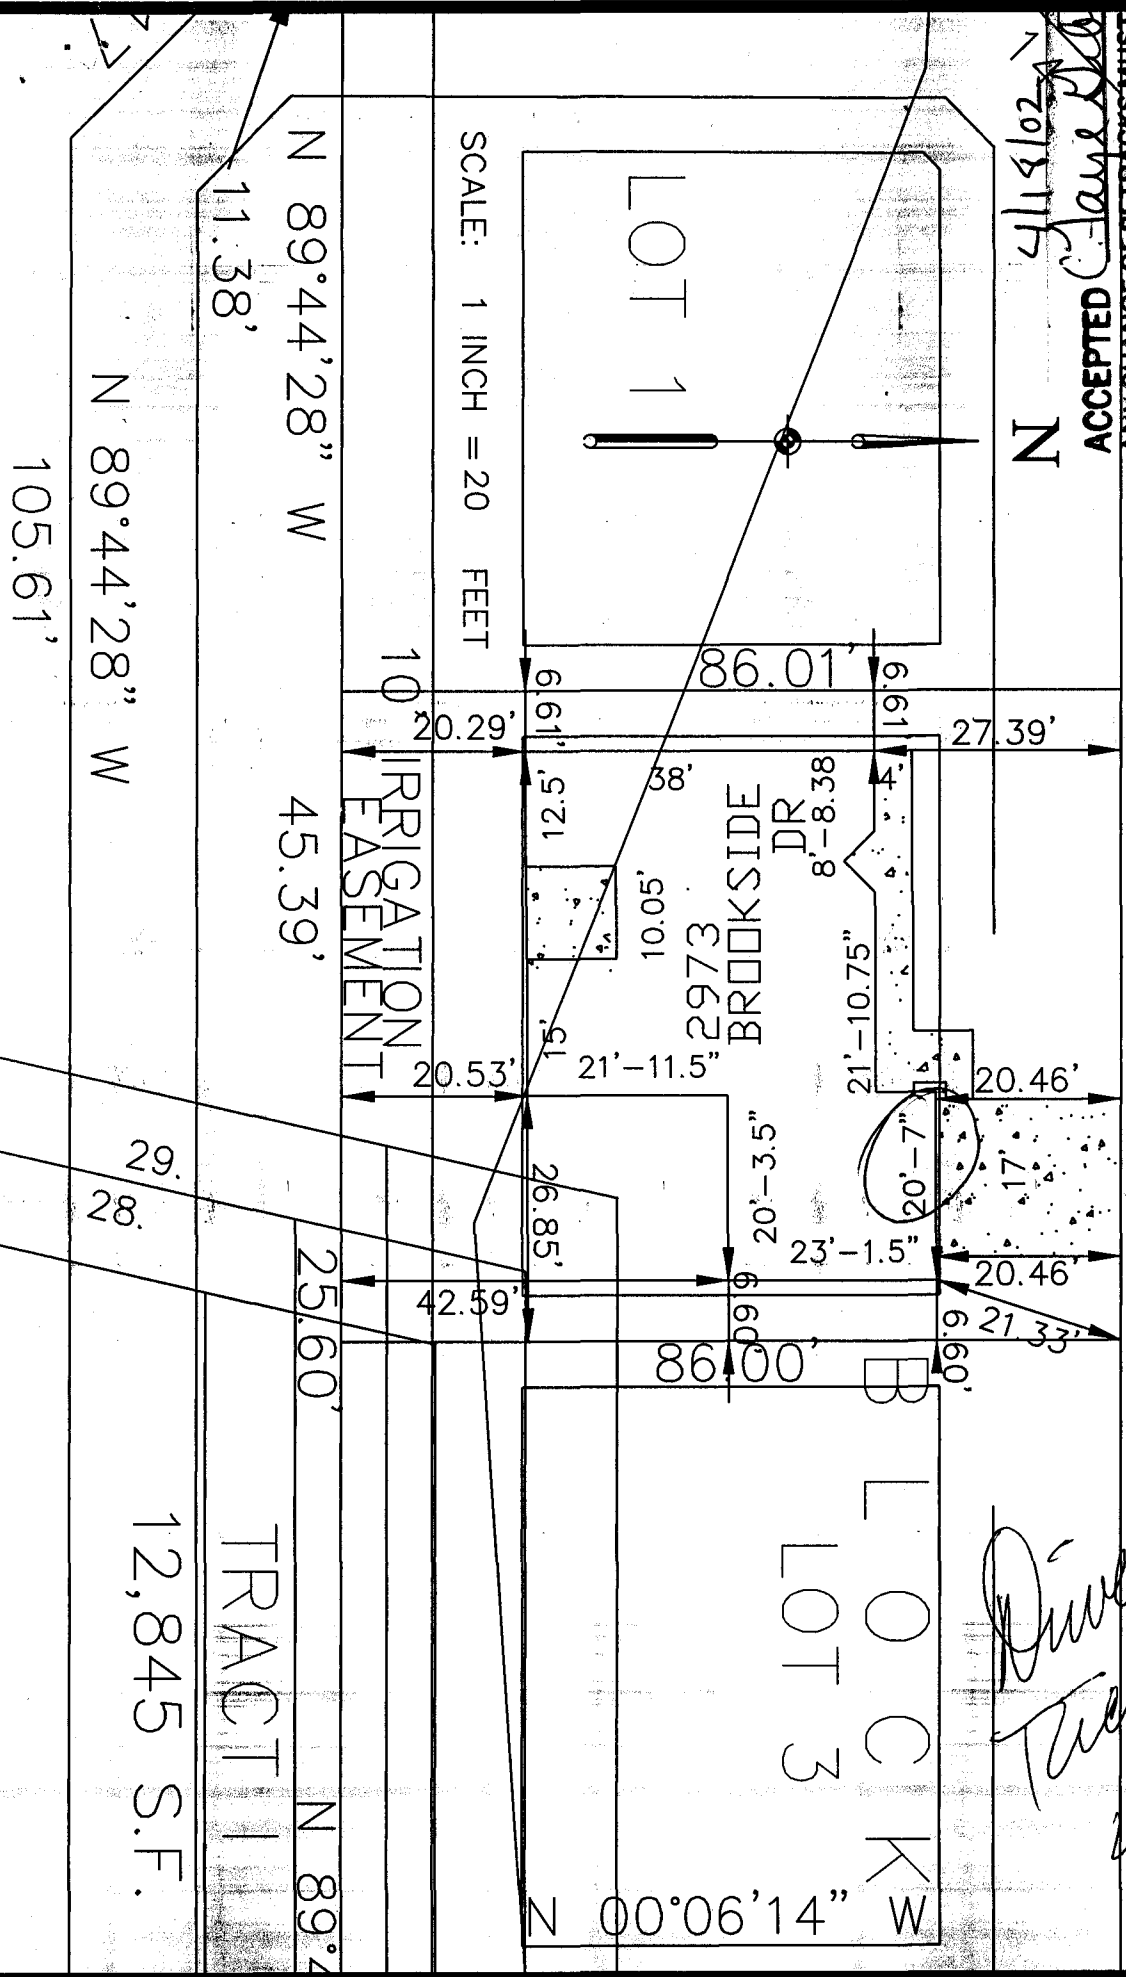

10' IRRIGATION EASEMENT

BROOKSIDE DR

BLOCK 3

TRACT 1

12,845 S.F.

105.61'

N 89°44'28\" W

N 89°44'28\" W

45.39'

25.60'

N 89°44'28\" W

N 00°06'14\" W

29.
28.

86.00'

86.01'

50.01'

2973

20'-3.5\"

23'-1.5\"

57'-10.75\"

20'-7\"

6.60'

20.46'

21.33'

6.60'

20.46'

20.46'

27.39'

6.61'

6.61'

20.29'

20.29'

6.61'

6.61'

