

FEE \$	10.00
TCP \$	0
SIF \$	292.00

PLANNING CLEARANCE
(Single Family Residential and Accessory Structures)
Community Development Department

BLDG PERMIT NO. 84169



Your Bridge to a Better Community

BLDG ADDRESS 339 Canyon Rim CT SQ. FT. OF PROPOSED BLDGS/ADDITION 2130
 TAX SCHEDULE NO. 214-192-10-001 - parent parcel SQ. FT. OF EXISTING BLDGS 0
 SUBDIVISION Canyon Rim TOTAL SQ. FT. OF EXISTING & PROPOSED 2130
 FILING 1 BLK 2 LOT 12 NO. OF DWELLING UNITS:
 Before: 0 After: 1 this Construction
 (1) OWNER DAVID BAILE NO. OF BUILDINGS ON PARCEL
 Before: 0 After: 1 this Construction
 (1) ADDRESS 2141 Redcliff Cir USE OF EXISTING BUILDINGS New Res
 (1) TELEPHONE 234-2222 DESCRIPTION OF WORK & INTENDED USE New Res
 (2) APPLICANT Same TYPE OF HOME PROPOSED: PATH
 (2) ADDRESS _____ Site Built APP-08 Manufactured Home (MHC)
 (2) TELEPHONE _____ Manufactured Home (HUD)
 Other (please specify) TB

REQUIRED: One plot plan, on 8 1/2" x 11" paper, showing all existing & proposed structure location(s), parking, setbacks to all property lines, ingress/egress to the property, driveway location & width & all easements & rights-of-way which abut the parcel.

THIS SECTION TO BE COMPLETED BY COMMUNITY DEVELOPMENT DEPARTMENT STAFF

ZONE RSF-2 Maximum coverage of lot by structures 30%
 SETBACKS: Front 20' from property line (PL) Permanent Foundation Required: YES X NO _____
 or _____ from center of ROW, whichever is greater
 Side 15' from PL, Rear 30' from PL Parking Req'mt 2
 Maximum Height 35' Special Conditions _____
 CENSUS 1407 TRAFFIC 63 ANNEX# _____

Modifications to this Planning Clearance must be approved, in writing, by the Community Development Department. The structure authorized by this application cannot be occupied until a final inspection has been completed and a Certificate of Occupancy has been issued, if applicable, by the Building Department (Section 305, Uniform Building Code).

I hereby acknowledge that I have read this application and the information is correct; I agree to comply with any and all codes, ordinances, laws, regulations or restrictions which apply to the project. I understand that failure to comply shall result in legal action, which may include but not necessarily be limited to non-use of the building(s).

Applicant Signature [Signature] Date 4-5-02
 Department Approval [Signature] Date 4/8/02


Additional water and/or sewer tap fee(s) are required:	YES <input checked="" type="checkbox"/>	NO <input type="checkbox"/>	W/O No. <u>14737</u>
Utility Accounting	<u>[Signature]</u>	Date	<u>4/8/02</u>

VALID FOR SIX MONTHS FROM DATE OF ISSUANCE (Section 2.2.C.1.c(1) Grand Junction Zoning & Development Code)

(White: Planning) (Yellow: Customer) (Pink: Building Department) (Goldenrod: Utility Accounting)

NOTICE
1. IT IS THE RESPONSIBILITY OF THE BUILDER OR OWNER TO VERIFY DETAILS
AND DIMENSIONS FROM THE CONSTRUCTION.

ACCEPTED *Cy 4/8/02*
ANY CHANGE OF SETBACKS MUST BE
APPROVED BY THE CITY PLANNING
DEPT. IT IS THE APPLICANT'S
RESPONSIBILITY TO PROPERLY
LOCATE AND IDENTIFY EASEMENTS
AND PROPERTY LINES.

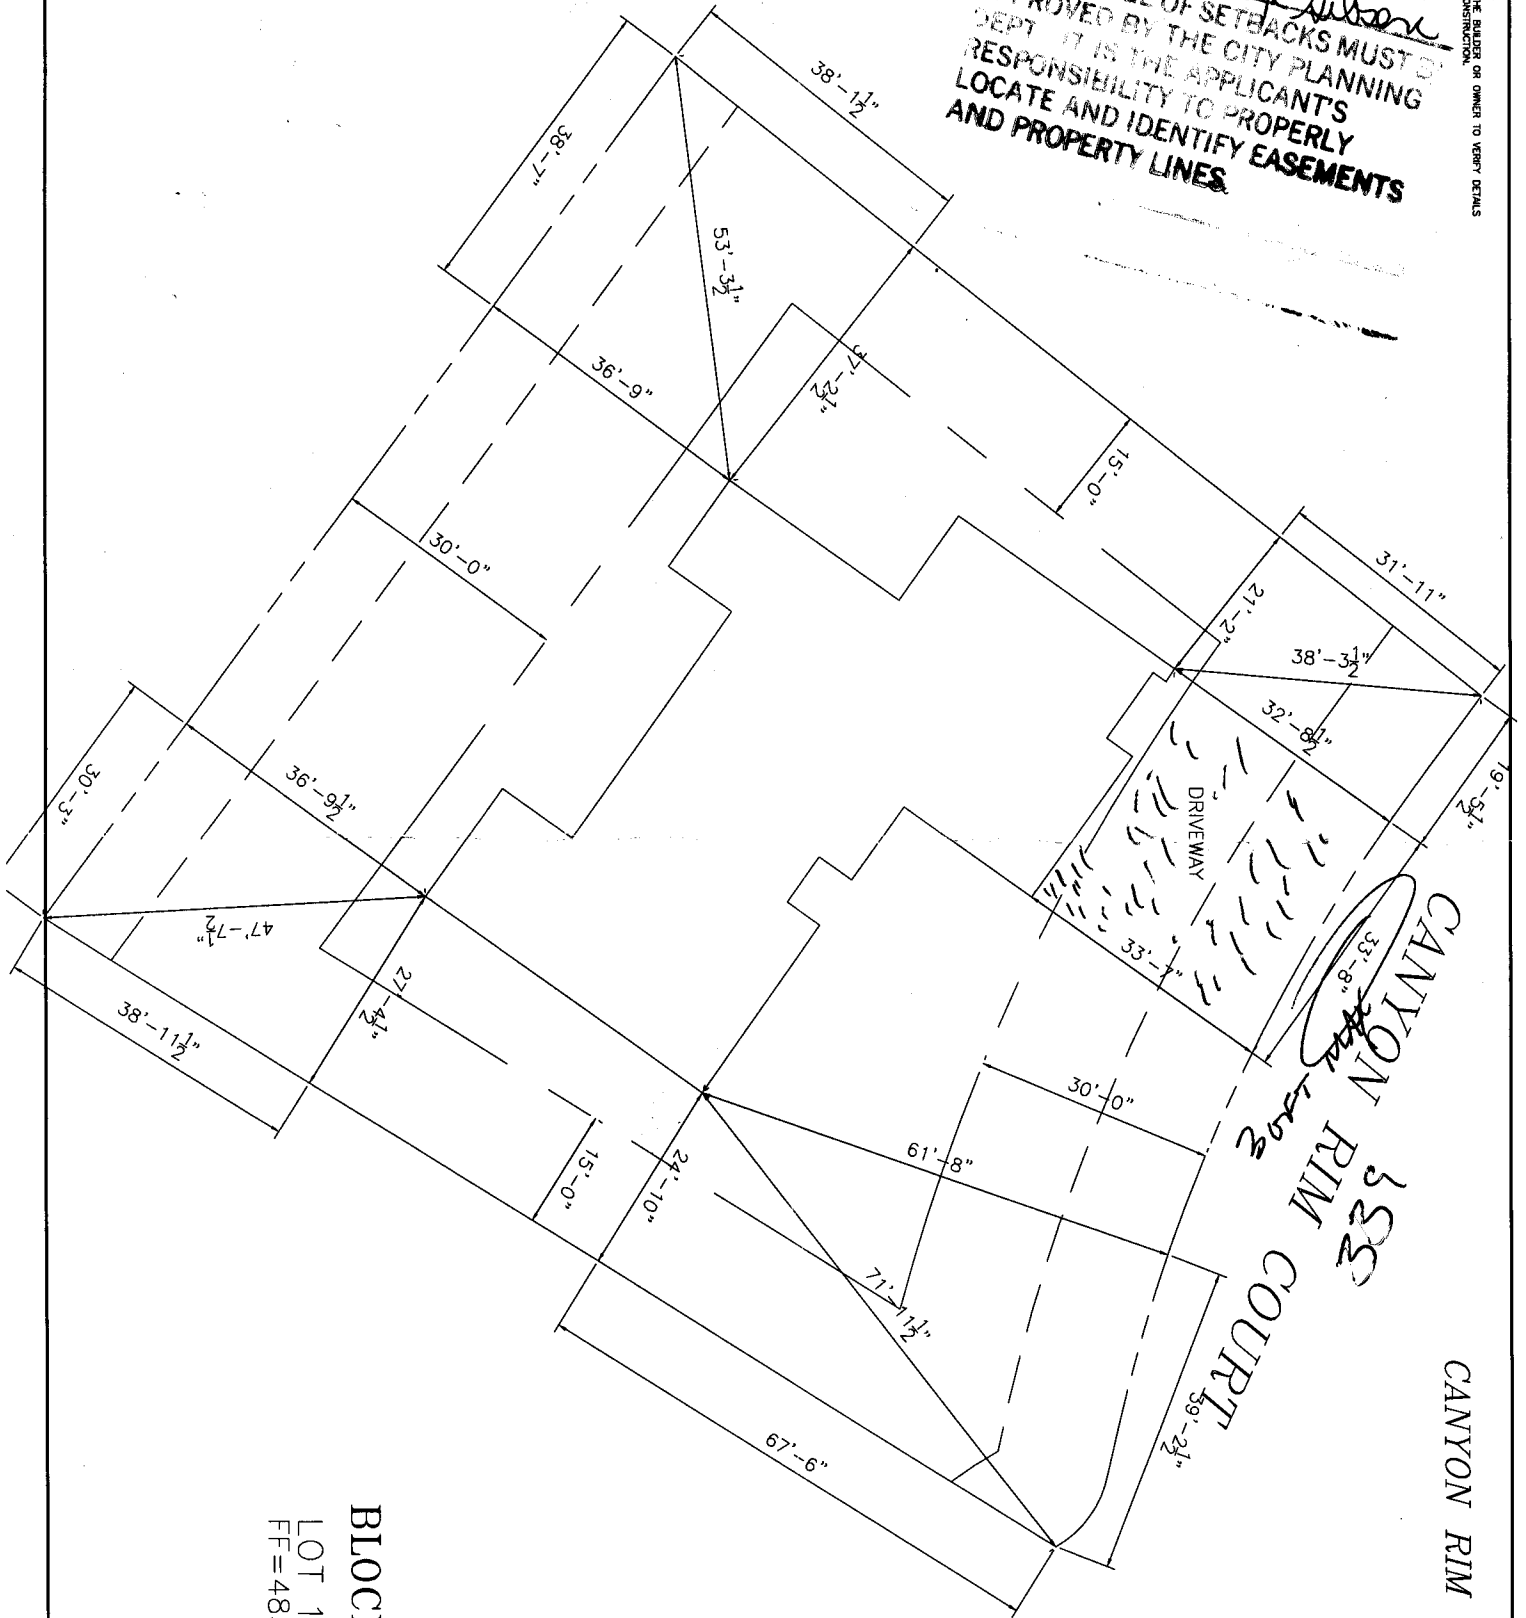

BLOCK 2
LOT 12
FF=4839

CANYON RIM FILING 1

CANYON RIM COURT
633
33'-8"
4492