

FEE \$	10.00
TCP \$	0
SIF \$	292.00

**PLANNING CLEARANCE**  
 (Single Family Residential and Accessory Structures)  
**Community Development Department**

BLDG PERMIT NO. 85477



Your Bridge to a Better Community

BLDG ADDRESS 349 Canyon Rim Ct SQ. FT. OF PROPOSED BLDGS/ADDITION 2875  
 TAX SCHEDULE NO. 2945-192-10-001 SQ. FT. OF EXISTING BLDGS —  
 SUBDIVISION Canyon Rim TOTAL SQ. FT. OF EXISTING & PROPOSED 2875  
 FILING 1 BLK 2 LOT 7 NO. OF DWELLING UNITS:  
 Before: 0 After: 1 this Construction  
 (1) OWNER Bennett Construction NO. OF BUILDINGS ON PARCEL  
 Before: 0 After: 1 this Construction  
 (1) ADDRESS 2017 Rosette Ct USE OF EXISTING BUILDINGS —  
 (1) TELEPHONE 241-0795 DESCRIPTION OF WORK & INTENDED USE New Home  
 (2) APPLICANT John Bennett TYPE OF HOME PROPOSED:  
 (2) ADDRESS 2017 Rosette Ct  Site Built  Manufactured Home (UBC)  
 (2) TELEPHONE 234-0808  Manufactured Home (HUD)  
 Other (please specify) \_\_\_\_\_

**REQUIRED: One plot plan, on 8 1/2" x 11" paper, showing all existing & proposed structure location(s), parking, setbacks to all property lines, ingress/egress to the property, driveway location & width & all easements & rights-of-way which abut the parcel.**

**THIS SECTION TO BE COMPLETED BY COMMUNITY DEVELOPMENT DEPARTMENT STAFF**

ZONE RSF-2 Maximum coverage of lot by structures 30%  
 SETBACKS: Front 20' from property line (PL) Permanent Foundation Required: YES  NO   
 or \_\_\_\_\_ from center of ROW, whichever is greater  
 Side 15' from PL, Rear 30' from PL Parking Req'mt 2  
 Maximum Height 35' Special Conditions Acco required  
 CENSUS 1401 TRAFFIC 63 ANN# \_\_\_\_\_

Modifications to this Planning Clearance must be approved, in writing, by the Community Development Department. The structure authorized by this application cannot be occupied until a final inspection has been completed and a Certificate of Occupancy has been issued, if applicable, by the Building Department (Section 305, Uniform Building Code).

I hereby acknowledge that I have read this application and the information is correct; I agree to comply with any and all codes, ordinances, laws, regulations or restrictions which apply to the project. I understand that failure to comply shall result in legal action, which may include but not necessarily be limited to non-use of the building(s).

Applicant Signature John Bennett Date 7-17-02  
 Department Approval Blk Gaylen Henderson Date 8-21-02

Additional water and/or sewer tap fee(s) are required:	YES <input checked="" type="checkbox"/>	NO <input type="checkbox"/>	W/O No. <u>15224</u>
Utility Accounting	<u>CM Cole</u>	Date	<u>8/21/02</u>

VALID FOR SIX MONTHS FROM DATE OF ISSUANCE (Section 9-3-2C Grand Junction Zoning & Development Code)  
 (White: Planning) (Yellow: Customer) (Pink: Building Department) (Goldenrod: Utility Accounting)

8-21-02


ACCEPTED *Gayleen Henderson*

ANY CHANGE OF SETBACKS MUST BE APPROVED BY THE CITY PLANNING DEPT. IT IS THE APPLICANT'S RESPONSIBILITY TO PROPERLY LOCATE AND IDENTIFY EASEMENTS AND PROPERTY LINES.

CANYON RIM  
BLOCK 2

LOT 7  
FF=4835

5'-0" MIN

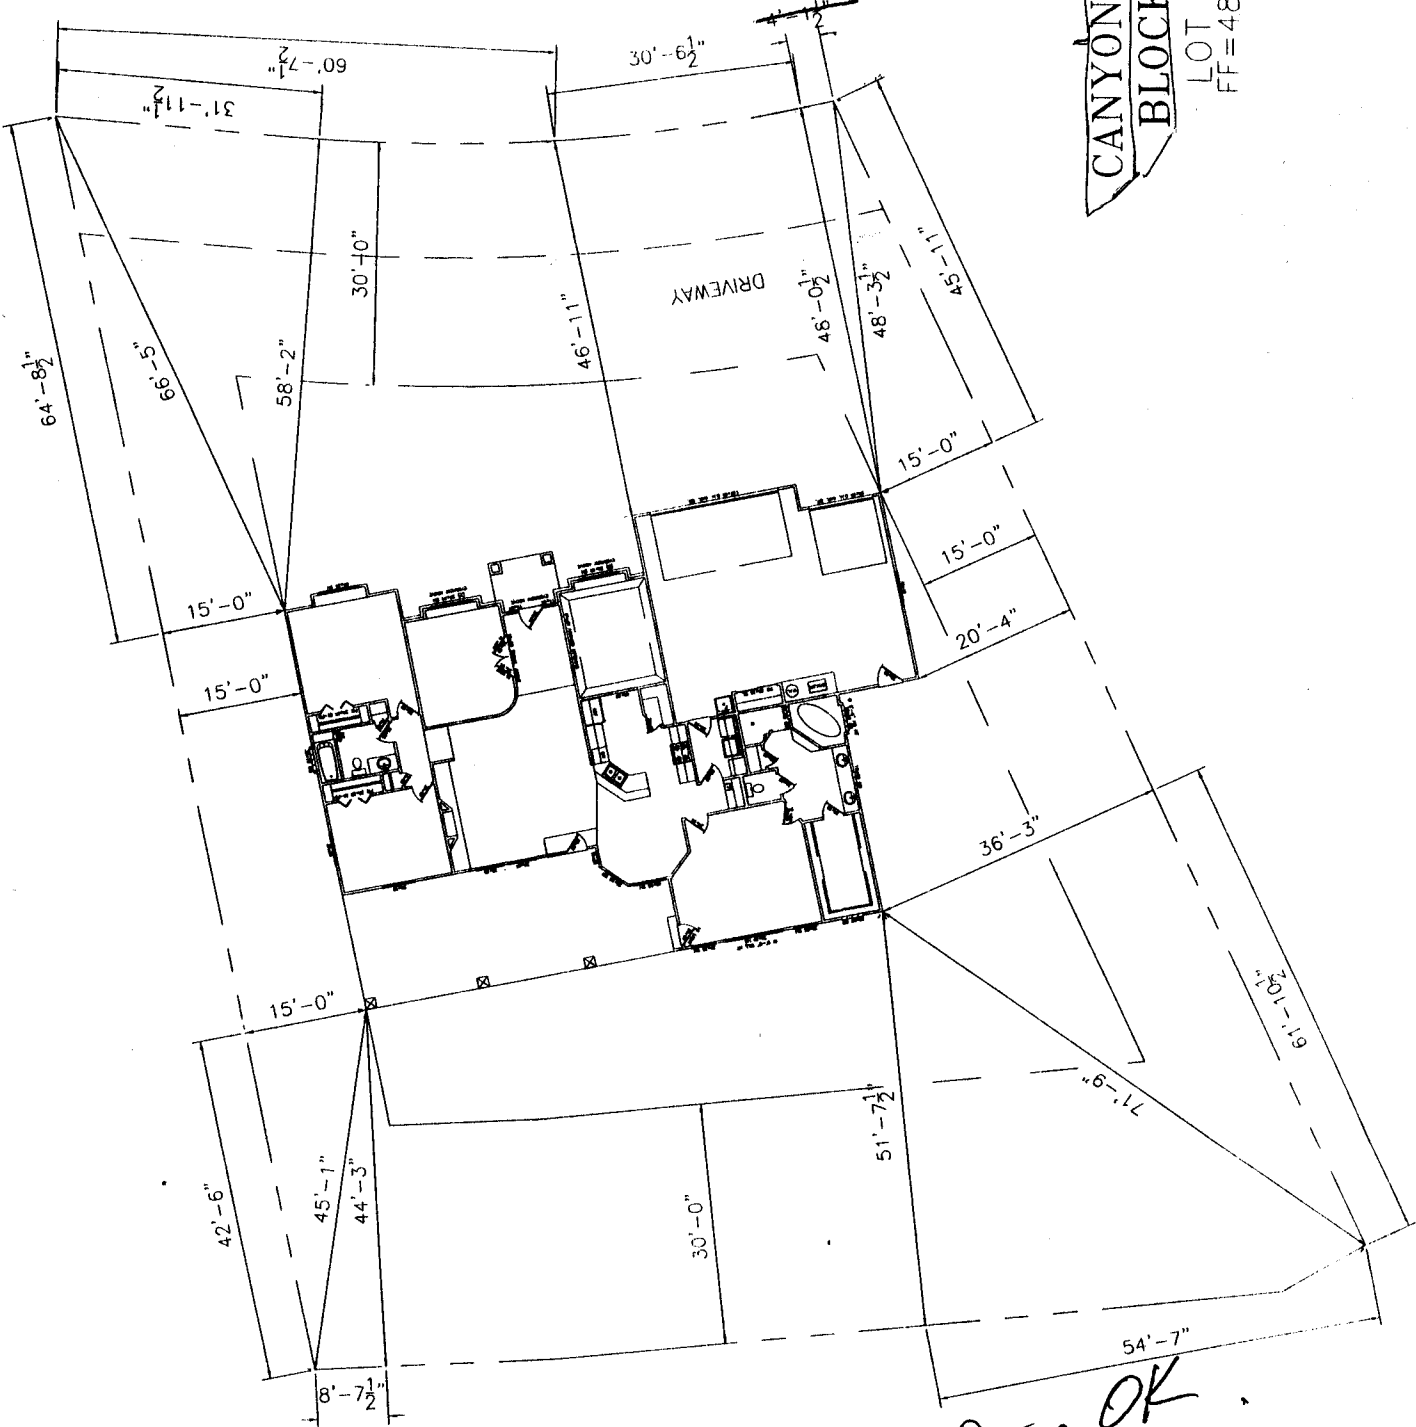

*Done OK  
Tate Powers  
7-18-02*

SEE: THE RESPONSIBILITY OF THE BUILDER OR OWNER TO VERIFY DETAILS AND DIMENSIONS PRIOR TO CONSTRUCTION.