

FEE \$	10.00
TCP \$	158.50
SIF \$	292.00

PLANNING CLEARANCE
 (Single Family Residential and Accessory Structures)
Community Development Department

BLDG PERMIT NO. 83105



Your Bridge to a Better Community

BLDG ADDRESS 710 Eider CT A SQ. FT. OF PROPOSED BLDGS/ADDITION 1672

TAX SCHEDULE NO. 2701-334-32-019 SQ. FT. OF EXISTING BLDGS -0-

SUBDIVISION Fountain Greens TOTAL SQ. FT. OF EXISTING & PROPOSED 1672

FILING 1 BLK 2 LOT 3A NO. OF DWELLING UNITS:
 Before: 0 After: 1 this Construction

(1) OWNER Just Companies NO. OF BUILDINGS ON PARCEL
 Before: 0 After: 1 this Construction

(1) ADDRESS 826 2 1/2 Rd USE OF EXISTING BUILDINGS Residence

(1) TELEPHONE 245-9316 DESCRIPTION OF WORK & INTENDED USE ↓

(2) APPLICANT _____ TYPE OF HOME PROPOSED:
 Site Built _____ Manufactured Home (UBC)
 _____ Manufactured Home (HUD)
 _____ Other (please specify) _____

(2) ADDRESS _____

(2) TELEPHONE _____

REQUIRED: One plot plan, on 8 1/2" x 11" paper, showing all existing & proposed structure location(s), parking, setbacks to all property lines, ingress/egress to the property, driveway location & width & all easements & rights-of-way which abut the parcel.

THIS SECTION TO BE COMPLETED BY COMMUNITY DEVELOPMENT DEPARTMENT STAFF

ZONE PD Maximum coverage of lot by structures 4570

SETBACKS: Front 20' from property line (PL) Permanent Foundation Required: YES NO _____
 or _____ from center of ROW, whichever is greater

Side 0'5' from PL, Rear 10' from PL Parking Req'mt 2

Maximum Height 32' Special Conditions _____

CENSUS 9 TRAFFIC 4 ANN# _____

Modifications to this Planning Clearance must be approved, in writing, by the Community Development Department. The structure authorized by this application cannot be occupied until a final inspection has been completed and a Certificate of Occupancy has been issued, if applicable, by the Building Department (Section 305, Uniform Building Code).

I hereby acknowledge that I have read this application and the information is correct; I agree to comply with any and all codes, ordinances, laws, regulations or restrictions which apply to the project. I understand that failure to comply shall result in legal action, which may include but not necessarily be limited to non-use of the building(s).

Applicant Signature [Signature] Date 2/4/02

Department Approval [Signature] Date 2/11/02


Additional water and/or sewer tap fee(s) are required:	YES <input checked="" type="checkbox"/>	NO	W/O No. <u>14570</u>
Utility Accounting	<u>[Signature]</u>	Date	<u>2-11-02</u>

VALID FOR SIX MONTHS FROM DATE OF ISSUANCE (Section 9-3-2C Grand Junction Zoning & Development Code)

(White: Planning) (Yellow: Customer) (Pink: Building Department) (Goldenrod: Utility Accounting)



10' Setback

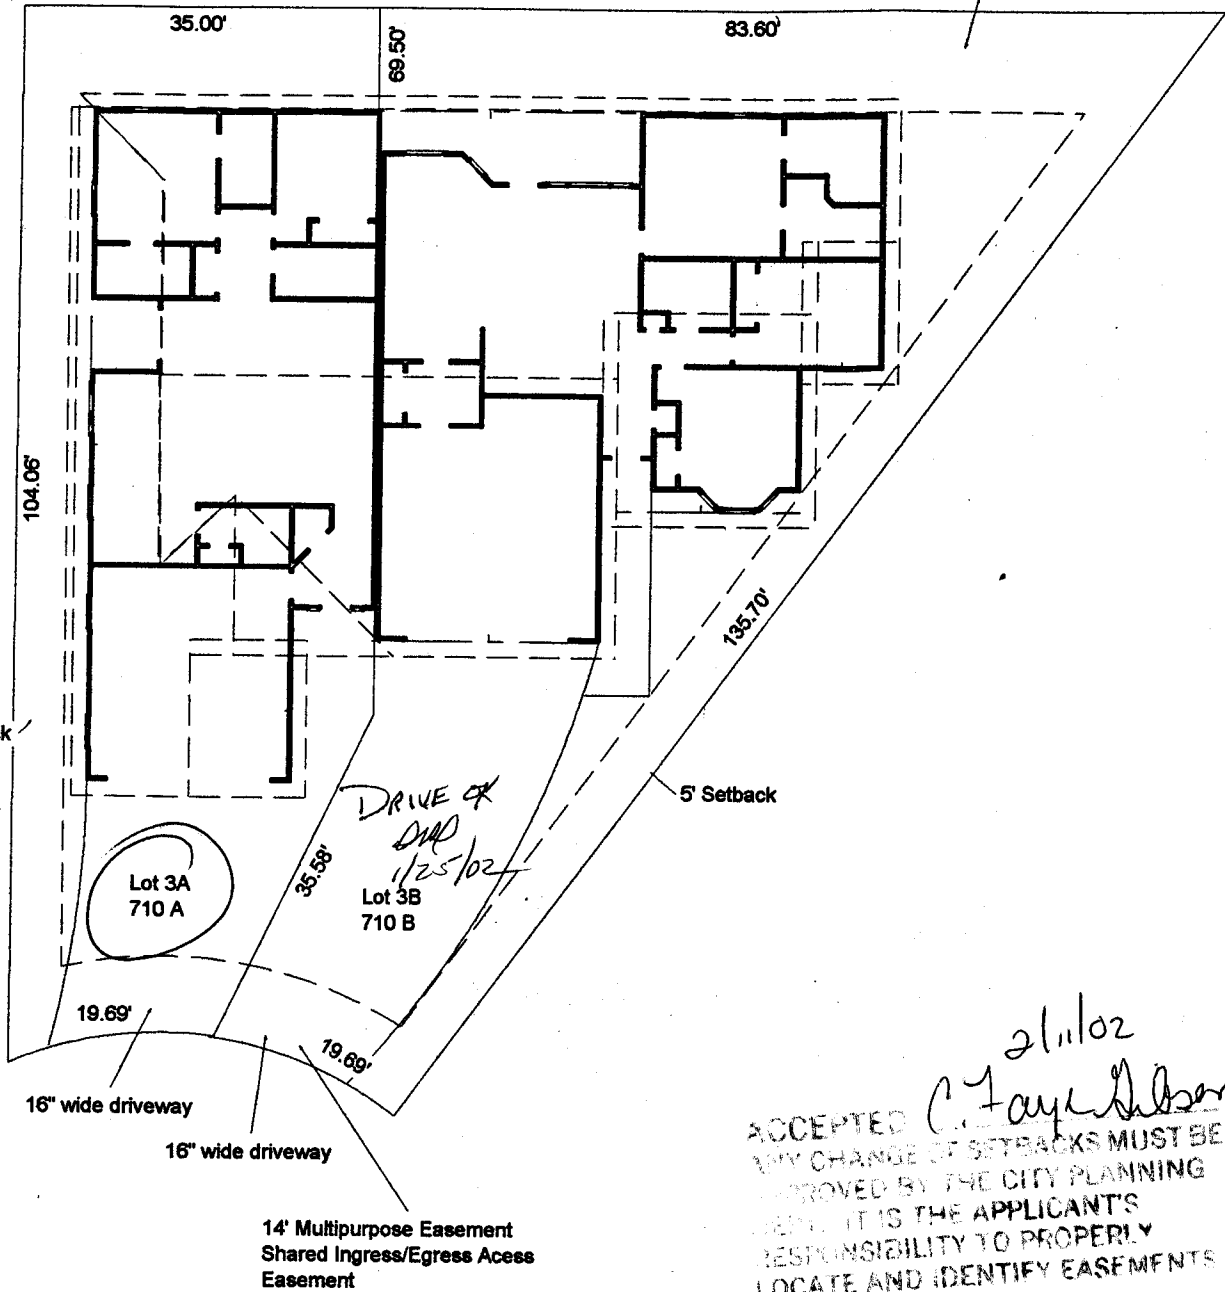

ACCEPTED *C. Taylor* 2/1/02
 ANY CHANGE OF SETBACKS MUST BE APPROVED BY THE CITY PLANNING DEPT. IT IS THE APPLICANT'S RESPONSIBILITY TO PROPERLY LOCATE AND IDENTIFY EASEMENTS AND PROPERTY LINES

Eider Court