

FEE \$	10.00
TCP \$	292.00
SIF \$	500.00

**PLANNING CLEARANCE**  
 (Single Family Residential and Accessory Structures)  
**Community Development Department**

BLDG PERMIT NO. 86873



Your Bridge to a Better Community

BLDG ADDRESS 3005 Grand Meadows Ave SQ. FT. OF PROPOSED BLDGS/ADDITION 1312 garage 455  
 TAX SCHEDULE NO. 2943-162-00-022 SQ. FT. OF EXISTING BLDGS \_\_\_\_\_  
 SUBDIVISION Grand Meadows TOTAL SQ. FT. OF EXISTING & PROPOSED \_\_\_\_\_  
 FILING 1 BLK 1 LOT 3 NO. OF DWELLING UNITS:  
 Before: 0 After: 1 this Construction  
 (1) OWNER Darter, LLC NO. OF BUILDINGS ON PARCEL  
 Before: 0 After: 1 this Construction  
 (1) ADDRESS 786 Valleyct USE OF EXISTING BUILDINGS \_\_\_\_\_  
 (1) TELEPHONE 523-5555 DESCRIPTION OF WORK & INTENDED USE \_\_\_\_\_  
 (2) APPLICANT Grace Homes TYPE OF HOME PROPOSED:  
 (2) ADDRESS 786 Valleyct  Site Built \_\_\_\_\_ Manufactured Home (UBC)  
 (2) TELEPHONE 523-5555 \_\_\_\_\_ Manufactured Home (HUD)  
 \_\_\_\_\_ Other (please specify) \_\_\_\_\_

DATE  
OCT 28 2002  
TB

**REQUIRED: One plot plan, on 8 1/2" x 11" paper, showing all existing & proposed structure location(s), parking, setbacks to all property lines, ingress/egress to the property, driveway location & width & all easements & rights-of-way which abut the parcel.**

**THIS SECTION TO BE COMPLETED BY COMMUNITY DEVELOPMENT DEPARTMENT STAFF**

ZONE RMF-5 Maximum coverage of lot by structures 60%  
 SETBACKS: Front 20' 1/2" from property line (PL) Permanent Foundation Required: YES  NO \_\_\_\_\_  
 or \_\_\_\_\_ from center of ROW, whichever is greater  
 Side 5' 1/3' from PL, Rear 25' 1/5' from PL Parking Req'mt 2  
 Maximum Height 35' Special Conditions \_\_\_\_\_  
 CENSUS 8 TRAFFIC 57 ANNEX# \_\_\_\_\_

Modifications to this Planning Clearance must be approved, in writing, by the Community Development Department. The structure authorized by this application cannot be occupied until a final inspection has been completed and a Certificate of Occupancy has been issued, if applicable, by the Building Department (Section 305, Uniform Building Code).

I hereby acknowledge that I have read this application and the information is correct; I agree to comply with any and all codes, ordinances, laws, regulations or restrictions which apply to the project. I understand that failure to comply shall result in legal action, which may include but not necessarily be limited to non-use of the building(s).



Applicant Signature Monica Kuta Date 10-24-02  
 Department Approval Dix Gaylen Henderson Date 10-28-02

Additional water and/or sewer tap fee(s) are required:	YES <input checked="" type="checkbox"/>	NO	W/O No. <u>15425</u>
Utility Accounting	<u>U. Bensley</u>	Date	<u>10/28/02</u>

VALID FOR SIX MONTHS FROM DATE OF ISSUANCE (Section 9-3-2C Grand Junction Zoning & Development Code)

(White: Planning) (Yellow: Customer) (Pink: Building Department) (Goldenrod: Utility Accounting)

ole  
ll  
10/24/02

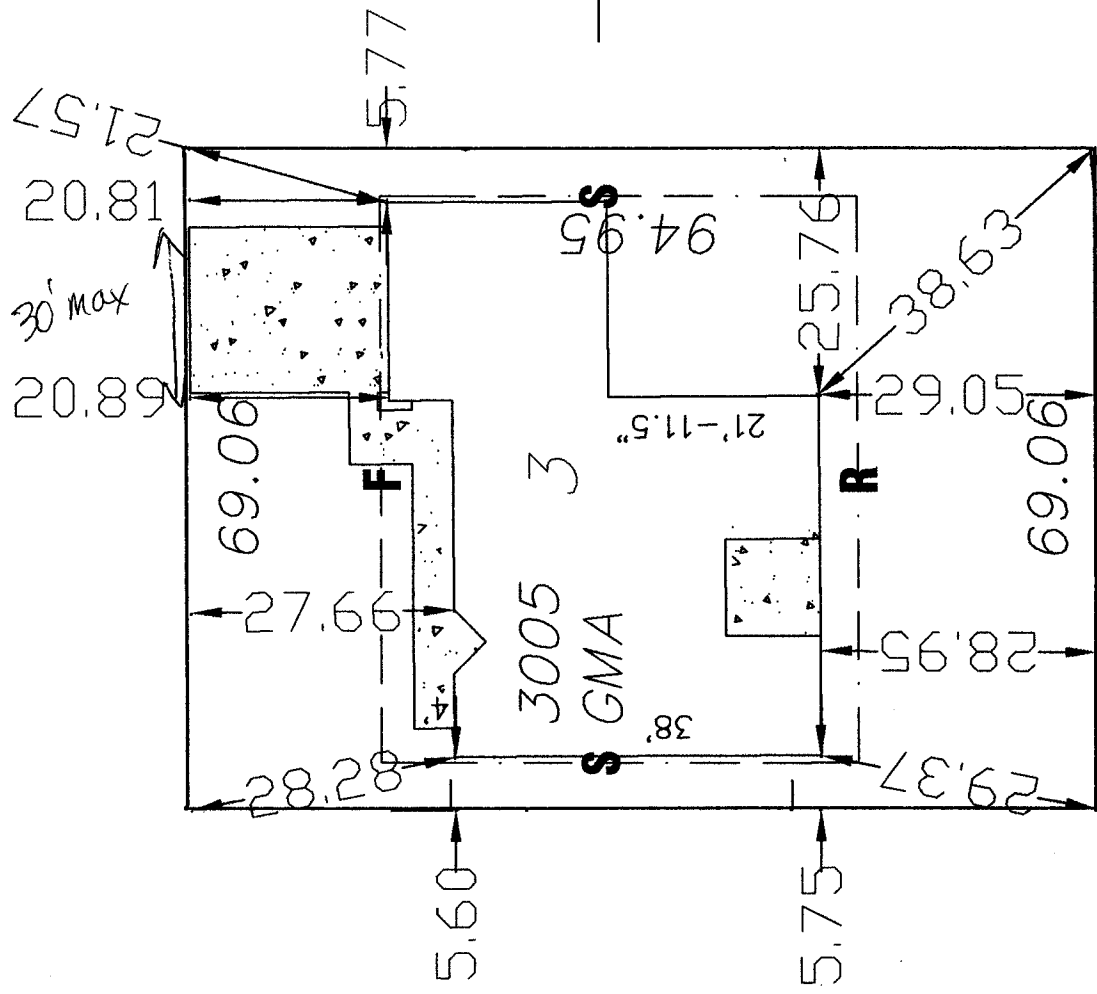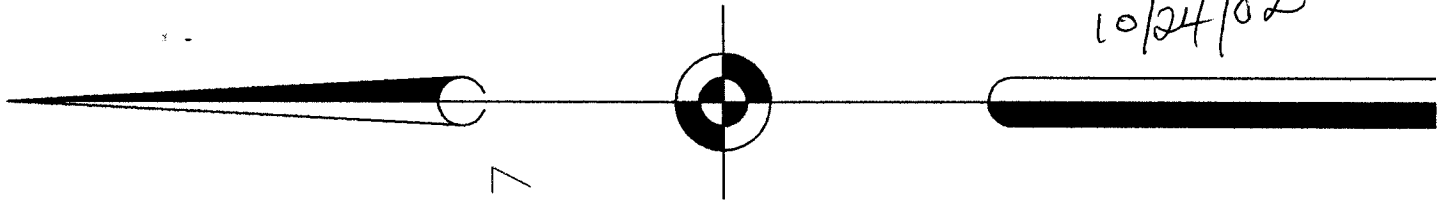

Scale : 1" = 20'  
Lot 3 Block 1

10-28-02 *Gayleen Henderson*

APPLICANTS MUST BE RESPONSIBLE TO PROPERLY LOCATE AND IDENTIFY EASEMENTS AND PROPERTY LINES.