

FEE \$	10.00
TCP \$	500.00
SIF \$	292.00

PLANNING CLEARANCE
 (Single Family Residential and Accessory Structures)
Community Development Department

BLDG PERMIT NO. 86521

ae



Your Bridge to a Better Community

BLDG ADDRESS 3017 Grand Meadows Lane SQ. FT. OF PROPOSED BLDGS/ADDITION 1151 garage 384
 TAX SCHEDULE NO. 2943-162-00-022 SQ. FT. OF EXISTING BLDGS _____
 SUBDIVISION Grand Meadows TOTAL SQ. FT. OF EXISTING & PROPOSED _____
 FILING 1 BLK 1 LOT 10 NO. OF DWELLING UNITS:
 Before: 0 After: 1 this Construction
 (1) OWNER Darter, LLC NO. OF BUILDINGS ON PARCEL
 Before: 0 After: 1 this Construction
 (1) ADDRESS 786 Valley Ct. USE OF EXISTING BUILDINGS _____
 (1) TELEPHONE 523-5555 DESCRIPTION OF WORK & INTENDED USE _____
 (2) APPLICANT Grace Homes TYPE OF HOME PROPOSED:
 (2) ADDRESS 786 Valley Ct. Site Built _____ Manufactured Home (UBC)
 (2) TELEPHONE 523-5555 _____ Manufactured Home (HUD)
 _____ Other (please specify) _____

REQUIRED: One plot plan, on 8 1/2" x 11" paper, showing all existing & proposed structure location(s), parking, setbacks to all property lines, ingress/egress to the property, driveway location & width & all easements & rights-of-way which abut the parcel.

THIS SECTION TO BE COMPLETED BY COMMUNITY DEVELOPMENT DEPARTMENT STAFF

ZONE RMF-5 Maximum coverage of lot by structures 60%
 SETBACKS: Front 20' from property line (PL) Permanent Foundation Required: YES NO _____
 or _____ from center of ROW, whichever is greater
 Side 5' from PL, Rear 25' from PL Parking Req'mt 2
 Maximum Height 35' Special Conditions _____
 CENSUS 8 TRAFFIC 57 ANN# _____

Modifications to this Planning Clearance must be approved, in writing, by the Community Development Department. The structure authorized by this application cannot be occupied until a final inspection has been completed and a Certificate of Occupancy has been issued, if applicable, by the Building Department (Section 305, Uniform Building Code).

I hereby acknowledge that I have read this application and the information is correct; I agree to comply with any and all codes, ordinances, laws, regulations or restrictions which apply to the project. I understand that failure to comply shall result in legal action, which may include but not necessarily be limited to non-use of the building(s).

Applicant Signature Monica Duta Date 10-1-02
 Department Approval G.B. Hayden Henderson Date 10-9-02

Additional water and/or sewer tap fee(s) are required:	YES <input checked="" type="checkbox"/>	NO	W/O No. <u>15381</u>
Utility Accounting	<u>Jay Shope</u>	Date	<u>10/11/02</u>

VALID FOR SIX MONTHS FROM DATE OF ISSUANCE (Section 9-3-2C Grand Junction Zoning & Development Code)

(White: Planning) (Yellow: Customer) (Pink: Building Department) (Goldenrod: Utility Accounting)

14' MULTI-PURPOSE EASEMENT

34.99

81.63

N00°04'

N89°55'09"E 250.62

10-9-02
APPLICANTS
PROPERTY OF CITY OF ANNING
ANY CHANGE OF SETBACKS MUST BE
APPROVED BY THE CITY PLANNING
COMMISSION
DATE: 10-9-02
Gordon K. Brown


VENUE

Handwritten notes:
20' setback
10' setback
10' setback

70.05

69.06 14' MULTI-PURPOSE ESMT

69.06

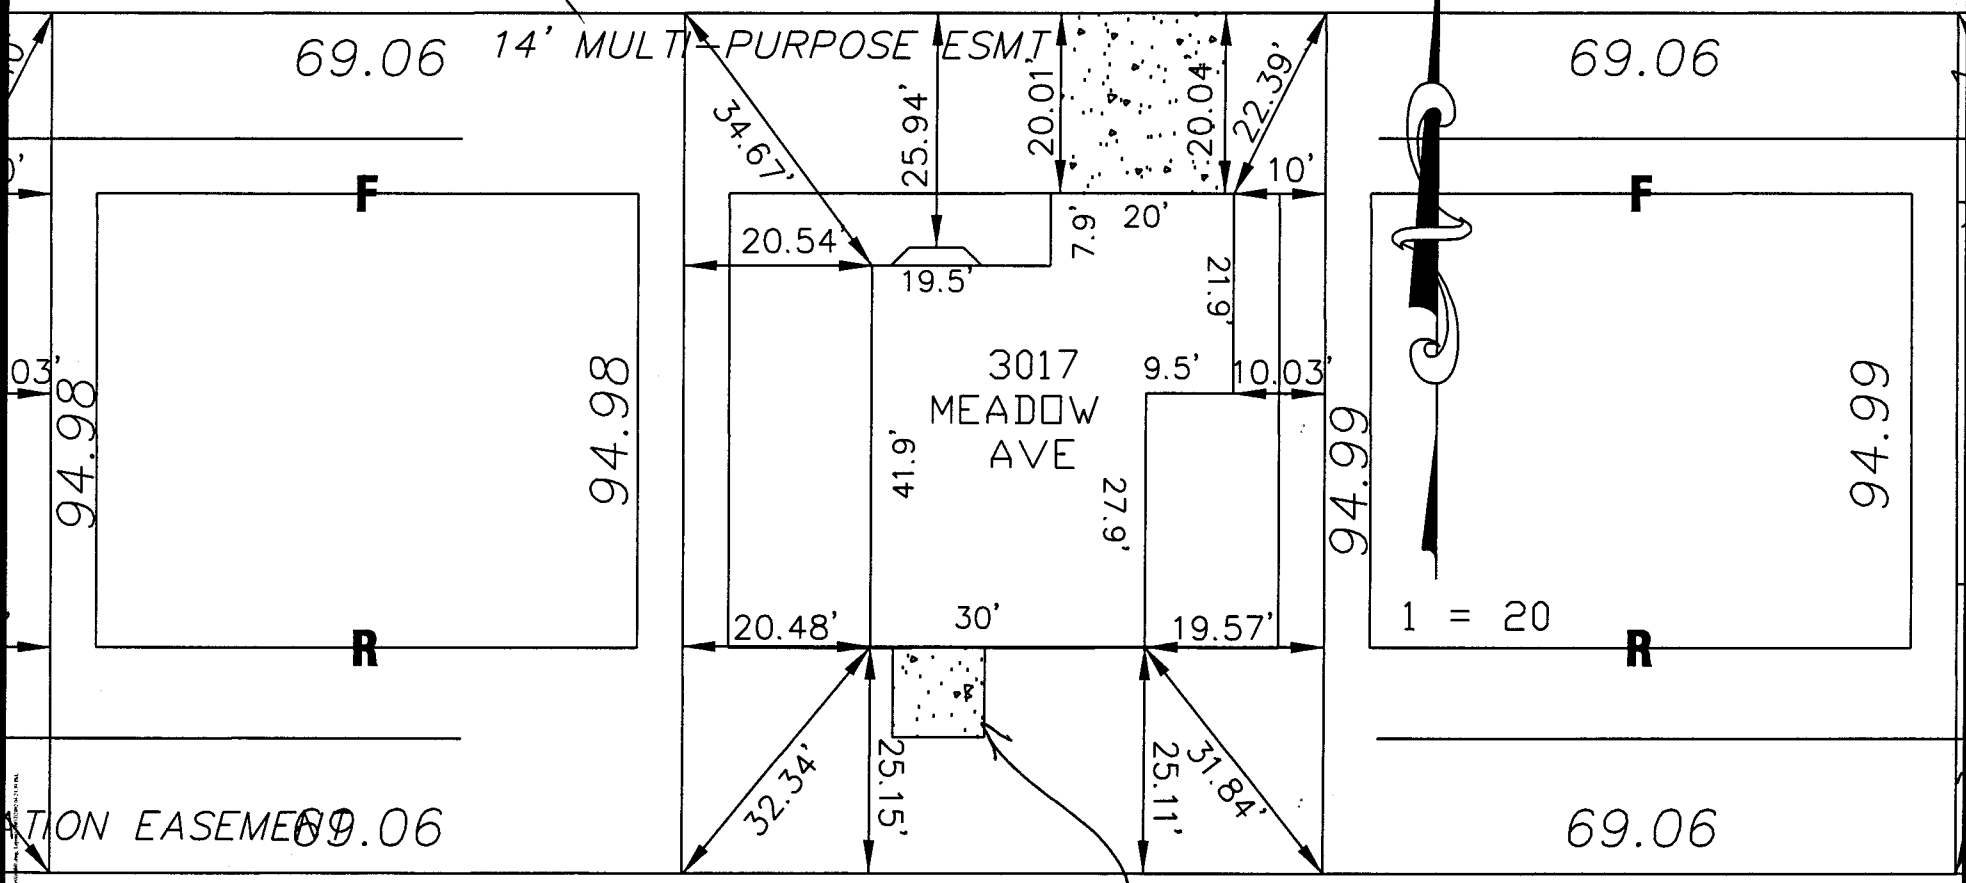

14' MULTI-PURPOSE EASEMENT

69.06

69.06

70.05

Handwritten notes:
20' setback
10' setback
10' setback