

Planning \$ <u>10.00</u>	Drainage \$ <u>0</u>
TCP \$ <u>0</u>	School Impact \$ <u>0</u>

(16)

BLDG PERMIT NO. <u>None</u>
FILE # <u>N/A</u>

PLANNING CLEARANCE

(site plan review, multi-family development, non-residential development)

Grand Junction Community Development Department

56425-31923

THIS SECTION TO BE COMPLETED BY APPLICANT

BUILDING ADDRESS 2980 Gunnison Ave

TAX SCHEDULE NO. 2943-171-07-009

SUBDIVISION Banner Industrial Park

SQ. FT. OF PROPOSED BLDG(S)/ADDITION 400 58^{sq ft}

FILING _____ BLK _____ LOT 9

SQ. FT OF EXISTING BLDG(S) 46 35.75

OWNER Gene Morrill

NO. OF DWELLING UNITS: BEFORE 0 AFTER 0
CONSTRUCTION

ADDRESS 2980 Gunnison ave

NO. OF BLDGS ON PARCEL: BEFORE 1 AFTER 2
CONSTRUCTION

TELEPHONE 241-8259

USE OF ALL EXISTING BLDGS Fab. Shop

APPLICANT Brian Burslund

DESCRIPTION OF WORK & INTENDED USE: add

ADDRESS 2980 Gunnison ave

Storage area

TELEPHONE 241-8259

Submittal requirements are outlined in the SSID (Submittal Standards for Improvements and Development) document.

THIS SECTION TO BE COMPLETED BY COMMUNITY DEVELOPMENT DEPARTMENT STAFF

ZONE I-1

LANDSCAPING/SCREENING REQUIRED: YES _____ NO X

SETBACKS: FRONT: 25' from Property Line (PL) or
from center of ROW, whichever is greater
SIDE: 5' from PL REAR: 10' from PL

PARKING REQUIREMENT: N/A

MAXIMUM HEIGHT 40'

SPECIAL CONDITIONS: _____

MAXIMUM COVERAGE OF LOT BY STRUCTURES N/A

CENSUS TRACT _____ TRAFFIC ZONE _____ ANNEX _____

Modifications to this Planning Clearance must be approved, in writing, by the Community Development Department Director. The structure authorized by this application cannot be occupied until a final inspection has been completed and a Certificate of Occupancy has been issued by the Building Department (Section 307, Uniform Building Code). Required improvements in the public right-of-way must be guaranteed prior to issuance of a Planning Clearance. All other required site improvements must be completed or guaranteed prior to issuance of a Certificate of Occupancy. Any landscaping required by this permit shall be maintained in an acceptable and healthy condition. The replacement of any vegetation materials that die or are in an unhealthy condition is required by the Grand Junction Zoning and Development Code.

Four (4) sets of final construction drawings must be submitted and stamped by City Engineering prior to issuing the Planning Clearance. One stamped set must be available on the job site at all times.

I hereby acknowledge that I have read this application and the information is correct; I agree to comply with any and all codes, ordinances, laws, regulations, or restrictions which apply to the project. I understand that failure to comply shall result in legal action, which may include but not necessarily be limited to non-use of the building(s).

Applicant's Signature Brian Burslund

Date 11-5-02

Department Approval Cheryl Johnson

Date 11/5/02


Additional water and/or sewer tap fee(s) are required:	YES	NO <input checked="" type="checkbox"/>	W/O No. <u>NO City use</u>
Utility Accounting	<u>Cheryl Johnson</u>		Date <u>11/5/02</u>

VALID FOR SIX MONTHS FROM DATE OF ISSUANCE (Section 2.2.C.1 Grand Junction Zoning and Development Code)

(White: Planning) (Yellow: Customer) (Pink: Building Department) (Goldenrod: Utility Accounting)

11/5/02
C. Jay Rubin
ACCEPTED
ANY CHANGE OF SETBACKS MUST BE
APPROVED BY THE CITY PLANNING
IT IS THE APPLICANT'S
RESPONSIBILITY TO PROPERLY
LOCATE AND IDENTIFY EASEMENTS
AND PROPERTY LINES.

ZONING I

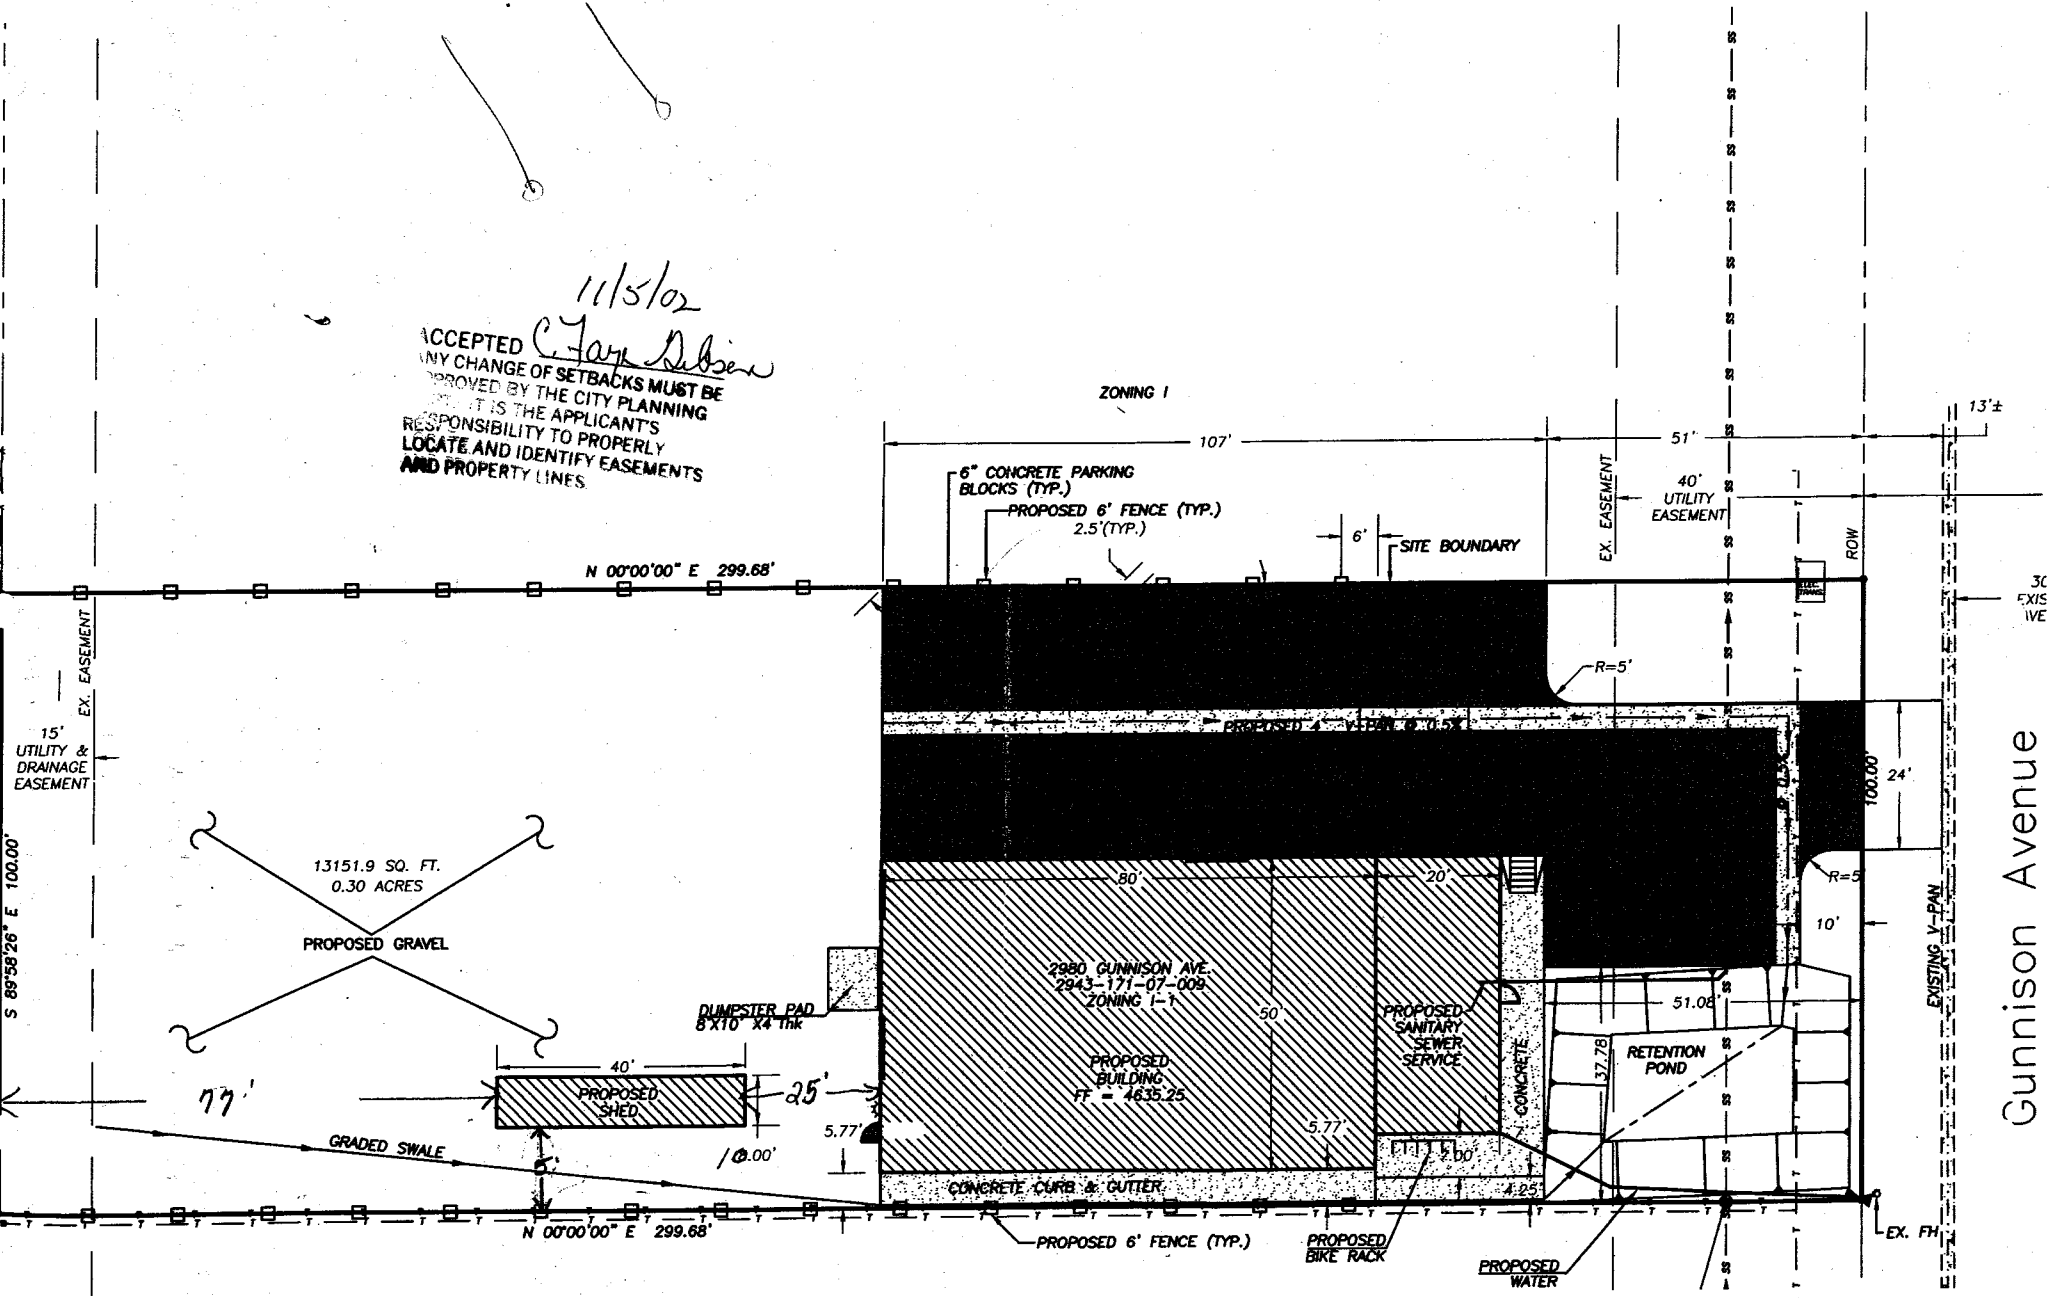

Gunnison Avenue