

FEE \$ 10.00  
 TCP \$ 500.00  
 SIF \$ 292.00

**PLANNING CLEARANCE**  
 (Single Family Residential and Accessory Structures)  
**Community Development Department**

BLDG PERMIT NO. 87075



Your Bridge to a Better Community

BLDG ADDRESS 469 Sunnyside SQ. FT. OF PROPOSED BLDGS/ADDITION 1292 garage 404  
 TAX SCHEDULE NO. 2943-16200-022 SQ. FT. OF EXISTING BLDGS \_\_\_\_\_  
 SUBDIVISION Grand Meadows TOTAL SQ. FT. OF EXISTING & PROPOSED \_\_\_\_\_  
 FILING \_\_\_\_\_ BLK 3 LOT 4 NO. OF DWELLING UNITS:  
 Before: 0 After: 1 this Construction  
 (1) OWNER Darter LLC NO. OF BUILDINGS ON PARCEL  
 Before: 0 After: 1 this Construction  
 (1) ADDRESS 7810 Valleyct USE OF EXISTING BUILDINGS \_\_\_\_\_  
 (1) TELEPHONE 523-5555 DESCRIPTION OF WORK & INTENDED USE \_\_\_\_\_  
 (2) APPLICANT Grace Homes TYPE OF HOME PROPOSED:  
 (2) ADDRESS 7810 Valleyct  Site Built \_\_\_\_\_ Manufactured Home (UBC)  
 (2) TELEPHONE 523-5555 \_\_\_\_\_ Manufactured Home (HUD)  
 \_\_\_\_\_ Other (please specify) \_\_\_\_\_

**REQUIRED: One plot plan, on 8 1/2" x 11" paper, showing all existing & proposed structure location(s), parking, setbacks to all property lines, ingress/egress to the property, driveway location & width & all easements & rights-of-way which abut the parcel.**

**THIS SECTION TO BE COMPLETED BY COMMUNITY DEVELOPMENT DEPARTMENT STAFF**

ZONE RMF-5 Maximum coverage of lot by structures 60%  
 SETBACKS: Front 20' from property line (PL) Permanent Foundation Required: YES  NO \_\_\_\_\_  
 or \_\_\_\_\_ from center of ROW, whichever is greater  
 Side 5' from PL, Rear 25' from PL Parking Req't 2  
 Maximum Height 35' Special Conditions \_\_\_\_\_  
 CENSUS 8 TRAFFIC 57 ANN# \_\_\_\_\_

Modifications to this Planning Clearance must be approved, in writing, by the Community Development Department. The structure authorized by this application cannot be occupied until a final inspection has been completed and a Certificate of Occupancy has been issued, if applicable, by the Building Department (Section 305, Uniform Building Code).

I hereby acknowledge that I have read this application and the information is correct; I agree to comply with any and all codes, ordinances, laws, regulations or restrictions which apply to the project. I understand that failure to comply shall result in legal action, which may include but not necessarily be limited to non-use of the building(s).

Applicant Signature Monica Kipta Date 11/21/02  
 Department Approval F. V. Y. Ishu Magor Date 11/26/02

Additional water and/or sewer tap fee(s) are required:	YES <input checked="" type="checkbox"/>	NO	W/O No. <u>15578</u>
Utility Accounting <u>T. Bensley</u>	Date <u>11/26/02</u>		


VALID FOR SIX MONTHS FROM DATE OF ISSUANCE (Section 9-3-2C Grand Junction Zoning & Development Code)

(White: Planning) (Yellow: Customer) (Pink: Building Department) (Goldenrod: Utility Accounting)

ACCEPTED  
 ANY CHANGE OF SETBACKS MUST BE  
 APPROVED BY THE CITY PLANNING  
 DEPARTMENT. THE APPLICANT'S  
 RESPONSIBILITY TO PROPERLY  
 LOCATE AND IDENTIFY EASEMENTS  
 AND PROPERTY LINES

*Alshi Aragon 11/20/02*

469 Gunnison  
 Way  
 Lot 4 Block 3  
 Scale: 1=20

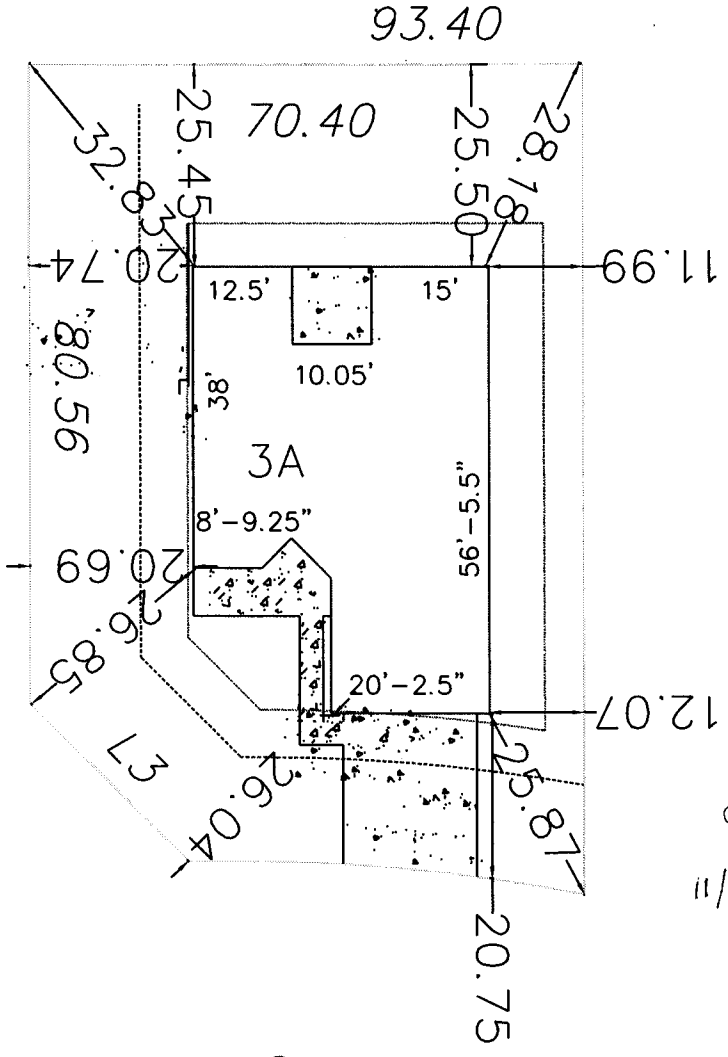

*ok  
 ll  
 11/21/02*

