FEE \$ 10.00 PLANNING C	LEARANCE BLDG PERMIT NO. 84191
TCP \$ (Single Family Residential a	
SIF \$ Community Develop	oment Department
	Your Bridge to a Better Community
BLDG ADDRESS 2887 W HERNOSA	SQ. FT. OF PROPOSED BLDGS/ADDITION
TAX SCHEDULE NO. 2943-064-36-007	SQ. FT. OF EXISTING BLDGS 2246 + 700 G
SUBDIVISION IND IND MASH IT	TOTAL SQ. FT. OF EXISTING & PROPOSED 3226
FILING BLK LOT	NO. OF DWELLING UNITS:
(1) OWNER ANTHOMY L VALOB2	Before: After: this Construction NO. OF BUILDINGS ON PARCEL
(1) ADDRESS 519 B AMYS WAY	Before: After: this Construction
(1) TELEPHONE <u>970-241-1710</u>	USE OF EXISTING BUILDINGS
⁽²⁾ APPLICANT	DESCRIPTION OF WORK & INTENDED USE
	TYPE OF HOME PROPOSED
⁽²⁾ ADDRESS	Site BuiltManufactured Home (UBC) Manufactured Home (HVD),
	Manufactured Home (HUD) Other (please specify) <u>SAURAGE</u> BLAG
	all existing & proposed structure location(s), parking, setbacks to all ocation & width & all easements & rights-of-way which abut the parcel.
	OMMUNITY DEVELOPMENT DEPARTMENT STAFF 12
ZONE PD	Maximum coverage of lot by structures 35%
SETBACKS: Front 14 20 from property line (PL)	
SETBACKS: Front <u>74_720_0</u> from property line (PL) or from center of ROW, whichever is greater	
Side <u>/0′</u> from PL, Rear <u>25</u> from F	Parking Req'mt
	Special Conditions
Maximum Height	- census <u>10</u> traffic <u>22</u> annx#
	oved, in writing, by the Community Development Department. The bied until a final inspection has been completed and a Certificate of ng Department (Section 305, Uniform Building Code).
	d the information is correct; I agree to comply with any and all codes, to the project. I understand that failure to comply shall result in legal to non-use of the building(s).


×.,

.

Applicant Signature Mary & Kelk Department Approval Dayleen Henderson	$\frac{1}{2} Date \frac{4 - 18 - 07}{2} Date \frac{4 - 18 - 02}{2}$
Additional water and/or sewer tap fee(s) are required: YES	NO W/O No.
Utility Accounting (Bensley	Date 4/18/02
VALID FOR SIX MONTHS FROM DATE OF ISSUANCE (Section	on 2.2 C 1 c(1) Grand Junction Zoning & Development Code)

VALID FOR SIX MONTHS FROM DATE OF ISSUANCE (Section 2.2.C.1.c(1) Grand Junction Zoning & Development Code)

(Goldenrod: Utility Accounting)

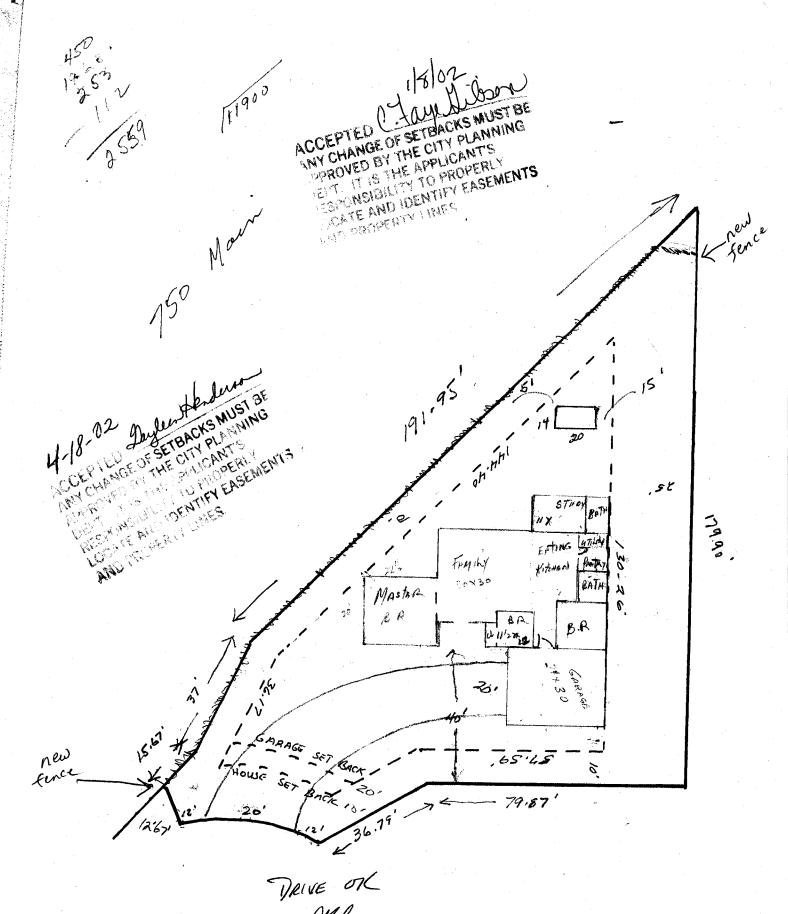

OMP 1/8/02

1000

- . . .

