

FEE \$	10.00
TCP \$	
SIF \$	

**PLANNING CLEARANCE**  
 (Single Family Residential and Accessory Structures)  
**Community Development Department**

BLDG PERMIT NO. 83515



Your Bridge to a Better Community

BLDG ADDRESS 1146 Micaelas Ct. SQ. FT. OF PROPOSED BLDGS/ADDITION 241 SQ FT  
 TAX SCHEDULE NO. 2945-234-12-007 SQ. FT. OF EXISTING BLDGS 1083 SQ FT  
 SUBDIVISION Micaelas Village TOTAL SQ. FT. OF EXISTING & PROPOSED 1324 SQ FT  
 FILING \_\_\_\_\_ BLK 1 LOT 7 NO. OF DWELLING UNITS:  
 Before: 1 After: 1 this Construction  
 (1) OWNER LOUIS + SHAWNA GRIMES NO. OF BUILDINGS ON PARCEL  
 Before: 1 After: 1 this Construction  
 (1) ADDRESS 1146 MICAEELAS CT. USE OF EXISTING BUILDINGS HOME  
 (1) TELEPHONE 243-6499 DESCRIPTION OF WORK & INTENDED USE ADDITION TO HOME  
 (2) APPLICANT JENSEN BUILDERS INC. TYPE OF HOME PROPOSED:  
 (2) ADDRESS 221 1/2 DREAM STREET \_\_\_\_\_ Site Built \_\_\_\_\_ Manufactured Home (UBC)  
 (2) TELEPHONE 250-5575 \_\_\_\_\_ Manufactured Home (HUD)  
 \_\_\_\_\_ Other (please specify) \_\_\_\_\_

**REQUIRED: One plot plan, on 8 1/2" x 11" paper, showing all existing & proposed structure location(s), parking, setbacks to all property lines, ingress/egress to the property, driveway location & width & all easements & rights-of-way which abut the parcel.**

**THIS SECTION TO BE COMPLETED BY COMMUNITY DEVELOPMENT DEPARTMENT STAFF**

ZONE RMF-8 Maximum coverage of lot by structures \_\_\_\_\_  
 SETBACKS: Front 20' from property line (PL) Permanent Foundation Required: YES \_\_\_\_\_ NO \_\_\_\_\_  
 or \_\_\_\_\_ from center of ROW, whichever is greater  
 Side 5' from PL, Rear 10' from PL Parking Req'mt \_\_\_\_\_  
 Maximum Height \_\_\_\_\_ Special Conditions \_\_\_\_\_  
 CENSUS \_\_\_\_\_ TRAFFIC \_\_\_\_\_ ANNEX# \_\_\_\_\_

Modifications to this Planning Clearance must be approved, in writing, by the Community Development Department. The structure authorized by this application cannot be occupied until a final inspection has been completed and a Certificate of Occupancy has been issued, if applicable, by the Building Department (Section 305, Uniform Building Code).

I hereby acknowledge that I have read this application and the information is correct; I agree to comply with any and all codes, ordinances, laws, regulations or restrictions which apply to the project. I understand that failure to comply shall result in legal action, which may include but not necessarily be limited to non-use of the building(s).

Applicant Signature [Signature] Date 2/2/02  
 Department Approval [Signature] Date 3-7-02

Additional water and/or sewer tap fee(s) are required:	YES	NO	W/O No. _____
Utility Accounting	<u>[Signature]</u>	Date	<u>3/7/02</u>

VALID FOR SIX MONTHS FROM DATE OF ISSUANCE (Section 2.2.C.1.c(1) Grand Junction Zoning & Development Code)

(White: Planning) (Yellow: Customer) (Pink: Building Department) (Goldenrod: Utility Accounting)

3-7-02


ACCEPTED *Dayleen Henderson*  
ANY CHANGE OF SETBACKS MUST BE  
APPROVED BY THE CITY PLANNING  
DEPT. IT IS THE APPLICANT'S  
RESPONSIBILITY TO PROPERLY  
LOCATE AND IDENTIFY EASEMENTS  
AND PROPERTY LINES.

ACCEPTED *5/15/12*  
ANY CHANGE OF SETBACKS MUST BE  
APPROVED BY THE CITY PLANNING  
DEPT. IT IS THE APPLICANT'S  
RESPONSIBILITY TO PROPERLY  
LOCATE AND IDENTIFY EASEMENTS  
AND PROPERTY LINES.



*DRIVEWAY location*  
O.K.  
*4/11/12 E.L. Dahlbeck*

**PLOT PLAN**  
NTS.

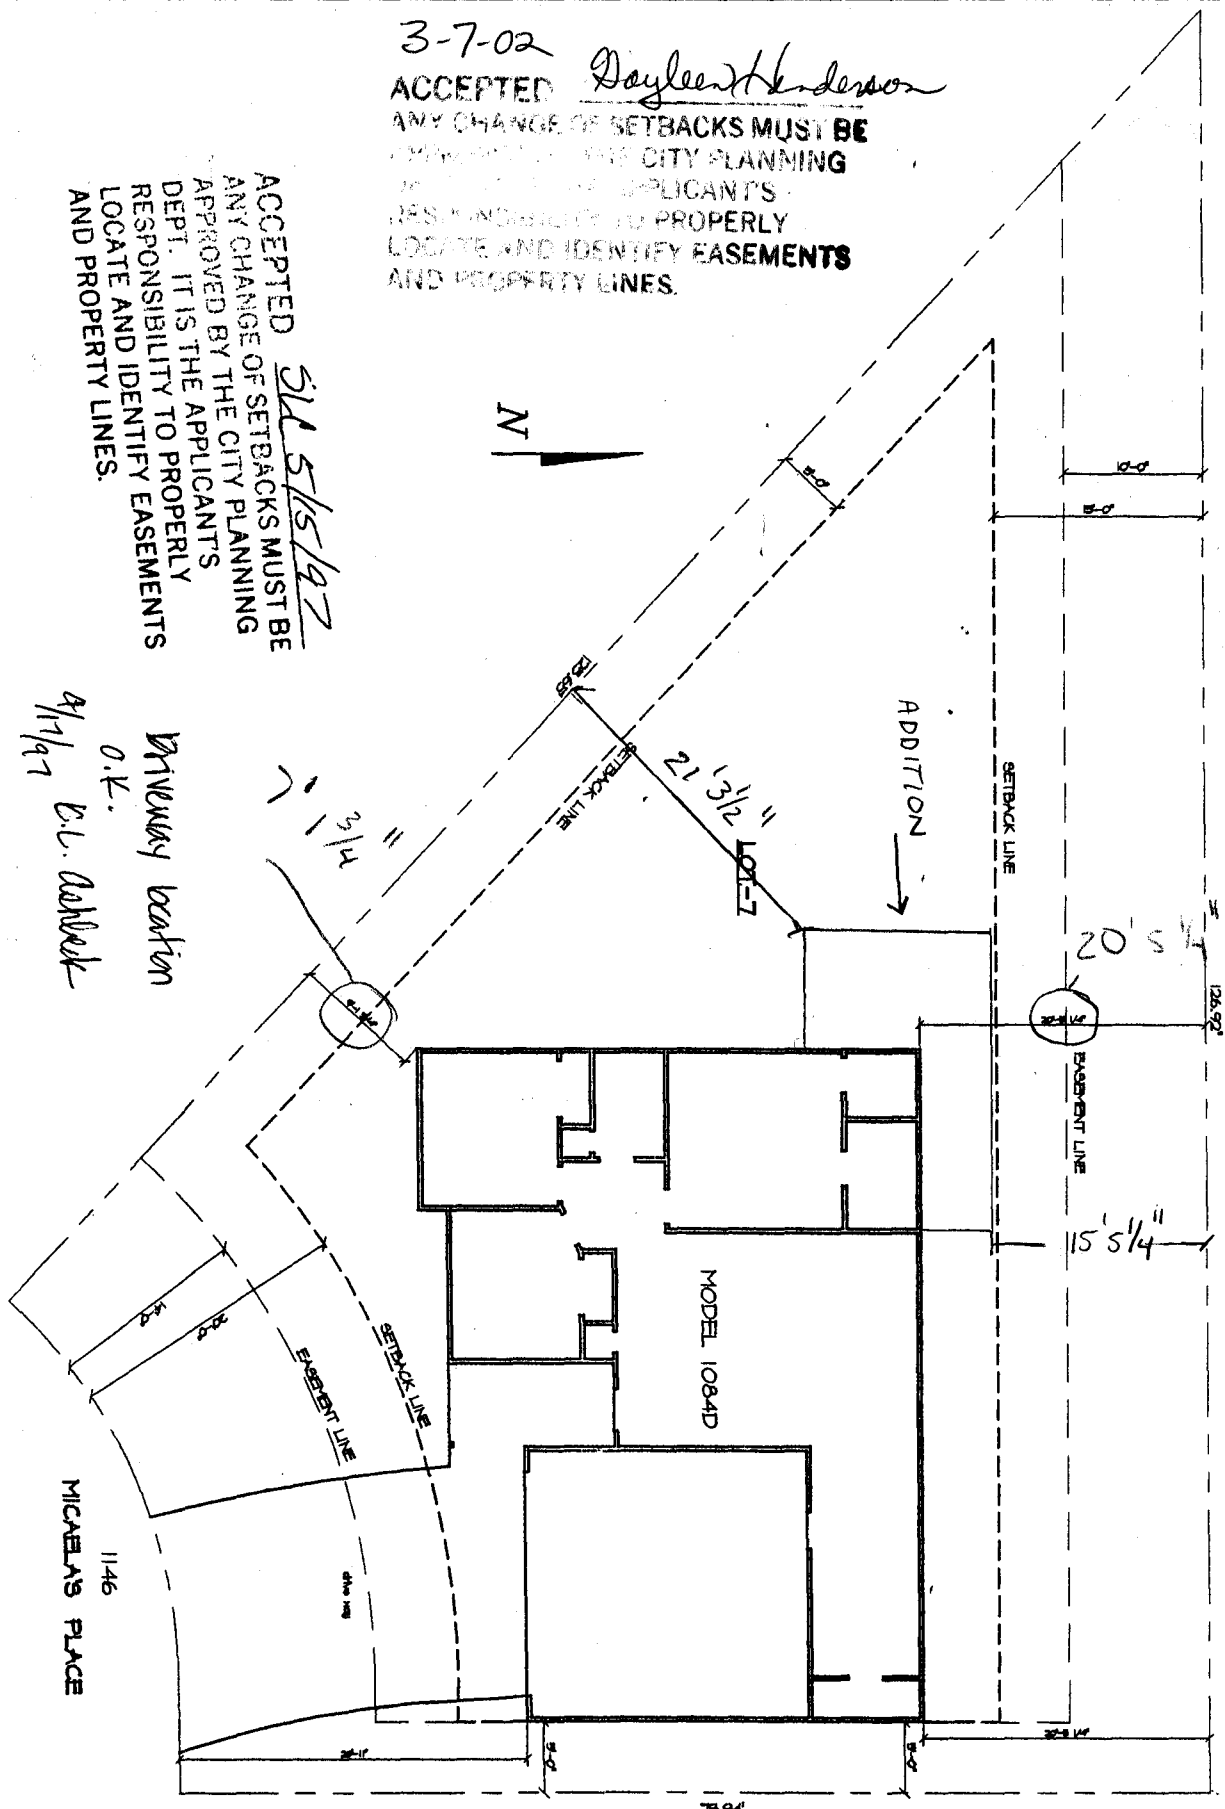

73.94'

JMK & Associates 201 W. 2nd Street Grand Junction, CO 81502 (970) 241-2222		Zeck & Associates LLC P.O. Box 1088 Grand Junction, CO. 81502 (970) 257-9483	<b>PLOT PLAN for</b> <b>LOT 7, BLOCK 1</b> <b>Micaela Village Subdivision</b>	SHEET NO. 11
		PL-1	DATE 3/7/12	DRAWN BY JMK