

FEE \$ <u>10.00</u>
TCP \$ <u>0</u>
SIF \$ <u>292.00</u>

PLANNING CLEARANCE

(Single Family Residential and Accessory Structures)

Community Development Department

BLDG PERMIT NO. 84019



Your Bridge to a Better Community

BLDG ADDRESS 661 A Miranda SQ. FT. OF PROPOSED BLDGS/ADDITION 1360
 TAX SCHEDULE NO. 294503278-007 SQ. FT. OF EXISTING BLDGS 0
 SUBDIVISION Diamond Ridge TOTAL SQ. FT. OF EXISTING & PROPOSED 1360
 FILING 2 BLK 1 LOT HA NO. OF DWELLING UNITS:
 Before: 0 After: 1 this Construction
 (1) OWNER Kiva Development NO. OF BUILDINGS ON PARCEL
 Before: 0 After: 1 this Construction
 (1) ADDRESS 675 Grunstone A
 (1) TELEPHONE 234 4000 USE OF EXISTING BUILDINGS _____
 (2) APPLICANT _____ DESCRIPTION OF WORK & INTENDED USE New Home
 (2) ADDRESS _____ TYPE OF HOME PROPOSED:
 Site Built _____ Manufactured Home (UBC)
 _____ Manufactured Home (HUD)
 (2) TELEPHONE _____ _____ Other (please specify) _____

REQUIRED: One plot plan, on 8 1/2" x 11" paper, showing all existing & proposed structure location(s), parking, setbacks to all property lines, ingress/egress to the property, driveway location & width & all easements & rights-of-way which abut the parcel.

THIS SECTION TO BE COMPLETED BY COMMUNITY DEVELOPMENT DEPARTMENT STAFF

ZONE PD Maximum coverage of lot by structures 3590
 SETBACKS: Front 20' from property line (PL) Permanent Foundation Required: YES NO _____
 or _____ from center of ROW, whichever is greater
 Side 0'5' from PL, Rear 23' from PL Parking Req'mt 2
 Maximum Height 32' Special Conditions _____
 CENSUS 10 TRAFFIC 19 ANN# _____

Modifications to this Planning Clearance must be approved, in writing, by the Community Development Department. The structure authorized by this application cannot be occupied until a final inspection has been completed and a Certificate of Occupancy has been issued, if applicable, by the Building Department (Section 305, Uniform Building Code).

I hereby acknowledge that I have read this application and the information is correct; I agree to comply with any and all codes, ordinances, laws, regulations or restrictions which apply to the project. I understand that failure to comply shall result in legal action, which may include but not necessarily be limited to non-use of the building(s).

Applicant Signature [Signature] Date 4/08/02
 Department Approval [Signature] Date 4/5/02

Additional water and/or sewer tap fee(s) are required:	<input checked="" type="checkbox"/> YES	<input type="checkbox"/> NO	W/O No. <u>14742</u>
Utility Accounting	<u>[Signature]</u>		Date <u>4/19/02</u>

VALID FOR SIX MONTHS FROM DATE OF ISSUANCE (Section 2.2.C.1.c(1) Grand Junction Zoning & Development Code)

(White: Planning) (Yellow: Customer) (Pink: Building Department) (Goldenrod: Utility Accounting)

00°01'16" W

449.14

ACCEPTED *C. Faye Gibson*
ANY CHANGE OF SETBACKS MUST BE APPROVED BY THE CITY PLANNING DEPT. IT IS THE APPLICANT'S RESPONSIBILITY TO PROPERLY LOCATE AND IDENTIFY EASEMENTS AND PROPERTY LINES.


STREET

390.08'

W

355.29'

S 89°58'44"

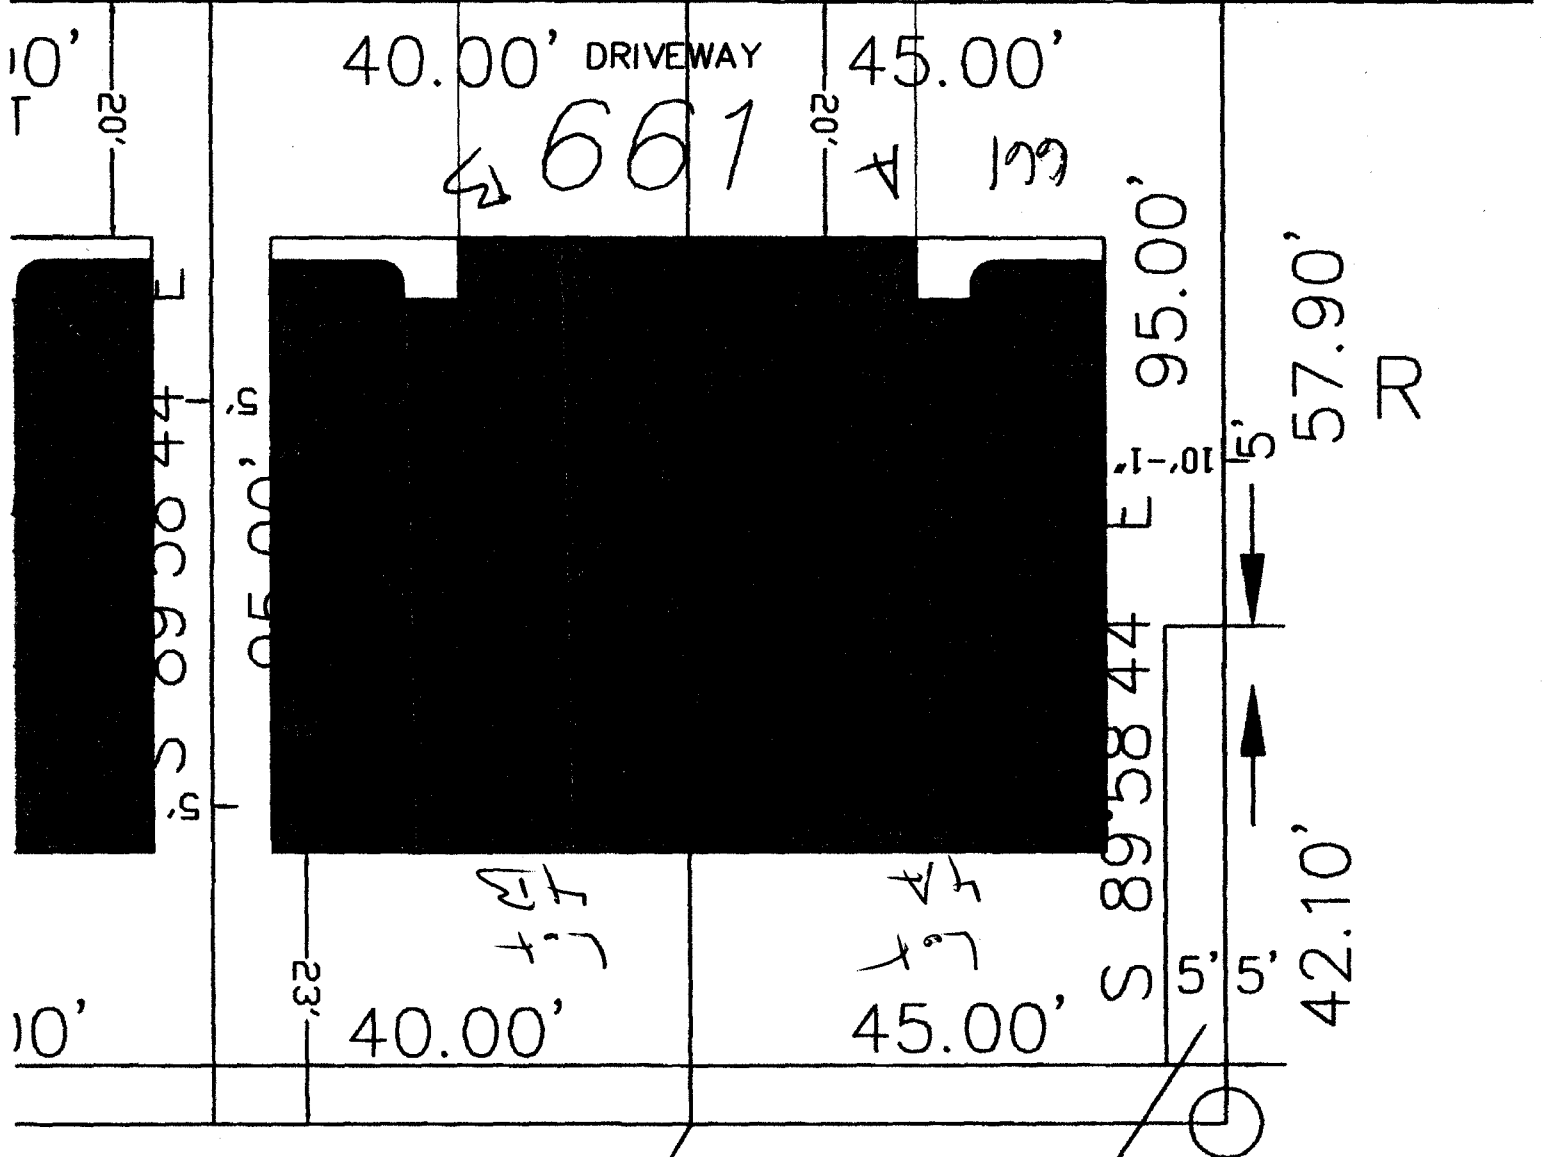

10' UTILITY, IRRIGATION AND DRAINAGE EASEMENT

*DRIVE OK
DML
4/9/02*