

FEE \$	10.00
TCP \$	500
SIF \$	292.00

PLANNING CLEARANCE
 (Single Family Residential and Accessory Structures)
Community Development Department

BLDG PERMIT NO. 84823



Your Bridge to a Better Community

BLDG ADDRESS 2476 MERRANSER DR SQ. FT. OF PROPOSED BLDGS/ADDITION 1451

TAX SCHEDULE NO. 2701-334-35-000 SQ. FT. OF EXISTING BLDGS 0

SUBDIVISION Fountain Greens TOTAL SQ. FT. OF EXISTING & PROPOSED 1451

FILING 2 BLK 2 LOT 5 NO. OF DWELLING UNITS:
 Before: 0 After: 1 this Construction

(1) OWNER LARSON, LARSON ENTIRE NO. OF BUILDINGS ON PARCEL
 Before: 0 After: 1 this Construction

(1) ADDRESS PO Box 3477 USE OF EXISTING BUILDINGS Residential

(1) TELEPHONE 245-9657 DESCRIPTION OF WORK & INTENDED USE NEW HOME

(2) APPLICANT TERRY LARSON TYPE OF HOME PROPOSED:
 Site Built Manufactured Home (UBC)
 Manufactured Home (HUD)
 Other (please specify) _____

(2) ADDRESS 2205 MESCALERO AVE

(2) TELEPHONE 260-0450

REQUIRED: One plot plan, on 8 1/2" x 11" paper, showing all existing & proposed structure location(s), parking, setbacks to all property lines, ingress/egress to the property, driveway location & width & all easements & rights-of-way which abut the parcel.

THIS SECTION TO BE COMPLETED BY COMMUNITY DEVELOPMENT DEPARTMENT STAFF

ZONE PD Maximum coverage of lot by structures 45%

SETBACKS: Front 15' from property line (PL) Permanent Foundation Required: YES NO
 or _____ from center of ROW, whichever is greater

Side 5' from PL, Rear 10' from PL Parking Req't 2

Maximum Height 32' Special Conditions Foundation Requires Engineered Design

CENSUS 9 TRAFFIC 4 ANNEX# _____

Modifications to this Planning Clearance must be approved, in writing, by the Community Development Department. The structure authorized by this application cannot be occupied until a final inspection has been completed and a Certificate of Occupancy has been issued, if applicable, by the Building Department (Section 305, Uniform Building Code).

I hereby acknowledge that I have read this application and the information is correct; I agree to comply with any and all codes, ordinances, laws, regulations or restrictions which apply to the project. I understand that failure to comply shall result in legal action, which may include but not necessarily be limited to non-use of the building(s).

Applicant Signature Terry Larson Date 5-30-02

Department Approval Fl. Gayle Henderson Date 6-3-02


Additional water and/or sewer tap fee(s) are required:	YES <input checked="" type="checkbox"/>	NO <input type="checkbox"/>	W/O No. <u>14980</u>
Utility Accounting	<u>Tracy Shifer</u>		Date <u>6/3/02</u>

VALID FOR SIX MONTHS FROM DATE OF ISSUANCE (Section 2.2.C.1.c(1) Grand Junction Zoning & Development Code)


(White: Planning) (Yellow: Customer) (Pink: Building Department) (Goldenrod: Utility Accounting)

Lot 5, Block 2
 Fountain Green Sub., Filing 2
 Grand Junction, CO.

2476 M&L GANSEER DR

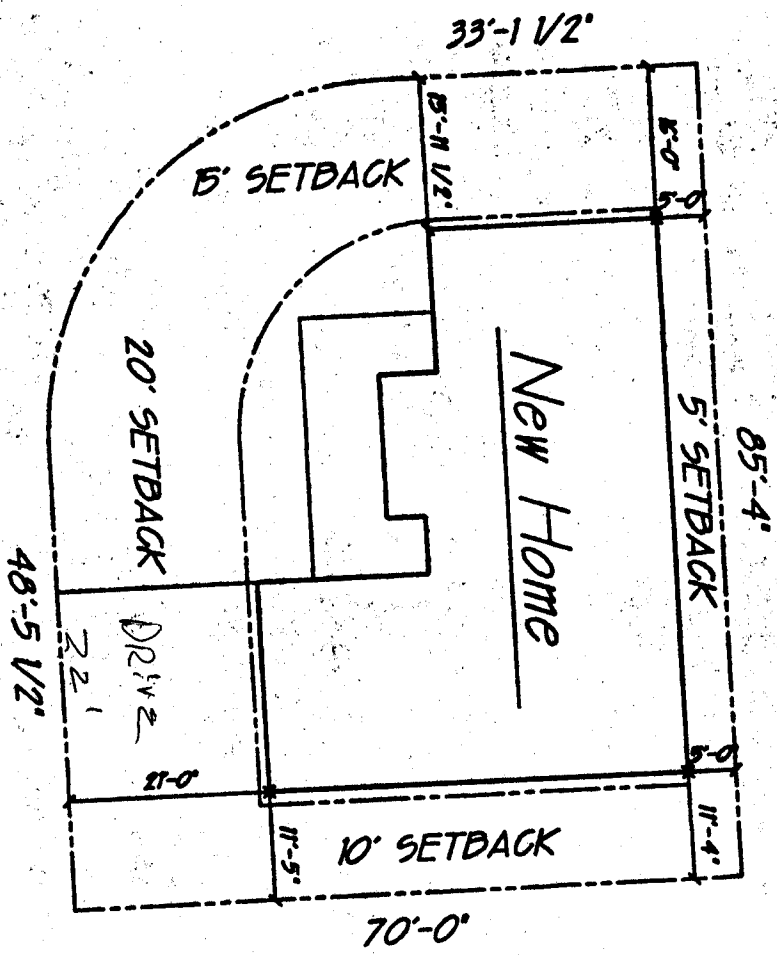

DRIVE OK
 DWG
 5/31/02

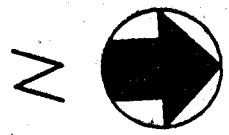

6-3-02
 ACCEPTED Gayle Henderson
 ANY CHANGE OF SETBACKS MUST BE
 APPROVED BY THE CITY PLANNING
 DEPT. IT IS THE APPLICANT'S
 RESPONSIBILITY TO PROPERLY
 LOCATE AND IDENTIFY EASEMENTS
 AND PROPERTY LINES.