FEE \$ //   TCP \$ O   SIF \$ O	nd Accessory Structures)
BLDG ADDRESS _ 2836 Pitchbend Ct	SQ. FT. OF PROPOSED BLDGS/ADDITION 10x12 10
TAX SCHEDULE NO. 2943-303-61-024	SQ. FT. OF EXISTING BLDGS
SUBDIVISION Lane Simple Sub.	
(1) ADDRESS 2836 Pitchlugh, Ct	NO. OF DWELLING UNITS: Before: After: this Construction NO. OF BUILDINGS ON PARCEL Before: After: this Construction
(1) TELEPHONE 970-263-7447	USE OF EXISTING BUILDINGS
(2) APPLICANT	TYPE OF HOME PROPOSED: Site Built Manufactured Home (UBC) Manufactured Home (HUD)
<sup>(2)</sup> TELEPHONE	Other (please specify)
	all existing & proposed structure location(s), parking, setbacks to all cation & width & all easements & rights-of-way which abut the parcel.

ZONE	25	Maximum coverage of lot by structures
SETBACKS: Front or from center of RC Side3 from PL, Maximum Height <i>Iucussom</i>	35'	Permanent Foundation Required: YESNO Parking Req'mt


Modifications to this Planning Clearance must be approved, in writing, by the Community Development Department. The structure authorized by this application cannot be occupied until a final inspection has been completed and a Certificate of Occupancy has been issued, if applicable, by the Building Department (Section 305, Uniform Building Code).

I hereby acknowledge that I have read this application and the information is correct; I agree to comply with any and all codes, ordinances, laws, regulations or restrictions which apply to the project. I understand that failure to comply shall result in legal action, which may include but not necessarily be limited to non-use of the building(s).

Applicant Signature Donne Glevards	Date5/16/02 Date5/16/02	
Additional water and/or sewer tap fee(s) are required: YES	NO W/O No.	
Utility Accounting CIBensley	Date 5/16/07	
VALID FOR SIX MONTHS FROM DATE OF ISSUANCE (Section 2	2.2.C.1.c(1) Grand Junction Zoning & Development Code)	

(White: Planning)

(Goldenrod: Utility Accounting)

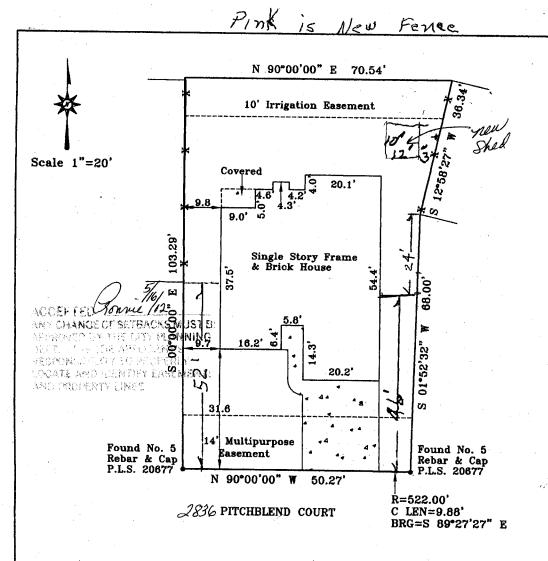

Note: This Document is warranted for a period of 1 year from date of certification.

## IMPROVEMENT LOCATION CERTIFICATE

LEGAL DESCRIPTION: Lot 1, of LANE SIMPLE SUBDIVISION, Mesa County, Colorado. Legal Description and Easements of Record provided by First American Title Co. 00144207.

I hereby certify that this IMPROVEMENT LOCATION CERTIFICATE was prepared for Fogale Family Trust, that this is not a land survey plat or improvement survey plat, and that it is not to be relied upon for the establishments of fences, buildings or other future improvements.

I further certify that the improvements on the above described parcel on this date 1/29/02. except utility connections are entirely within the boundaries of the parcel, except as shown, that there are no encroachments upon the described premises, by improvements of any adjoining premises, except as indicated, and that there is no evidence or sign of any easement crossing or burdening any part of said parcel, except as noted.

- 02

Cecil Di Caster Registered Professional Land Surveyor P.L.S. Numser/74943 Monument Surveying Co. 741 Rood Ave. Grand Junction, CO 81501 245-4189 LC 02-13 1/25/02 Fogale Property 2836 Pitchblend Court

2836