

FEE \$ 10.00
TCP \$ 500.00
SIF \$ 292.00

PLANNING CLEARANCE

BLDG PERMIT NO. 85922

(Single Family Residential and Accessory Structures)
Community Development Department



Your Bridge to a Better Community

BLDG ADDRESS 2855 Presley SQ. FT. OF PROPOSED BLDGS/ADDITION 1404

TAX SCHEDULE NO. 2943-071-26-005 SQ. FT. OF EXISTING BLDGS N/A

SUBDIVISION The Legends TOTAL SQ. FT. OF EXISTING & PROPOSED 1404

FILING 3 BLK 3 LOT 5 NO. OF DWELLING UNITS:
 Before: 0 After: 1 this Construction

(1) OWNER Legenos Partners NO. OF BUILDINGS ON PARCEL:
 Before: 0 After: 1 this Construction

(1) ADDRESS P.O. Box 1765, GJ, CO 81502 USE OF EXISTING BUILDINGS N/A

(1) TELEPHONE 970-244-9986 #17 DESCRIPTION OF WORK & INTENDED USE NEW single Family

(2) APPLICANT Legenos Partners TYPE OF HOME PROPOSED:
 Site Built Manufactured Home (UBC)
 Manufactured Home (HUD)
 Other (please specify) _____

(2) ADDRESS P.O. Box 1765, GJ, CO 81502

(2) TELEPHONE 970-244-9986 #17

REQUIRED: One plot plan, on 8 1/2" x 11" paper, showing all existing & proposed structure location(s), parking, setbacks to all property lines, ingress/egress to the property, driveway location & width & all easements & rights-of-way which abut the parcel.

THIS SECTION TO BE COMPLETED BY COMMUNITY DEVELOPMENT DEPARTMENT STAFF

ZONE PD Maximum coverage of lot by structures _____

SETBACKS: Front 15' home 20' garage from property line (PL) Permanent Foundation Required: YES NO _____
 or _____ from center of ROW, whichever is greater

Side 5' from PL, Rear 10' from PL Parking Req'mt 2

Maximum Height 32' Special Conditions _____

CENSUS 6 TRAFFIC 29 ANN# _____

Modifications to this Planning Clearance must be approved, in writing, by the Community Development Department. The structure authorized by this application cannot be occupied until a final inspection has been completed and a Certificate of Occupancy has been issued, if applicable, by the Building Department (Section 305, Uniform Building Code).

I hereby acknowledge that I have read this application and the information is correct; I agree to comply with any and all codes, ordinances, laws, regulations or restrictions which apply to the project. I understand that failure to comply shall result in legal action, which may include but not necessarily be limited to non-use of the building(s).

Applicant Signature [Signature] Date 8-19-02

Department Approval T. B. Pat Kushman Date 8-26-02

Additional water and/or sewer tap fee(s) are required:	YES <input checked="" type="checkbox"/>	NO	W/O No. <u>see attached</u>
Utility Accounting	<u>[Signature]</u>	Date	<u>8/26/02</u>

VALID FOR SIX MONTHS FROM DATE OF ISSUANCE (Section 9-3-2C Grand Junction Zoning & Development Code)

(White: Planning) (Yellow: Customer) (Pink: Building Department) (Goldenrod: Utility Accounting)

THE LEGENDS PARTNERS
THE LEGENDS

8-26-02

Exhibit H.


ACCEPTED *Paz Bushman*
ANY CHANGE OF SETBACKS MUST BE
APPROVED BY THE CITY PLANNING
DEPT. IT IS THE APPLICANT'S
RESPONSIBILITY TO PROPERLY
LOCATE AND IDENTIFY EASEMENT
AND PROPERTY LINES

NOT TO SCALE

Presley AVE.



59.53'

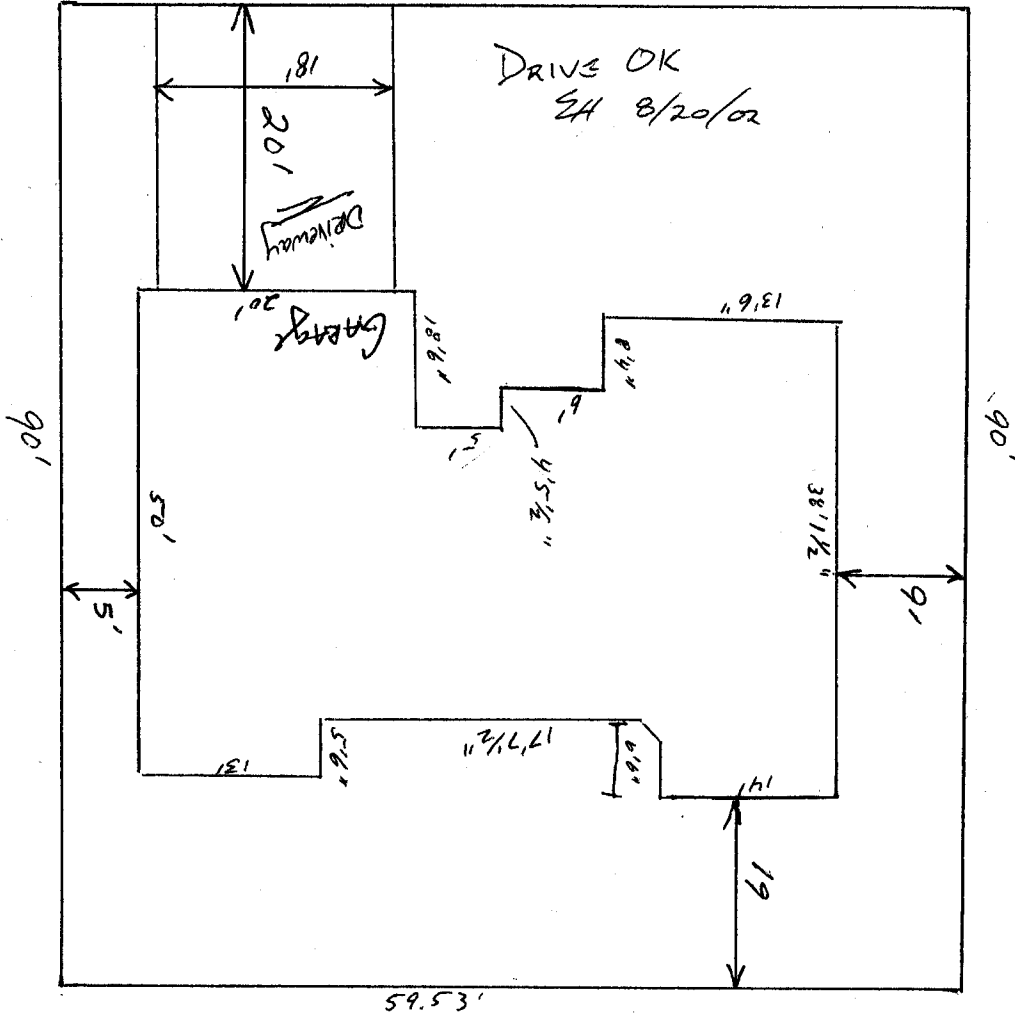

Label street and drive locations and names. Sketch house and garage with preferred garage access. Show North direction by arrow, also show preferred set back from property line.

Buyer *Fancy K. Casady*

Date 5-22-02