

FEE \$	10.00
TCP \$	0
SIF \$	292.00

PLANNING CLEARANCE
 (Single Family Residential and Accessory Structures)
Community Development Department

BLDG PERMIT NO. 83241



Your Bridge to a Better Community

BLDG ADDRESS 450 Quarry Court SQ. FT. OF PROPOSED BLDGS/ADDITION 1760
 TAX SCHEDULE NO. 2943-161-95-001 SQ. FT. OF EXISTING BLDGS 0
 SUBDIVISION Fruitvale Meadows TOTAL SQ. FT. OF EXISTING & PROPOSED 1760
 FILING _____ BLK 1 LOT 1 NO. OF DWELLING UNITS:
 Before: 0 After: 1 this Construction
 (1) OWNER Jore Bungara NO. OF BUILDINGS ON PARCEL
 Before: 0 After: 1 this Construction
 (1) ADDRESS 2911 1/2 Dawn Dr. Ft. Floyd USE OF EXISTING BUILDINGS N/A
 (1) TELEPHONE 241-2471 x 28 mobile DESCRIPTION OF WORK & INTENDED USE New Single Family
 (2) APPLICANT SAME TYPE OF HOME PROPOSED:
 (2) ADDRESS _____ Site Built _____ Manufactured Home (UBC)
 (2) TELEPHONE _____ _____ Manufactured Home (HUD)
 _____ Other (please specify) _____

REQUIRED: One plot plan, on 8 1/2" x 11" paper, showing all existing & proposed structure location(s), parking, setbacks to all property lines, ingress/egress to the property, driveway location & width & all easements & rights-of-way which abut the parcel.

THIS SECTION TO BE COMPLETED BY COMMUNITY DEVELOPMENT DEPARTMENT STAFF

ZONE RMF-5 Maximum coverage of lot by structures 60%
 SETBACKS: Front 20' from property line (PL) Permanent Foundation Required: YES NO _____
 or _____ from center of ROW, whichever is greater
 Side 5' from PL, Rear 25' from PL Parking Req'mt 2
 Maximum Height 35' Special Conditions _____
 CENSUS 8 TRAFFIC 57 ANN# _____

Modifications to this Planning Clearance must be approved, in writing, by the Community Development Department. The structure authorized by this application cannot be occupied until a final inspection has been completed and a Certificate of Occupancy has been issued, if applicable, by the Building Department (Section 305, Uniform Building Code).

I hereby acknowledge that I have read this application and the information is correct; I agree to comply with any and all codes, ordinances, laws, regulations or restrictions which apply to the project. I understand that failure to comply shall result in legal action, which may include but not necessarily be limited to non-use of the building(s).

Applicant Signature [Signature] Date 02/13/02
 Department Approval [Signature] Date 2/15/02

Additional water and/or sewer tap fee(s) are required:	YES <input checked="" type="checkbox"/>	NO	W/O No. <u>74582</u>
Utility Accounting <u>[Signature]</u>	Date <u>2-15-02</u>		

VALID FOR SIX MONTHS FROM DATE OF ISSUANCE (Section 9-3-2C Grand Junction Zoning & Development Code)

(White: Planning) (Yellow: Customer) (Pink: Building Department) (Goldenrod: Utility Accounting)

FEE \$	10.00
TCP \$	0
SIF \$	292.00

PLANNING CLEARANCE
 (Single Family Residential and Accessory Structures)
Community Development Department

BLDG PERMIT NO. 83241



Your Bridge to a Better Community

BLDG ADDRESS 450 Quarry Court SQ. FT. OF PROPOSED BLDGS/ADDITION 1760

TAX SCHEDULE NO. 2943-161-95-001 SQ. FT. OF EXISTING BLDGS 0

SUBDIVISION Fruitvale Meadows TOTAL SQ. FT. OF EXISTING & PROPOSED 1760

FILING _____ BLK 1 LOT 1 NO. OF DWELLING UNITS:
 Before: 0 After: 1 this Construction

(1) OWNER Jore Bungara NO. OF BUILDINGS ON PARCEL
 Before: 0 After: 1 this Construction

(1) ADDRESS 2911 1/2 Dawn Dr. GJ, FWDY USE OF EXISTING BUILDINGS N/A

(1) TELEPHONE 241-2471 x 28 mobile DESCRIPTION OF WORK & INTENDED USE New Single Family

(2) APPLICANT SAME TYPE OF HOME PROPOSED:
 Site Built _____ Manufactured Home (UBC)
 _____ Manufactured Home (HUD)
 _____ Other (please specify) _____

(2) ADDRESS _____

(2) TELEPHONE _____

REQUIRED: One plot plan, on 8 1/2" x 11" paper, showing all existing & proposed structure location(s), parking, setbacks to all property lines, ingress/egress to the property, driveway location & width & all easements & rights-of-way which abut the parcel.

THIS SECTION TO BE COMPLETED BY COMMUNITY DEVELOPMENT DEPARTMENT STAFF

ZONE RMF-5 Maximum coverage of lot by structures 60%

SETBACKS: Front 20' from property line (PL) Permanent Foundation Required: YES NO _____
 or _____ from center of ROW, whichever is greater

Side 5' from PL, Rear 25' from PL Parking Req'mt 2

Maximum Height 35' Special Conditions _____

CENSUS 8 TRAFFIC 57 ANNEX# _____

Modifications to this Planning Clearance must be approved, in writing, by the Community Development Department. The structure authorized by this application cannot be occupied until a final inspection has been completed and a Certificate of Occupancy has been issued, if applicable, by the Building Department (Section 305, Uniform Building Code).

I hereby acknowledge that I have read this application and the information is correct; I agree to comply with any and all codes, ordinances, laws, regulations or restrictions which apply to the project. I understand that failure to comply shall result in legal action, which may include but not necessarily be limited to non-use of the building(s).

Applicant Signature [Signature] Date 02/13/02

Department Approval [Signature] Date 2/15/02

Additional water and/or sewer tap fee(s) are required:	YES <input checked="" type="checkbox"/>	NO	W/O No <u>74582</u>
Utility Accounting <u>[Signature]</u>	Date <u>2-15-02</u>		


VALID FOR SIX MONTHS FROM DATE OF ISSUANCE (Section 9-3-2C Grand Junction Zoning & Development Code)

(White: Planning) (Yellow: Customer) (Pink: Building Department) (Goldenrod: Utility Accounting)


Quarry Ct.

30 3/4 ROAD

ACCEPTED *Law 2/15/02*
ANY CHANGE OF SETBACKS MUST BE
APPROVED BY THE CITY PLANNING
DEPT. IT IS THE APPLICANT'S
RESPONSIBILITY TO PROPERLY
LOCATE AND IDENTIFY EASEMENTS
AND PROPERTY LINES.

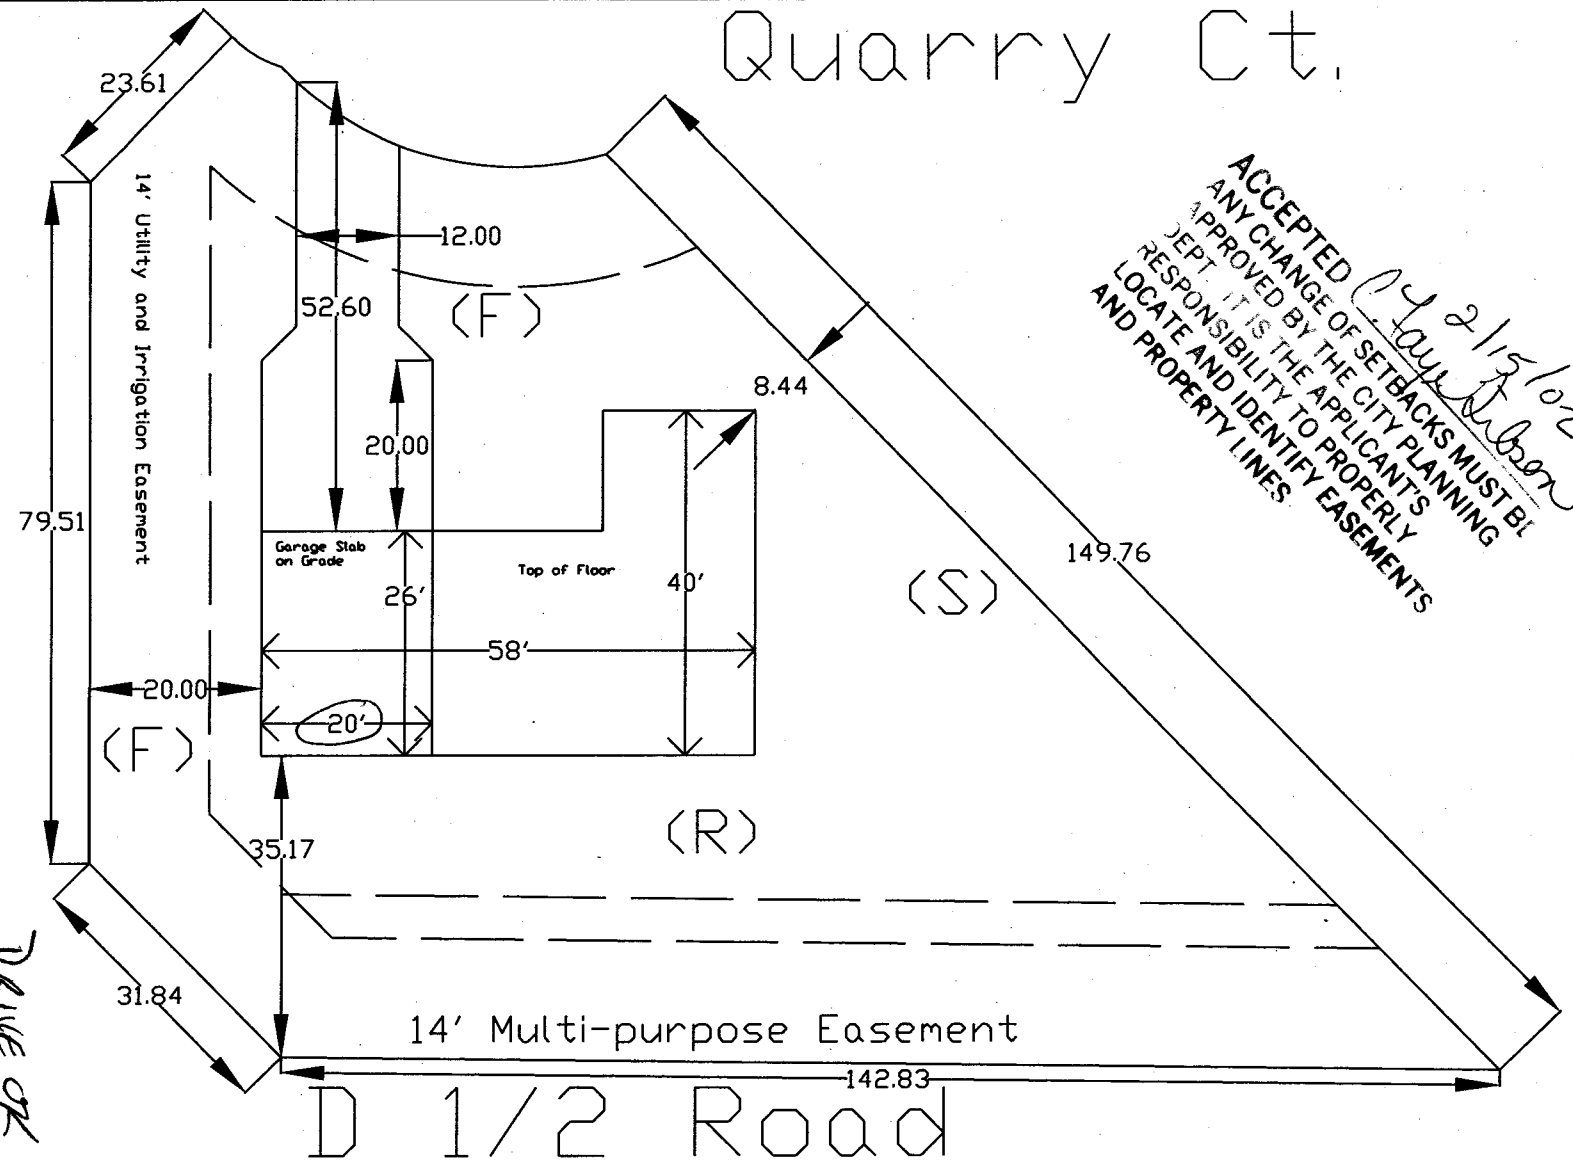

*DRIVE OK
AMP
2/15/02*

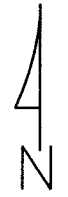	Burgara	
	450 Quarry Ct.	
Lot 1	Fruitvale Meadows	SQ.FT. 11752
Block 1	SCALE	The Energy Office