

FEE \$	10.00
TCP \$	500.00
SIF \$	292.00

PLANNING CLEARANCE

(Single Family Residential and Accessory Structures)
Community Development Department

BLDG PERMIT NO. 82779



Your Bridge to a Better Community

BLDG ADDRESS 2431 Ran Ridge Rd SQ. FT. OF PROPOSED BLDGS/ADDITION 1735 #

TAX SCHEDULE NO. 2701-333-01-001 SQ. FT. OF EXISTING BLDGS 1735 #

SUBDIVISION Spanish Trails TOTAL SQ. FT. OF EXISTING & PROPOSED 1735 #

FILING 1 BLK 2 LOT 3 NO. OF DWELLING UNITS:
 Before: 0 After: 1 this Construction

(1) OWNER TML Enterprises Inc NO. OF BUILDINGS ON PARCEL
 Before: 0 After: 1 this Construction

(1) ADDRESS Box 2569, G J CO USE OF EXISTING BUILDINGS Single Family

(1) TELEPHONE 201-8022 DESCRIPTION OF WORK & INTENDED USE Single Family

(2) APPLICANT TML Enterprises Inc TYPE OF HOME PROPOSED: PATT
 Site Built Manufactured Home (UBC)
 Manufactured Home (HUD)
 Other (please specify) _____

(2) ADDRESS Box 2569 G J. CO TB

(2) TELEPHONE 201-8022

REQUIRED: One plot plan, on 8 1/2" x 11" paper, showing all existing & proposed structure location(s), parking, setbacks to all property lines, ingress/egress to the property, driveway location & width & all easements & rights-of-way which abut the parcel.

THIS SECTION TO BE COMPLETED BY COMMUNITY DEVELOPMENT DEPARTMENT STAFF

ZONE PD Maximum coverage of lot by structures _____

SETBACKS: Front 20' from property line (PL) Permanent Foundation Required: YES NO
 or _____ from center of ROW, whichever is greater

Side 5'0" from PL, Rear 20' from PL Parking Req'mt 2

Maximum Height 32' Special Conditions Letter from Engineer Regid

CENSUS 9 TRAFFIC 5 ANNEX# _____

Modifications to this Planning Clearance must be approved, in writing, by the Community Development Department. The structure authorized by this application cannot be occupied until a final inspection has been completed and a Certificate of Occupancy has been issued, if applicable, by the Building Department (Section 305, Uniform Building Code).

I hereby acknowledge that I have read this application and the information is correct; I agree to comply with any and all codes, ordinances, laws, regulations or restrictions which apply to the project. I understand that failure to comply shall result in legal action, which may include but not necessarily be limited to non-use of the building(s).

Applicant Signature Thomas M. ... Date 1/2/02


Department Approval CFB Daylen Henderson Date 1-3-02

Additional water and/or sewer tap fee(s) are required:	YES <input checked="" type="checkbox"/>	NO	W/O No. <u>14470</u>
Utility Accounting	<u>U Beusley</u>	Date	<u>1/3/02</u>

VALID FOR SIX MONTHS FROM DATE OF ISSUANCE (Section 9-3-2C Grand Junction Zoning & Development Code)

(White: Planning) (Yellow: Customer) (Pink: Building Department) (Goldenrod: Utility Accounting)

1-3-02
 ACCEPTED *Gayles Henderson*
 ANY CHANGE OF SETBACKS MUST BE
 APPROVED BY THE CITY PLANNING
 DEPT. IT IS THE APPLICANT'S
 RESPONSIBILITY TO PROPERLY
 LOCATE AND IDENTIFY EASEMENTS
 AND PROPERTY LINES.

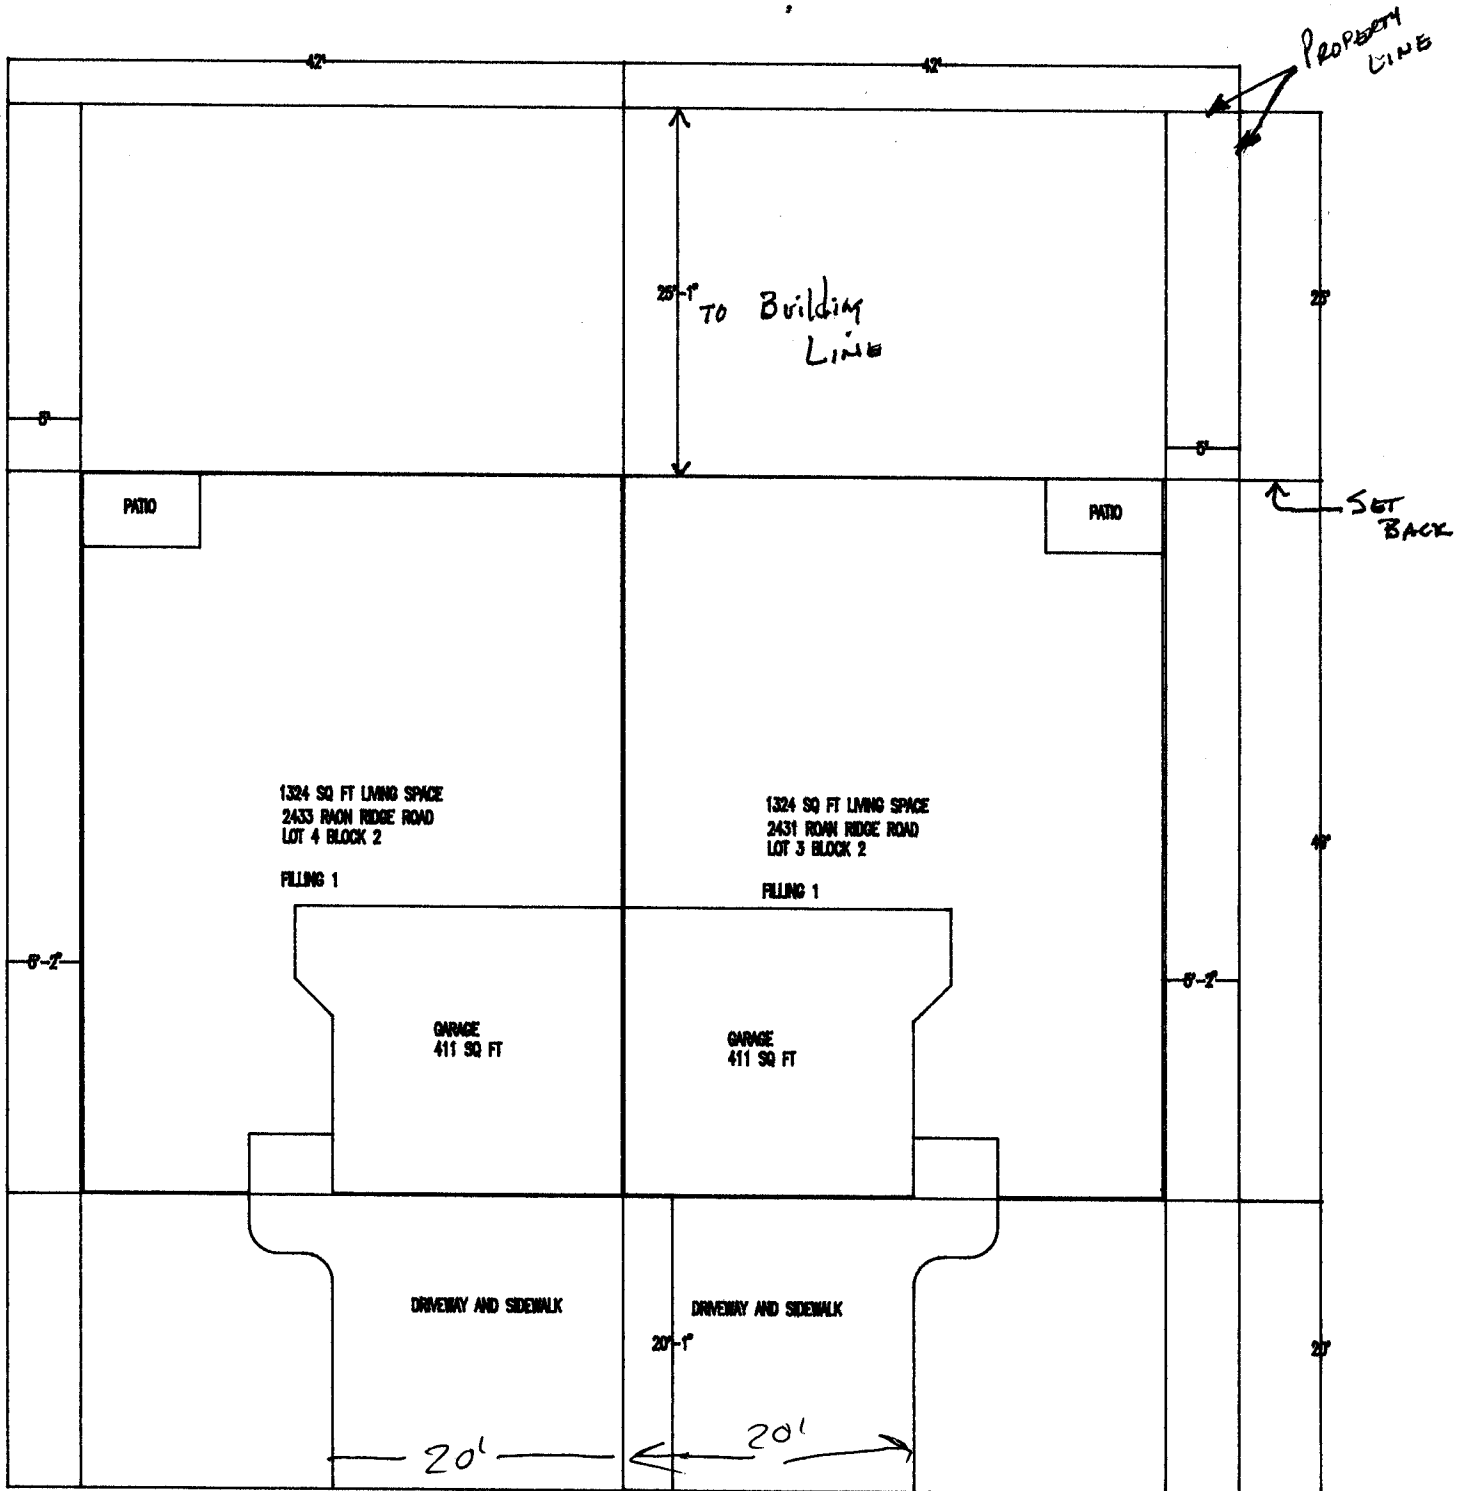

ROAN RIDGE ROAD

