

FEE \$	10.00
TCP \$	500.00
SIF \$	292.00

PLANNING CLEARANCE

(Single Family Residential and Accessory Structures)
Community Development Department

BLDG PERMIT NO. 83117



Your Bridge to a Better Community

BLDG ADDRESS 3716 SKYLER SQ. FT. OF PROPOSED BLDGS/ADDITION _____

TAX SCHEDULE NO 2943-191-20-010 SQ. FT. OF EXISTING BLDGS Ø

SUBDIVISION SKYLER TOTAL SQ. FT. OF EXISTING & PROPOSED _____

FILING 1 BLK 4 LOT 10 NO. OF DWELLING UNITS:
 Before: Ø After: 1 this Construction

(1) OWNER Grand Ridge Properties NO. OF BUILDINGS ON PARCEL
 Before: Ø After: 1 this Construction

(1) ADDRESS 3032 I-70 BUS LOOP USE OF EXISTING BUILDINGS N/A

(1) TELEPHONE 434-4616 DESCRIPTION OF WORK & INTENDED USE single family residence

(2) APPLICANT Great Services TYPE OF HOME PROPOSED:
 Site Built _____ Manufactured Home (UBC)
 _____ Manufactured Home (HUD)
 _____ Other (please specify) _____

(2) ADDRESS 3032 I-70 BUS LOOP

(2) TELEPHONE 434-4616

REQUIRED: One plot plan, on 8 1/2" x 11" paper, showing all existing & proposed structure location(s), parking, setbacks to all property lines, ingress/egress to the property, driveway location & width & all easements & rights-of-way which abut the parcel.

THIS SECTION TO BE COMPLETED BY COMMUNITY DEVELOPMENT DEPARTMENT STAFF

ZONE PO Maximum coverage of lot by structures 35%

SETBACKS: Front 20' from property line (PL) Permanent Foundation Required: YES NO _____
 or _____ from center of ROW, whichever is greater

Side 7.5' from PL, Rear 20' from PL Parking Req'mt 2

Maximum Height 32' Special Conditions _____

CENSUS 8 TRAFFIC 60 ANN# _____

Modifications to this Planning Clearance must be approved, in writing, by the Community Development Department. The structure authorized by this application cannot be occupied until a final inspection has been completed and a Certificate of Occupancy has been issued, if applicable, by the Building Department (Section 305, Uniform Building Code).

I hereby acknowledge that I have read this application and the information is correct; I agree to comply with any and all codes, ordinances, laws, regulations or restrictions which apply to the project. I understand that failure to comply shall result in legal action, which may include but not necessarily be limited to non-use of the building(s).

Applicant Signature [Signature] Date 1-31-02


Department Approval [Signature] Date 2/14/02

Additional water and/or sewer tap fee(s) are required:	<input checked="" type="checkbox"/> YES	NO	W/O No. <u>pd 60975</u>
Utility Accounting	<u>[Signature]</u>	Date	<u>2-14-02</u>

VALID FOR SIX MONTHS FROM DATE OF ISSUANCE (Section 2.2.C.1.c(1) Grand Junction Zoning & Development Code)

(White: Planning) (Yellow: Customer) (Pink: Building Department) (Goldenrod: Utility Accounting)

Drive OK
2/14/02

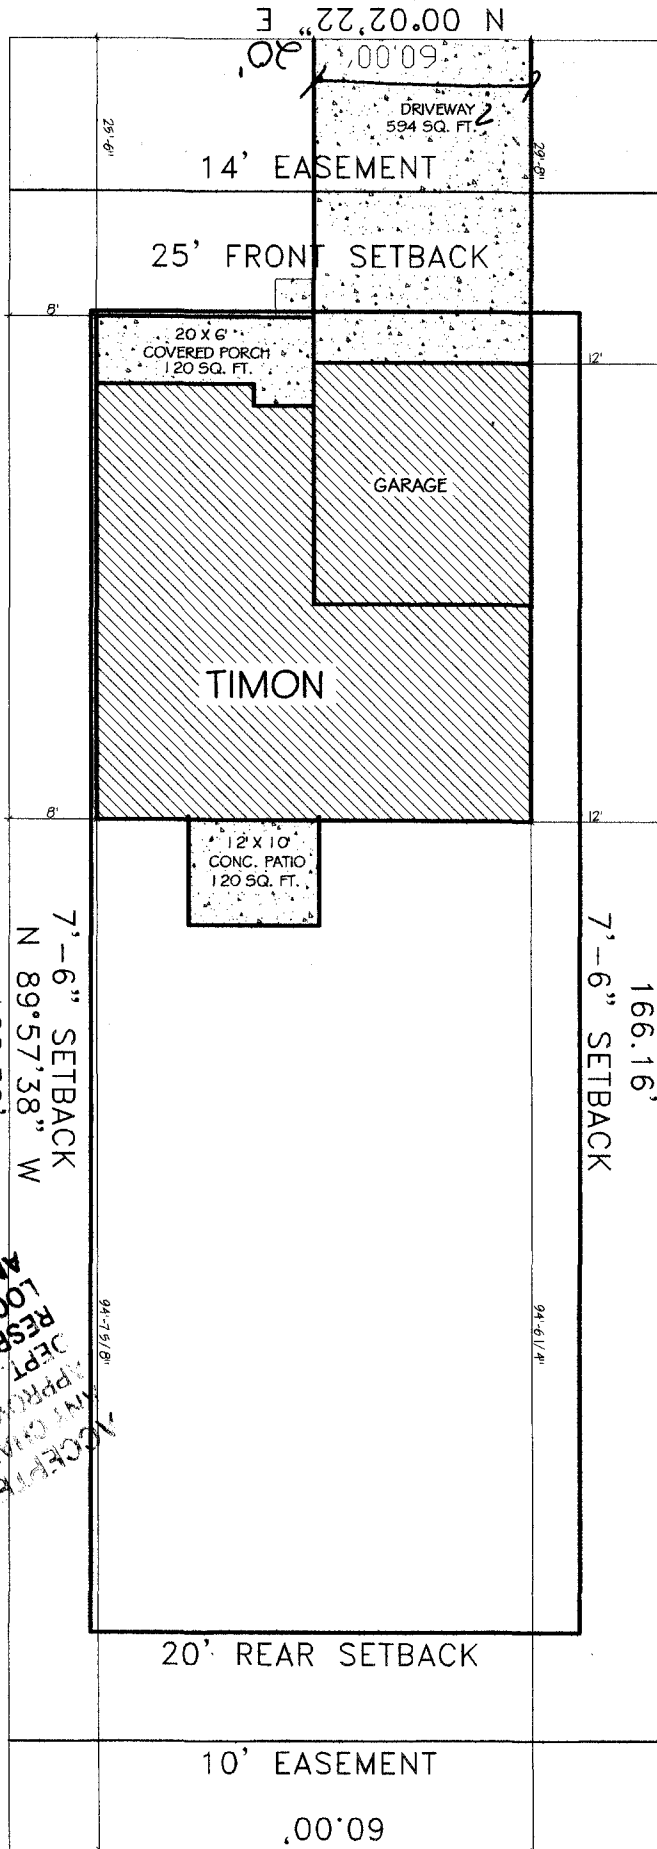


ACCEPTED
ANY CHANGE OR SETBACKS MUST BE
APPROVED BY THE CITY PLANNING
DEPT. IT IS THE APPLICANTS
RESPONSIBILITY TO PROPERLY
LOCATE AND IDENTIFY EASEMENTS
AND PROPERTY LINES

City Planner
C. H. [Signature]

376 Skyler

**Geotechnical
Engineering
Group, Inc.**

February 12, 2002

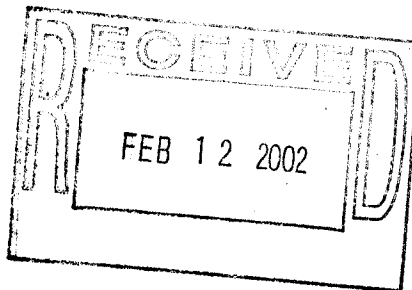**Great New Homes
3032 I-70 Business Loop
Grand Junction, CO 81504****Attention: Mr. Jim Campbell****Subject: Excavation Observation
376 Skyler Street
Lot 10, Skyler Subdivision, Block 4
Grand Junction, Colorado
Job No. 799**

As requested, a Geotechnical Engineering Group, Inc. representative visited the site and observed the open foundation excavation 3 times on February 7, 8 and 11, 2002. Soils found in the excavation appeared to be consistent with those identified by the "Subsurface Soils Exploration, Skyler Subdivision, Grand Junction, Colorado" dated January 31, 2000, prepared by Grand Junction Lincoln DeVore, Inc. (their Job No. 87839-GJ). We observed the completed excavation prior to fill placement and a proof roll, made by an IH 530 loader with a full bucket revealed no significant yielding of the completed subgrade and two 12-inch thickness lift of structural fill. We believe the foundation soils are suitable to support a shallow foundation system with a maximum bearing pressure of 1,400 psf as described in the referenced report. We understand turned down slab foundations are proposed for the residence and foundation plans have been reviewed by Mesa County Building Department. In our opinion, turned down slab foundations designed and constructed to meet or exceed Mesa County Minimum House Foundation Standards and the referenced report will be suitable for the residence. This opinion is based on observation of the completed excavation and proof roll and testing of the fill for the proposed foundation subgrade.

We appreciate the opportunity to provide geotechnical services. When we can be of further service, please call.

Sincerely,
GEOTECHNICAL ENGINEERING GROUP, INC.

A handwritten signature in black ink, appearing to be "JPW".

John P. Withers, P.E.
Principal Engineer



JPW:mk
(1 copy faxed)

Geotechnical, Environmental and Materials Testing Consultants

(970) 245-4078 • fax (970) 245-7115

686 West Gunnison Ave., Suite 110, Grand Junction, Colorado 81505