

FEE \$	10.00
TCP \$	0
SIF \$	292.00

PLANNING CLEARANCE
(Single Family Residential and Accessory Structures)
Community Development Department

BLDG PERMIT NO. 87007



Your Bridge to a Better Community

BLDG ADDRESS 658 Springbrook Dr SQ. FT. OF PROPOSED BLDGS/ADDITION 1151 garage 389
 TAX SCHEDULE NO 2943-051-70-002 SQ. FT. OF EXISTING BLDGS _____
 SUBDIVISION Brookside TOTAL SQ. FT. OF EXISTING & PROPOSED _____
 FILING 3 BLK 3 LOT 2 NO. OF DWELLING UNITS:
 Before: 0 After: 1 this Construction
 (1) OWNER Darter, LLC NO. OF BUILDINGS ON PARCEL
 Before: 0 After: 1 this Construction
 (1) ADDRESS 7810 Valley Ct USE OF EXISTING BUILDINGS _____
 (1) TELEPHONE 523-5555 DESCRIPTION OF WORK & INTENDED USE New Home
 (2) APPLICANT Grace Homes TYPE OF HOME PROPOSED:
 (2) ADDRESS 7810 Valley Ct Site Built _____ Manufactured Home (UBC)
 (2) TELEPHONE 523-5555 _____ Manufactured Home (HUD)
 _____ Other (please specify) _____

REQUIRED: One plot plan, on 8 1/2" x 11" paper, showing all existing & proposed structure location(s), parking, setbacks to all property lines, ingress/egress to the property, driveway location & width & all easements & rights-of-way which abut the parcel.

THIS SECTION TO BE COMPLETED BY COMMUNITY DEVELOPMENT DEPARTMENT STAFF

ZONE PD Maximum coverage of lot by structures 35%
 SETBACKS: Front 20' from property line (PL) Permanent Foundation Required: YES NO _____
 or _____ from center of ROW, whichever is greater
 Side 0'/5' from PL, Rear 20' from PL Parking Req'mt 2
 Maximum Height 32' Special Conditions covenants may require engineered foundation
 CENSUS 11 TRAFFIC 45 ANN# _____

Modifications to this Planning Clearance must be approved, in writing, by the Community Development Department. The structure authorized by this application cannot be occupied until a final inspection has been completed and a Certificate of Occupancy has been issued, if applicable, by the Building Department (Section 305, Uniform Building Code).



I hereby acknowledge that I have read this application and the information is correct; I agree to comply with any and all codes, ordinances, laws, regulations or restrictions which apply to the project. I understand that failure to comply shall result in legal action, which may include but not necessarily be limited to non-use of the building(s).

Applicant Signature Monica Pata Date 11-12-02
 Department Approval H. Gayleen Henderson Date 11-12-02


Additional water and/or sewer tap fee(s) are required:	YES _____	NO _____	W/O No. <u>15470</u>
Utility Accounting	<u>Manuel Cal</u>		Date <u>11/12/02</u>

VALID FOR SIX MONTHS FROM DATE OF ISSUANCE (Section 9-3-2C Grand Junction Zoning & Development Code)

(White: Planning) (Yellow: Customer) (Pink: Building Department) (Goldenrod: Utility Accounting)

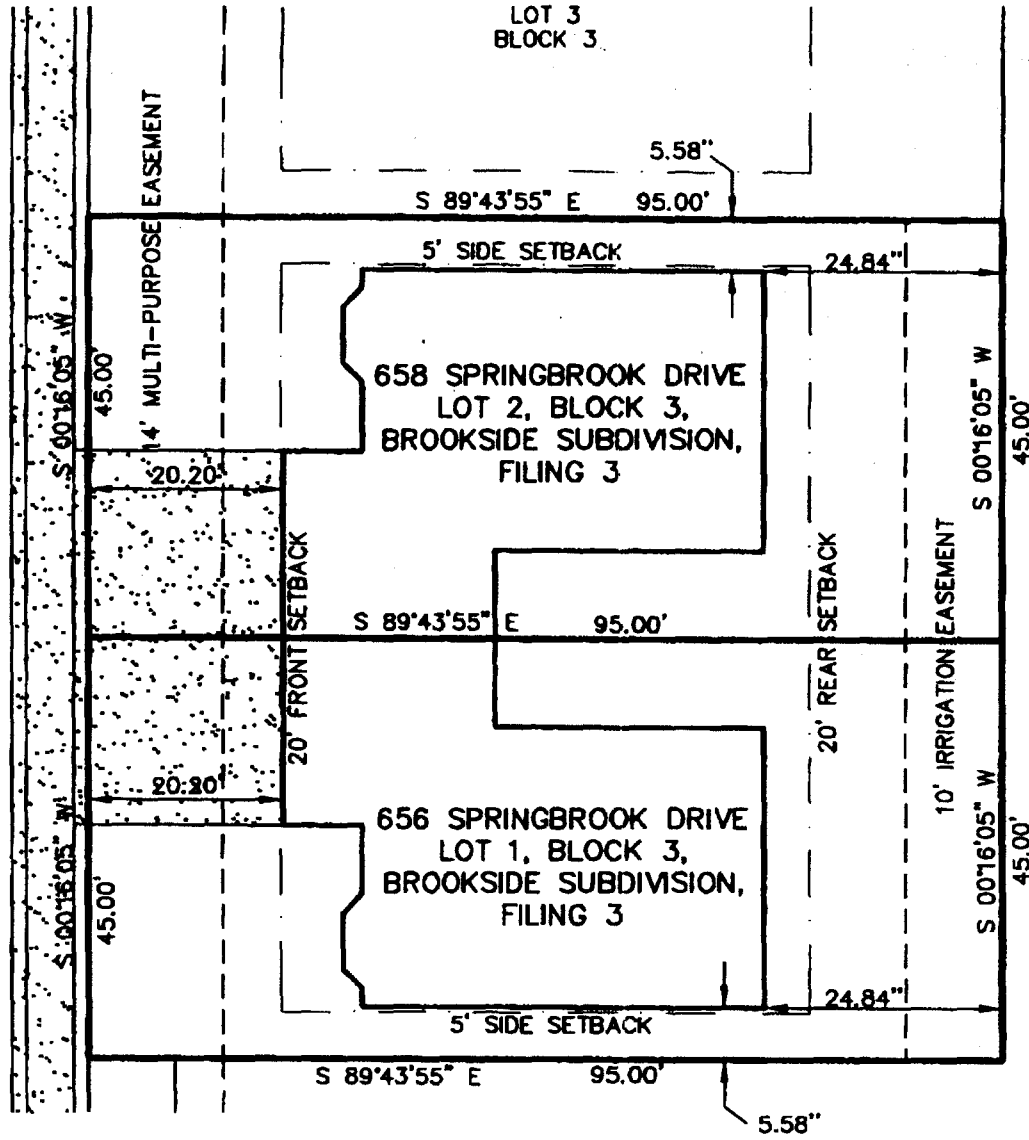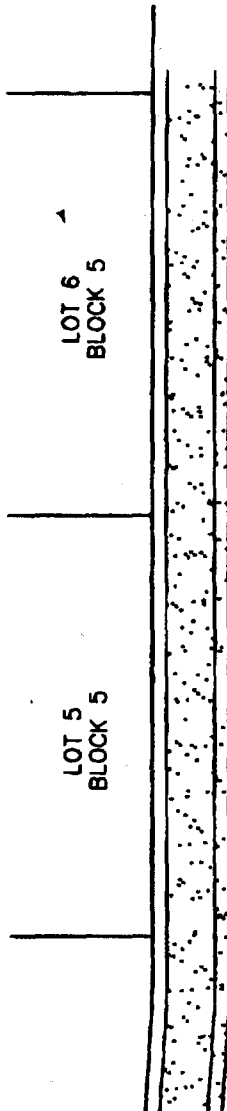

11-12-02 *Gayle Anderson*
 ACCEPTED SETBACKS MUST BE
 CITY PLANNING
 APPLICANTS
 TO PROPERLY
 LOCATE AND IDENTIFY EASEMENTS
 AND PROPERTY LINES.

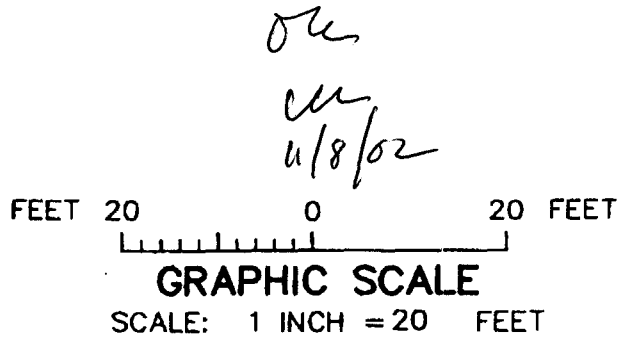

DATE: 11-07-02
 JOB NO. 4018.04-01