

FEE \$	10.00
TCP \$	0
SIF \$	292.00

PLANNING CLEARANCE
 (Single Family Residential and Accessory Structures)
Community Development Department

BLDG PERMIT NO. 82713



Your Bridge to a Better Community

BLDG ADDRESS 653 Starlight SQ. FT. OF PROPOSED BLDGS/ADDITION 1311
 TAX SCHEDULE NO. 2943-042-67-005 SQ. FT. OF EXISTING BLDGS 0
 SUBDIVISION Faircloud TOTAL SQ. FT. OF EXISTING & PROPOSED 1311
 FILING 3 BLK 2 LOT 5 NO. OF DWELLING UNITS:
 Before: 0 After: 1 this Construction
 (1) OWNER Grand Ridge Properties NO. OF BUILDINGS ON PARCEL
 Before: 0 After: 1 this Construction
 (1) ADDRESS 3032 1-70 Bus. Loop USE OF EXISTING BUILDINGS N/A
 (1) TELEPHONE 434-4616 DESCRIPTION OF WORK & INTENDED USE Single Family Residence
 (2) APPLICANT Great Services TYPE OF HOME PROPOSED:
 (2) ADDRESS 3032 1-70 Bus. Loop Site Built Manufactured Home (UBC)
 (2) TELEPHONE 434-4616 Manufactured Home (HUD) Other (please specify) TB

REQUIRED: One plot plan, on 8 1/2" x 11" paper, showing all existing & proposed structure location(s), parking, setbacks to all property lines, ingress/egress to the property, driveway location & width & all easements & rights-of-way which abut the parcel.

THIS SECTION TO BE COMPLETED BY COMMUNITY DEVELOPMENT DEPARTMENT STAFF

ZONE RD Maximum coverage of lot by structures 35%
 SETBACKS: Front 23' from property line (PL) Permanent Foundation Required: YES NO
 or from center of ROW, whichever is greater
 Side 5' from PL, Rear 25' from PL Parking Req'mt 2
 Maximum Height 32' Special Conditions Geotechnical letter needed
 CENSUS 11 TRAFFIC 46 ANNEX#

Modifications to this Planning Clearance must be approved, in writing, by the Community Development Department. The structure authorized by this application cannot be occupied until a final inspection has been completed and a Certificate of Occupancy has been issued, if applicable, by the Building Department (Section 305, Uniform Building Code).

I hereby acknowledge that I have read this application and the information is correct; I agree to comply with any and all codes, ordinances, laws, regulations or restrictions which apply to the project. I understand that failure to comply shall result in legal action, which may include but not necessarily be limited to non-use of the building(s).

Applicant Signature [Signature] Date 12-21-01
 Department Approval [Signature] Date 11/7/02


Additional water and/or sewer tap fee(s) are required:	YES <input checked="" type="checkbox"/>	NO	W/O No. <u>13275</u>
Utility Accounting	<u>[Signature]</u>	Date	<u>11/7/02</u>

VALID FOR SIX MONTHS FROM DATE OF ISSUANCE (Section 9-3-2C Grand Junction Zoning & Development Code)

(White: Planning) (Yellow: Customer) (Pink: Building Department) (Goldenrod: Utility Accounting)

ACCEPTED *C. Faye Gibson* 11/7/02
 ANY CHANGE OF SETBACKS MUST BE APPROVED BY THE CITY PLANNING DEPT. IT IS THE APPLICANT'S RESPONSIBILITY TO PROPERLY LOCATE AND IDENTIFY EASEMENTS AND PROPERTY LINES

Sunlight Drive

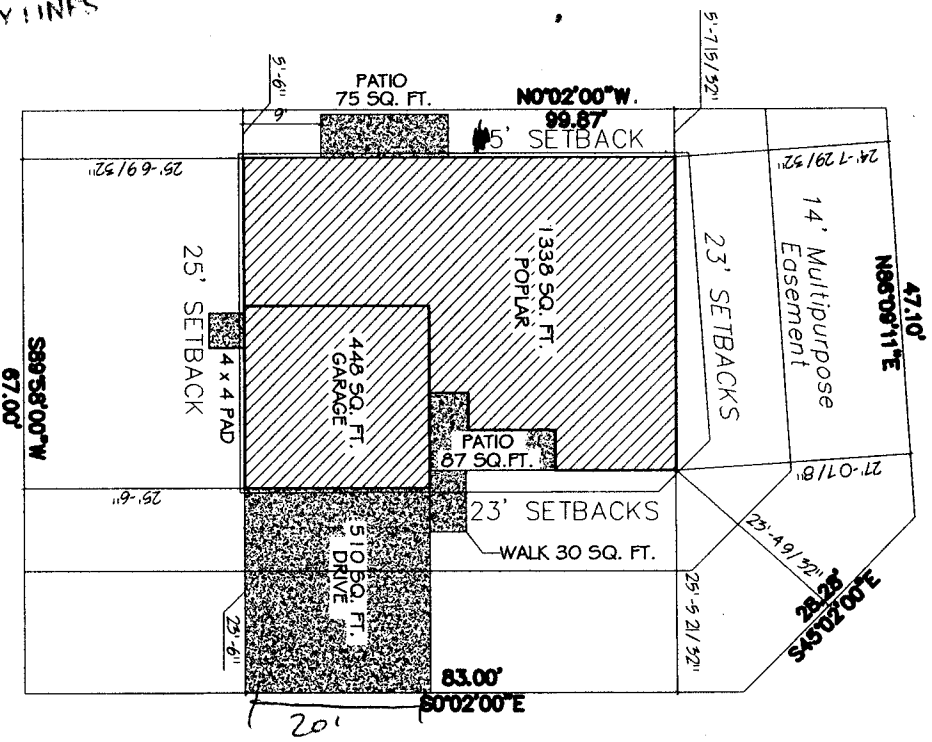

Starlight Drive



LOT 5
 0.2 Acres.
 6627.4 Sq. ft.

DRIVE OK
DML
1/7/02

PLOT PLAN

SCALE: 1" = 10'

COPYRIGHT © 2001

SHEETS 2 of 7 SHEET 2	DRAWN BY WILLIAM BELL DATE: 05 DEC 01	MODEL: POPLAR ADDRESS: 653 STARLIGHT DR. ACAD File Name: 11901-02.DWG	GREAT NEW HOMES 3032 I-70 BUSINESS LOOP GRAND JCT. COLO. 81504
-----------------------------	--	--	---

**Geotechnical
Engineering
Group, Inc.**

January 7, 2002

DRAFT

Great New Homes
3032 I-70 Business Loop
Grand Junction, CO 81504

Attention: Mr. Pat Mullinnex

Subject: Excavation Observation
653 Starlight Drive
Lot 5, Faircloud Subdivision, Filing No. 3, Block 2
Grand Junction, Colorado
Job No. 800

As requested, a Geotechnical Engineering Group, Inc. representative visited the site and observed the open foundation excavation on January 4 + 7, 2002. Soils found in the excavation appeared to be consistent with those identified by the "Geotechnical Investigation For Faircloud Subdivision, Situated In The W $\frac{1}{2}$, SW $\frac{1}{4}$, NW $\frac{1}{4}$ Section 4, T1S, R1E, Ute Meridian, Mesa County, Colorado" dated September 19, 1997 by Western Colorado Testing, Inc. (their Job No. 207597). We observed the completed excavation and a proof roll, made by a CAT 416B BACKHOE that revealed no significant yielding on the area observed. We believe the foundation soils are suitable to support a shallow foundation system with a maximum bearing pressure of 1,000 psf as described in the referenced report. We understand spread footing foundations are proposed for the residence and foundation plans have been reviewed by Mesa County Building Department. In our opinion, spread footing foundations designed and constructed to meet or exceed Mesa County Minimum House Foundation Standards and the referenced report will be suitable for the residence. This opinion is based on observation of the completed excavation and proof roll of the proposed foundation subgrade.

We appreciate the opportunity to provide geotechnical services. When we can be of further service, please call.

Sincerely,
GEOTECHNICAL ENGINEERING GROUP, INC.

John P. Withers

John P. Withers, P.E.
Principal Engineer

Engineering Technician

JPW:mk
(1 copy faxed)

Geotechnical, Environmental and Materials Testing Consultants

(970) 245-4078 • fax (970) 245-7115
685 West Gunnison Ave., Suite 110, Grand Junction, Colorado 81505

292
5/7/02