

FEE \$	10.00
TCP \$	0
SIF \$	292.00

**PLANNING CLEARANCE**  
 (Single Family Residential and Accessory Structures)  
**Community Development Department**

BLDG PERMIT NO. 87612



Your Bridge to a Better Community

BLDG ADDRESS 2979 Summerbrook SQ. FT. OF PROPOSED BLDGS/ADDITION 1553 garage 445  
 TAX SCHEDULE NO. 2943-051-73-014 SQ. FT. OF EXISTING BLDGS \_\_\_\_\_  
 SUBDIVISION Brookside TOTAL SQ. FT. OF EXISTING & PROPOSED 1996  
 FILING 3 BLK 2 LOT 3 NO. OF DWELLING UNITS:  
 Before: 0 After: 1 this Construction  
 (1) OWNER Darter, LLC NO. OF BUILDINGS ON PARCEL  
 Before: 0 After: 1 this Construction  
 (1) ADDRESS 7816 Valley Ct. USE OF EXISTING BUILDINGS \_\_\_\_\_  
 (1) TELEPHONE 523-5555 DESCRIPTION OF WORK & INTENDED USE New Home  
 (2) APPLICANT Grace Homes TYPE OF HOME PROPOSED:  
 (2) ADDRESS 7816 Valley Ct  Site Built \_\_\_\_\_ Manufactured Home (UBC)  
 \_\_\_\_\_ Manufactured Home (HUD)  
 (2) TELEPHONE 523-5555 \_\_\_\_\_ Other (please specify) \_\_\_\_\_

**REQUIRED: One plot plan, on 8 1/2" x 11" paper, showing all existing & proposed structure location(s), parking, setbacks to all property lines, ingress/egress to the property, driveway location & width & all easements & rights-of-way which abut the parcel.**

**THIS SECTION TO BE COMPLETED BY COMMUNITY DEVELOPMENT DEPARTMENT STAFF**

ZONE PD Maximum coverage of lot by structures 35%  
 SETBACKS: Front 20' from property line (PL) Permanent Foundation Required: YES  NO \_\_\_\_\_  
 or \_\_\_\_\_ from center of ROW, whichever is greater  
 Side 5' from PL, Rear 20' from PL Parking Req'mt 2  
 Maximum Height 32' Special Conditions \_\_\_\_\_  
 CENSUS 11 TRAFFIC 45 ANN# \_\_\_\_\_

Modifications to this Planning Clearance must be approved, in writing, by the Community Development Department. The structure authorized by this application cannot be occupied until a final inspection has been completed and a Certificate of Occupancy has been issued, if applicable, by the Building Department (Section 305, Uniform Building Code).


I hereby acknowledge that I have read this application and the information is correct; I agree to comply with any and all codes, ordinances, laws, regulations or restrictions which apply to the project. I understand that failure to comply shall result in legal action, which may include but not necessarily be limited to non-use of the building(s).

Applicant Signature Monica Kuta Date 12/17/02  
 Department Approval T.C. Jaye Gibson Date 12/31/02

Additional water and/or sewer tap fee(s) are required:	YES <input checked="" type="checkbox"/>	NO	W/O No. <u>15598</u>
Utility Accounting <u>Tracy Shifer</u>		Date	<u>12/31/02</u>

VALID FOR SIX MONTHS FROM DATE OF ISSUANCE (Section 9-3-2C Grand Junction Zoning & Development Code)

(White: Planning) (Yellow: Customer) (Pink: Building Department) (Goldenrod: Utility Accounting)

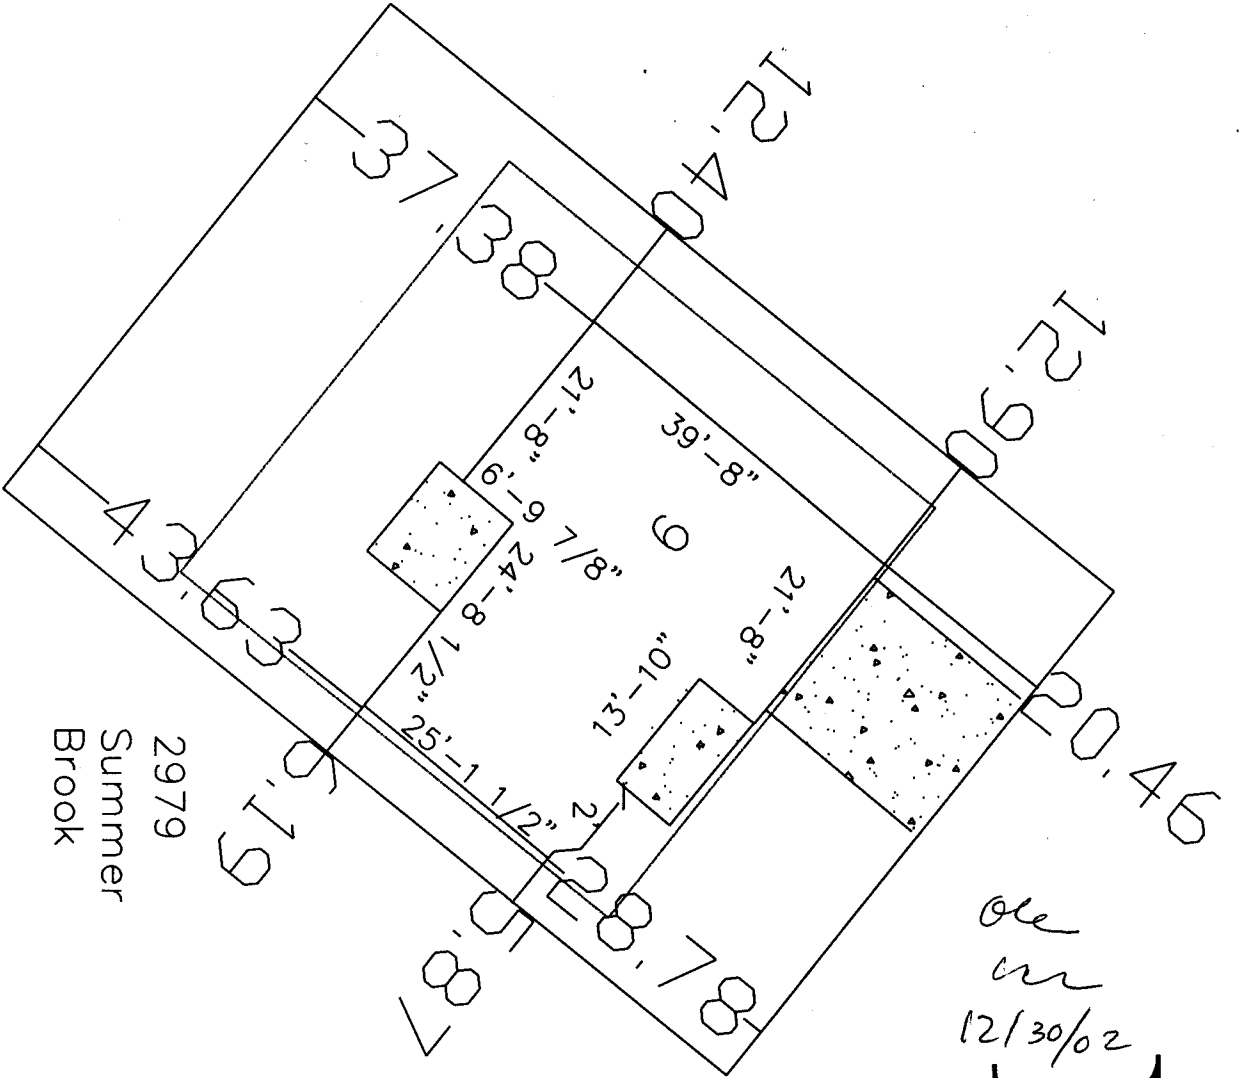

2979  
 Summer  
 Brook  
 Lot 3 Block 2  
 Scale 1=20  
 12-26-02

*ole*  
*cr*  
 12/30/02

**N**



12/31/02  
*C. Faye Gibson*  
**ACCEPTED**  
 ANY CHANGE OF SETBACKS MUST BE APPROVED BY THE CITY PLANNING DEPT. IT IS THE APPLICANT'S RESPONSIBILITY TO PROPERLY LOCATE AND IDENTIFY EASEMENTS AND PROPERTY LINES