

FEE \$	10.00
TCP \$	0
SIF \$	292.00

PLANNING CLEARANCE
 (Single Family Residential and Accessory Structures)
Community Development Department

BLDG PERMIT NO. 86599



Your Bridge to a Better Community

BLDG ADDRESS 2058 B Summercrest CR SQ. FT. OF PROPOSED BLDGS/ADDITION 2150

TAX SCHEDULE NO. 2701-261-31-009 SQ. FT. OF EXISTING BLDGS 0

SUBDIVISION Summerhill TOTAL SQ. FT. OF EXISTING & PROPOSED 2150

FILING 1 BLK 2 LOT 9 NO. OF DWELLING UNITS:
 Before: 0 After: 1 this Construction

(1) OWNER LD Investment NO. OF BUILDINGS ON PARCEL
 Before: 0 After: 1 this Construction

(1) ADDRESS P.O. Box 1925 USE OF EXISTING BUILDINGS SF-Attached

(1) TELEPHONE 243-6471 DESCRIPTION OF WORK & INTENDED USE NEW CONSTR

(2) APPLICANT LD Construction TYPE OF HOME PROPOSED:
 Site Built Manufactured Home (UBC)
 Manufactured Home (HUD)
 Other (please specify) _____

(2) ADDRESS P.O. Box 1925

(2) TELEPHONE 243-6471

REQUIRED: One plot plan, on 8 1/2" x 11" paper, showing all existing & proposed structure location(s), parking, setbacks to all property lines, ingress/egress to the property, driveway location & width & all easements & rights-of-way which abut the parcel.

THIS SECTION TO BE COMPLETED BY COMMUNITY DEVELOPMENT DEPARTMENT STAFF

ZONE PR 2.5 Maximum coverage of lot by structures 50%

SETBACKS: Front 20' from property line (PL) Permanent Foundation Required: YES X NO _____
 or _____ from center of ROW, whichever is greater

Side 7' from PL, Rear 15' from PL Parking Req'mt 2

Maximum Height 32' Special Conditions _____

CENSUS 16 TRAFFIC 13 ANN# _____

Modifications to this Planning Clearance must be approved, in writing, by the Community Development Department. The structure authorized by this application cannot be occupied until a final inspection has been completed and a Certificate of Occupancy has been issued, if applicable, by the Building Department (Section 305, Uniform Building Code).

I hereby acknowledge that I have read this application and the information is correct; I agree to comply with any and all codes, ordinances, laws, regulations or restrictions which apply to the project. I understand that failure to comply shall result in legal action, which may include but not necessarily be limited to non-use of the building(s).

Applicant Signature [Signature] Date 9-18-2002


Department Approval [Signature] Date 10/8/02

Additional water and/or sewer tap fee(s) are required:	YES <input checked="" type="checkbox"/>	NO <input type="checkbox"/>	W/O No. <u>15367</u>
Utility Accounting	<u>[Signature]</u>		Date <u>10/8/02</u>

VALID FOR SIX MONTHS FROM DATE OF ISSUANCE (Section 9-3-2C Grand Junction Zoning & Development Code)

(White: Planning) (Yellow: Customer) (Pink: Building Department) (Goldenrod: Utility Accounting)

BLOCK 2
LOT 9.
4,585 SQ. FT.

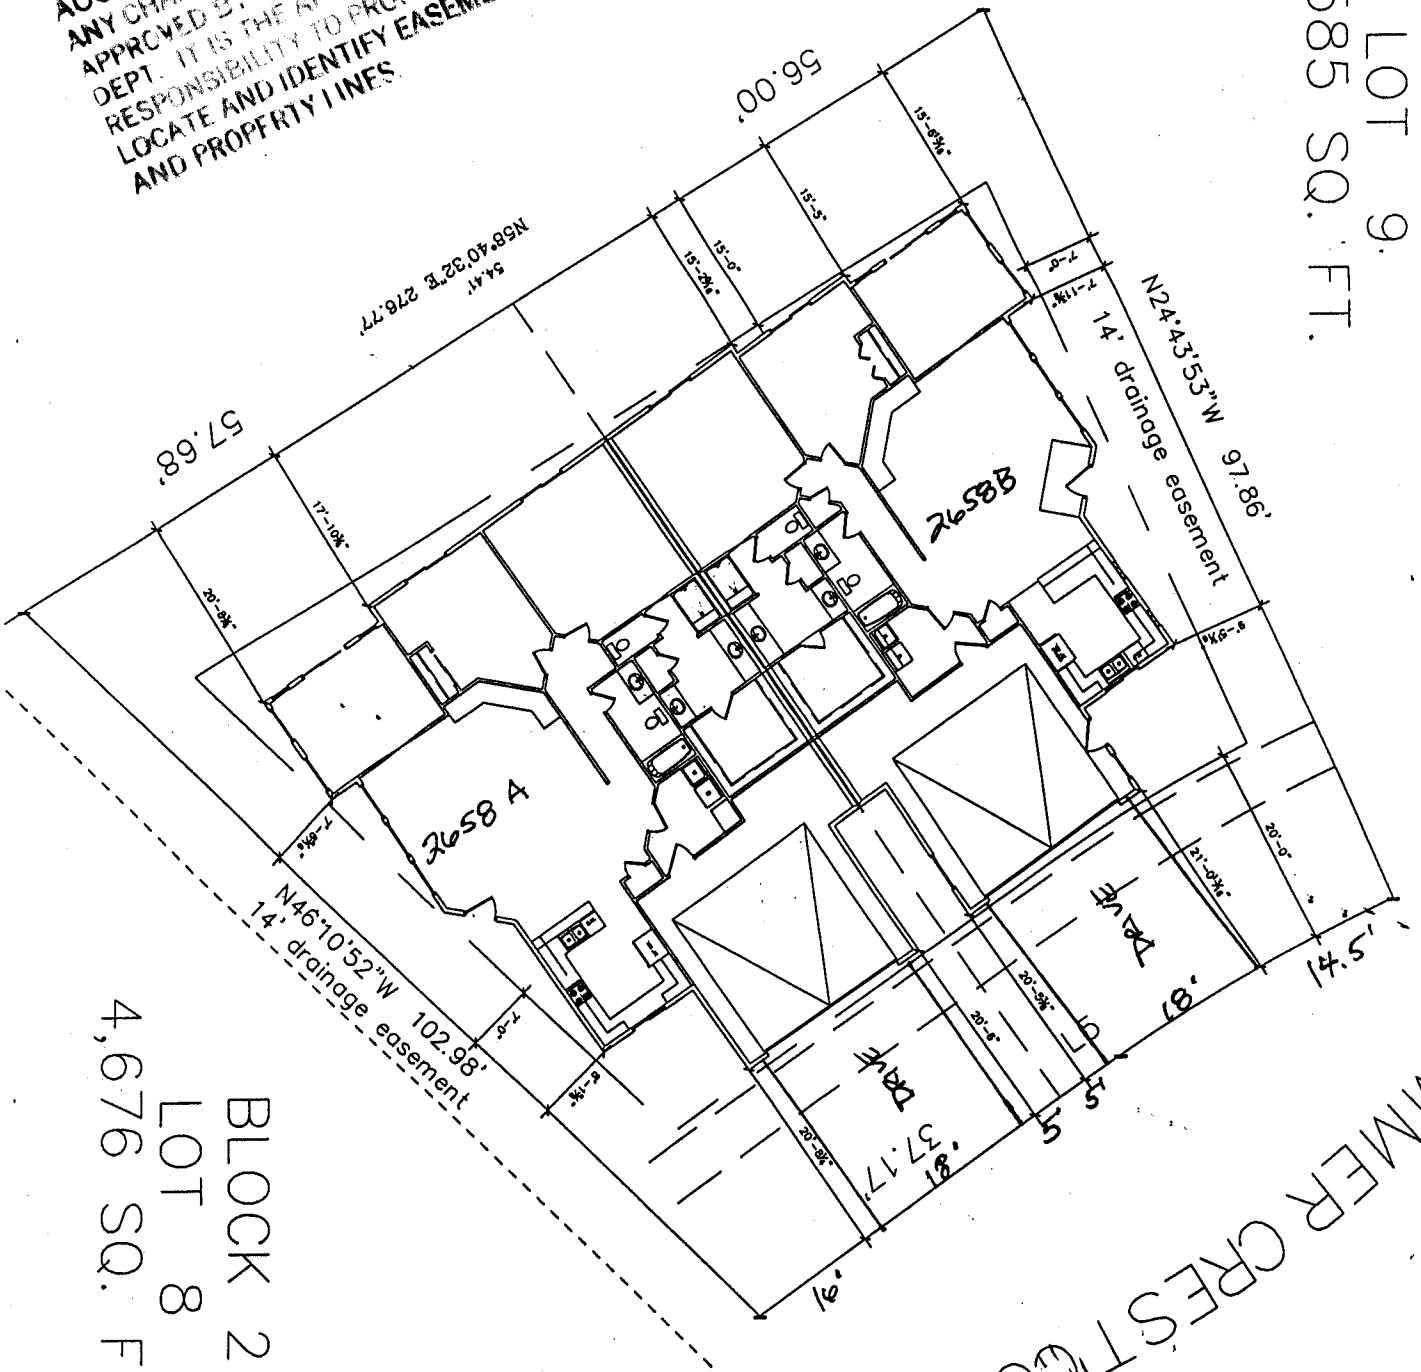

10/8/02
ACCEPTED *John Wilson*
ANY CHANGE OF SETBACKS MUST BE
APPROVED BY THE CITY PLANNING
DEPT. IT IS THE APPLICANT'S
RESPONSIBILITY TO PROPERLY
LOCATE AND IDENTIFY EASEMENTS
AND PROPERTY LINES.

BLOCK 2
LOT 8
4,676 SQ. FT.

all
OK
9/20/02
SUMMER CREST COURT