

FEE \$	10.00
TCP \$	0
SIF \$	292.00

PLANNING CLEARANCE
(Single Family Residential and Accessory Structures)
Community Development Department

BLDG PERMIT NO. 84691



Your Bridge to a Better Community

BLDG ADDRESS 474 North Sun Ct. SQ. FT. OF PROPOSED BLDGS/ADDITION 1611

TAX SCHEDULE NO. 2943-161-97-012 SQ. FT. OF EXISTING BLDGS 0

SUBDIVISION Fruitvale Meadows TOTAL SQ. FT. OF EXISTING & PROPOSED 1611

FILING 2 BLK 1 LOT 12 NO. OF DWELLING UNITS:
Before: 0 After: 1 this Construction

(1) OWNER Joy Scigliano NO. OF BUILDINGS ON PARCEL
Before: 0 After: 1 this Construction

(1) ADDRESS 3247 1/2 White Ave. #1 #1520 USE OF EXISTING BUILDINGS N/A

(1) TELEPHONE 241-2871 ext 2A Messgr DESCRIPTION OF WORK & INTENDED USE New Single Family

(2) APPLICANT SAME TYPE OF HOME PROPOSED:
 Site Built Manufactured Home (UBC)
 Manufactured Home (HUD)
 Other (please specify) _____

(2) ADDRESS _____

(2) TELEPHONE _____

REQUIRED: One plot plan, on 8 1/2" x 11" paper, showing all existing & proposed structure location(s), parking, setbacks to all property lines, ingress/egress to the property, driveway location & width & all easements & rights-of-way which abut the parcel.

THIS SECTION TO BE COMPLETED BY COMMUNITY DEVELOPMENT DEPARTMENT STAFF

ZONE RMF-5 Maximum coverage of lot by structures 60%

SETBACKS: Front 20/25 from property line (PL) Permanent Foundation Required: YES NO
or _____ from center of ROW, whichever is greater

Side 5/3 from PL, Rear 25/5 from PL Parking Req'mt 2

Maximum Height 35' Special Conditions _____

CENSUS 8 TRAFFIC 57 ANN# _____

Modifications to this Planning Clearance must be approved, in writing, by the Community Development Department. The structure authorized by this application cannot be occupied until a final inspection has been completed and a Certificate of Occupancy has been issued, if applicable, by the Building Department (Section 305, Uniform Building Code).

I hereby acknowledge that I have read this application and the information is correct; I agree to comply with any and all codes, ordinances, laws, regulations or restrictions which apply to the project. I understand that failure to comply shall result in legal action, which may include but not necessarily be limited to non-use of the building(s).


Applicant Signature [Signature] Date 5/22/02

Department Approval [Signature] Date 6-4-02

Additional water and/or sewer tap fee(s) are required:	YES <input checked="" type="checkbox"/>	NO <input type="checkbox"/>	W/O No. <u>14986</u>
Utility Accounting	<u>[Signature]</u>		Date _____

VALID FOR SIX MONTHS FROM DATE OF ISSUANCE (Section 9-3-2C Grand Junction Zoning & Development Code)

(White: Planning) (Yellow: Customer) (Pink: Building Department) (Goldenrod: Utility Accounting)

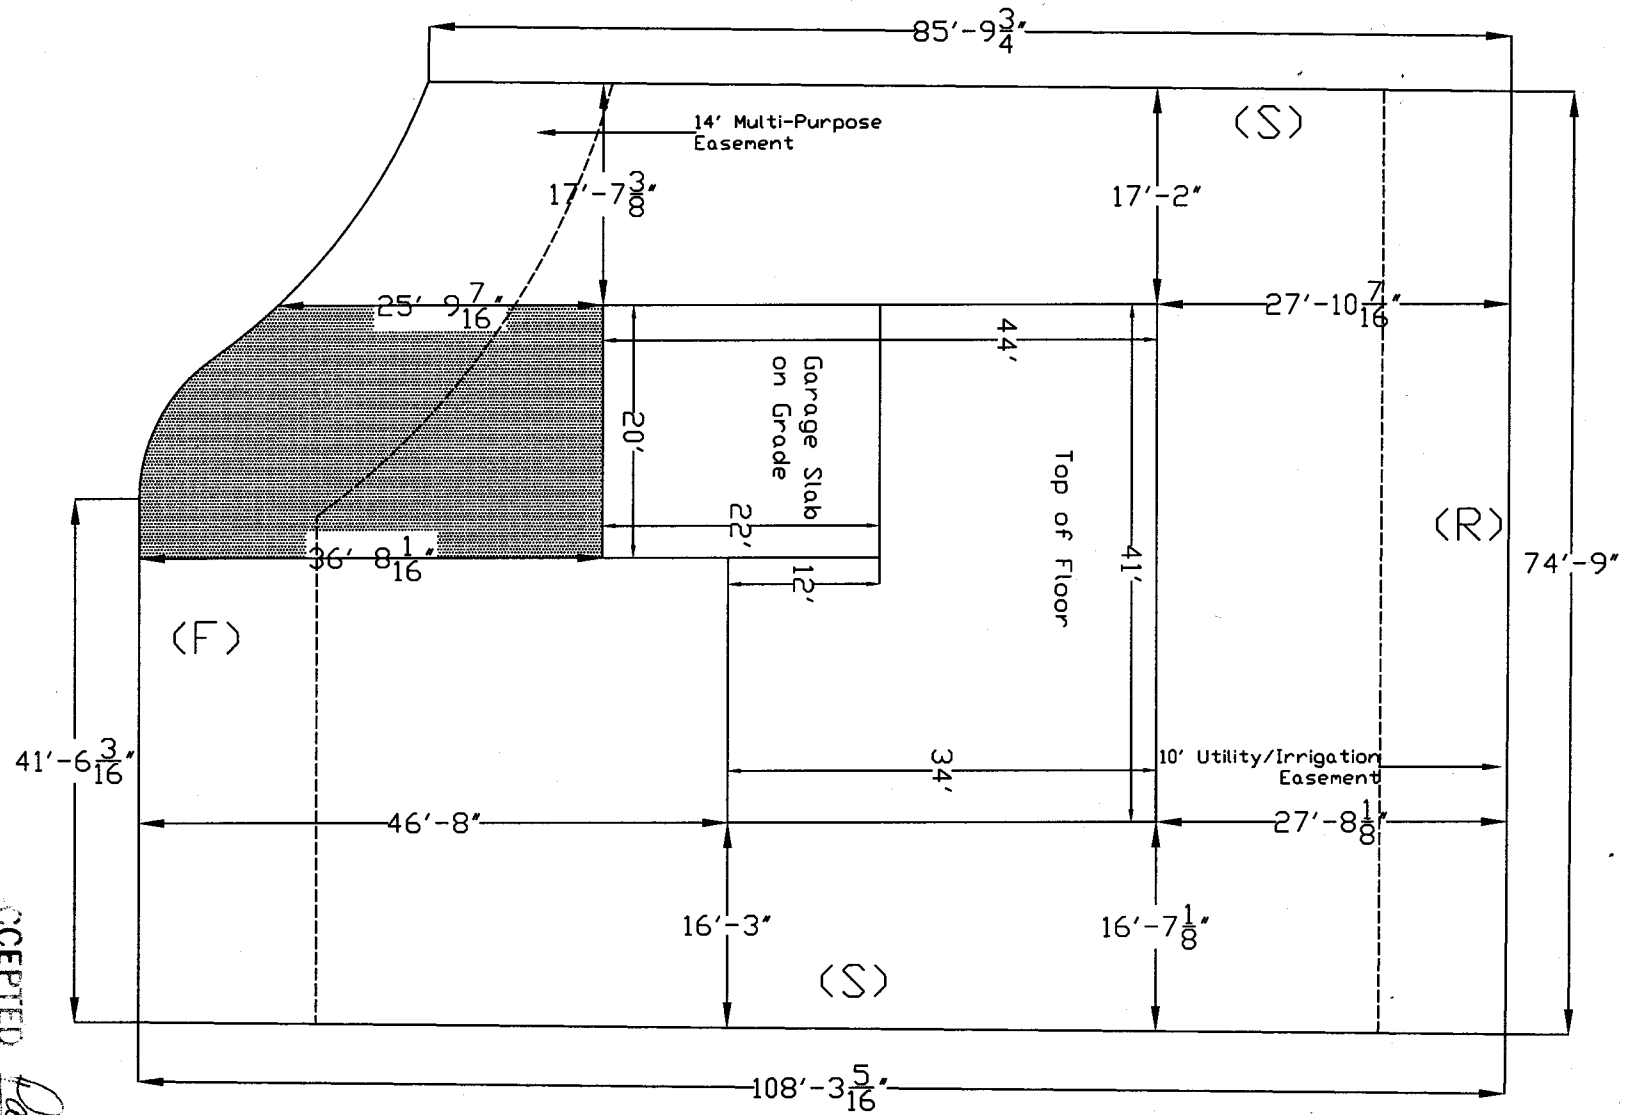

ACCEPTED *Pat Budman*
 ANY CHANGE OF SETBACKS MUST BE
 APPROVED BY THE CITY PLANNING
 DEPARTMENT. APPLICANTS
 ARE RESPONSIBLE TO PROPERLY
 LOCATE AND IDENTIFY EASEMENTS
 ON THE PROPERTY. DATE: 6-4-02

*Drive on
 and
 5/11/02*

	Scigliano Residence	
	474 N. Sun Ct.	
Lot 12 Block 1	Fruitvale Meadows	SQ.FT. 7732
	SCALE	The Energy Office