

FEE \$	10.00
TCP \$	500.00
SIF \$	292.00

PLANNING CLEARANCE
 (Single Family Residential and Accessory Structures)
Community Development Department

BLDG PERMIT NO. _____



Your Bridge to a Better Community

ⓐ

BLDG ADDRESS 677 Arthur SQ. FT. OF PROPOSED BLDGS/ADDITION 2177

TAX SCHEDULE NO. 2945-032-89-002 SQ. FT. OF EXISTING BLDGS _____

SUBDIVISION Colonial Heights TOTAL SQ. FT. OF EXISTING & PROPOSED 2177

FILING 1 BLK 3 LOT 2 NO. OF DWELLING UNITS:
 Before: _____ After: 1 this Construction

(1) OWNER Sunshine II NO. OF BUILDINGS ON PARCEL
 Before: _____ After: _____ this Construction

(1) ADDRESS 2350 3 Row USE OF EXISTING BUILDINGS _____

(1) TELEPHONE 255-8853 DESCRIPTION OF WORK & INTENDED USE Single Family

(2) APPLICANT Sunshine II TYPE OF HOME PROPOSED:
 Site Built _____ Manufactured Home (UBC)
 _____ Manufactured Home (HUD)
 _____ Other (please specify) _____

(2) ADDRESS 2350 G Row

(2) TELEPHONE 255-8853

REQUIRED: One plot plan, on 8 1/2" x 11" paper, showing all existing & proposed structure location(s), parking, setbacks to all property lines, ingress/egress to the property, driveway location & width & all easements & rights-of-way which abut the parcel.

THIS SECTION TO BE COMPLETED BY COMMUNITY DEVELOPMENT DEPARTMENT STAFF

ZONE RMF-5 Maximum coverage of lot by structures 60%

SETBACKS: Front 20' from property line (PL) Permanent Foundation Required: YES X NO _____
 or _____ from center of ROW, whichever is greater

Side 5' from PL, Rear 25' from PL Parking Req'mt 2

Maximum Height 35' Special Conditions Engineered foundation required

B

CENSUS _____ TRAFFIC _____ ANNEX# _____

Modifications to this Planning Clearance must be approved, in writing, by the Community Development Department. The structure authorized by this application cannot be occupied until a final inspection has been completed and a Certificate of Occupancy has been issued, if applicable, by the Building Department (Section 305, Uniform Building Code).

I hereby acknowledge that I have read this application and the information is correct; I agree to comply with any and all codes, ordinances, laws, regulations or restrictions which apply to the project. I understand that failure to comply shall result in legal action, which may include but not necessarily be limited to non-use of the building(s).


Applicant Signature [Signature] Date 12-22-03

Department Approval NA Gayleen Henderson Date 12-31-03

Additional water and/or sewer tap fee(s) are required:	YES <input checked="" type="checkbox"/>	NO	W/O No. <u>6880</u>
Utility Accounting <u>[Signature]</u>		Date	<u>12/31/03</u>

VALID FOR SIX MONTHS FROM DATE OF ISSUANCE (Section 9-3-2C Grand Junction Zoning & Development Code)

(White: Planning) (Yellow: Customer) (Pink: Building Department) (Goldenrod: Utility Accounting)

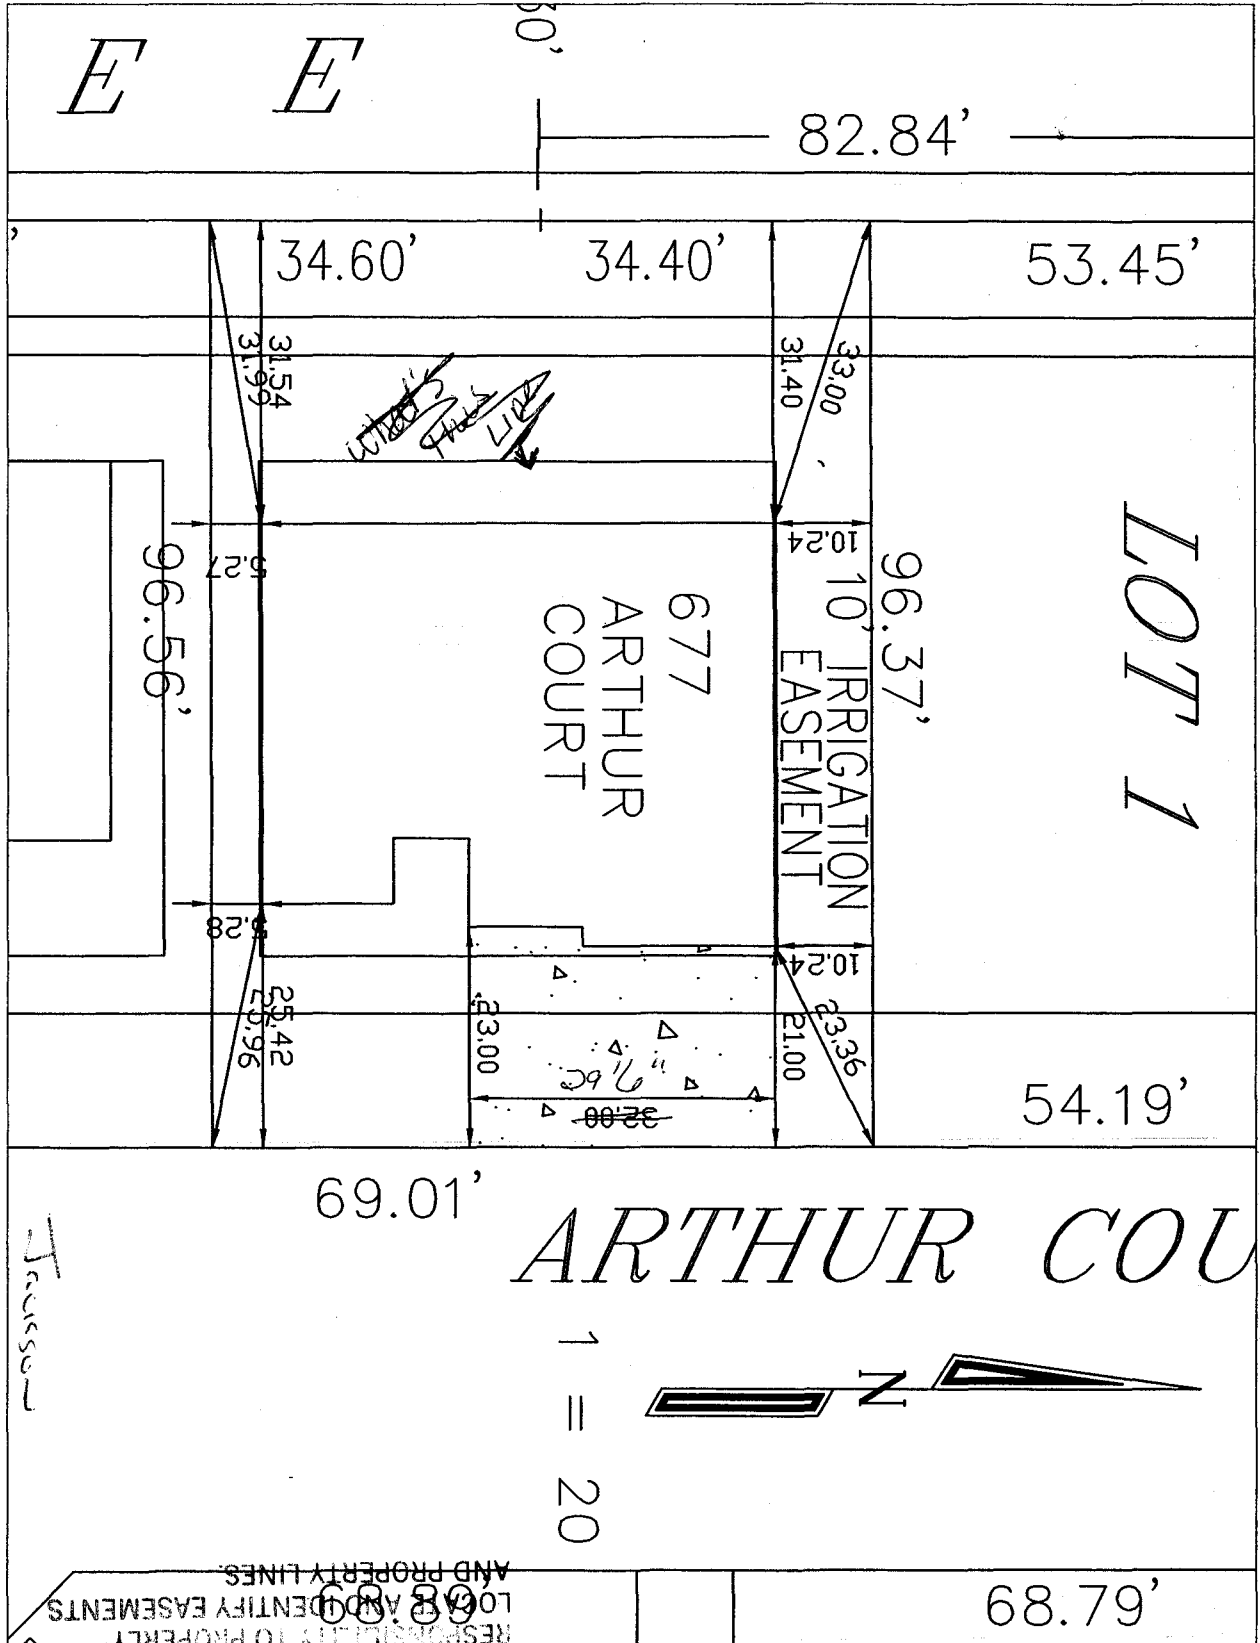

ACCEPTED
 Mike Wagner 12/18/03
 ANY CHANGE OF SETBACKS MUST BE APPROVED BY THE CITY PLANNING DEPT. BEFORE APPLICANTS DELIVER TO THE CITY PLANNING DEPT. TO IDENTIFY EASEMENTS AND PROPERTY LINES.