

FEE \$	10.00
TCP \$	500.00
SIF \$	292.00

**PLANNING CLEARANCE**  
 (Single Family Residential and Accessory Structures)  
**Community Development Department**

BLDG PERMIT NO. 89048



Your Bridge to a Better Community

BLDG ADDRESS 420 B BROKEN ARROW SQ. FT. OF PROPOSED BLDGS/ADDITION 1325

TAX SCHEDULE NO. 2943-174-20-011 SQ. FT. OF EXISTING BLDGS —

SUBDIVISION FLINT RIDGE TOTAL SQ. FT. OF EXISTING & PROPOSED 1325

FILING 2 BLK 4 LOT 12 NO. OF DWELLING UNITS:  
 Before: 0 After: 1 this Construction

(1) OWNER TML ENTERPRISES INC NO. OF BUILDINGS ON PARCEL  
 Before: 0 After: 1 this Construction

(1) ADDRESS P.O. Box 2569 USE OF EXISTING BUILDINGS —

(1) TELEPHONE (970) 245-9271 DESCRIPTION OF WORK & INTENDED USE New Home Const.

(2) APPLICANT TML ENTERPRISES INC TYPE OF HOME PROPOSED:  
 Site Built  Manufactured Home (UBC)  
 Manufactured Home (HUD)  
 Other (please specify) —

(2) ADDRESS P.O. Box 2569

(2) TELEPHONE (970) 245-9271

**REQUIRED: One plot plan, on 8 1/2" x 11" paper, showing all existing & proposed structure location(s), parking, setbacks to all property lines, ingress/egress to the property, driveway location & width & all easements & rights-of-way which abut the parcel.**

**THIS SECTION TO BE COMPLETED BY COMMUNITY DEVELOPMENT DEPARTMENT STAFF**

ZONE BMF-8 Maximum coverage of lot by structures 70%

SETBACKS: Front 20' from property line (PL) Permanent Foundation Required: YES  NO   
 or — from center of ROW, whichever is greater

Side 5' from PL, Rear 10' from PL Parking Req'mt 2

Maximum Height 35' Special Conditions —

CENSUS — TRAFFIC — ANN# —

Modifications to this Planning Clearance must be approved, in writing, by the Community Development Department. The structure authorized by this application cannot be occupied until a final inspection has been completed and a Certificate of Occupancy has been issued, if applicable, by the Building Department (Section 305, Uniform Building Code).

I hereby acknowledge that I have read this application and the information is correct; I agree to comply with any and all codes, ordinances, laws, regulations or restrictions which apply to the project. I understand that failure to comply shall result in legal action, which may include but not necessarily be limited to non-use of the building(s).

Applicant Signature [Signature] Date 4/15/03

Department Approval [Signature] Date 4/28/03


Additional water and/or sewer tap fee(s) are required:	YES <input checked="" type="checkbox"/>	NO <input type="checkbox"/>	W/O No. <u>15952</u> <u>107365</u>
Utility Accounting	<u>[Signature]</u>	Date	<u>4/24/03</u>

VALID FOR SIX MONTHS FROM DATE OF ISSUANCE (Section 9-3-2C Grand Junction Zoning & Development Code)


(White: Planning) (Yellow: Customer) (Pink: Building Department) (Goldenrod: Utility Accounting)

ACCEPTED  
 ANY CHANGE OF SETBACKS MUST BE APPROVED BY THE CITY PLANNING DEPT. IT IS THE APPLICANT'S RESPONSIBILITY TO PROPERLY LOCATE AND IDENTIFY EASEMENTS AND PROPERTY LINES.

*Mark Magor 4/24/03*

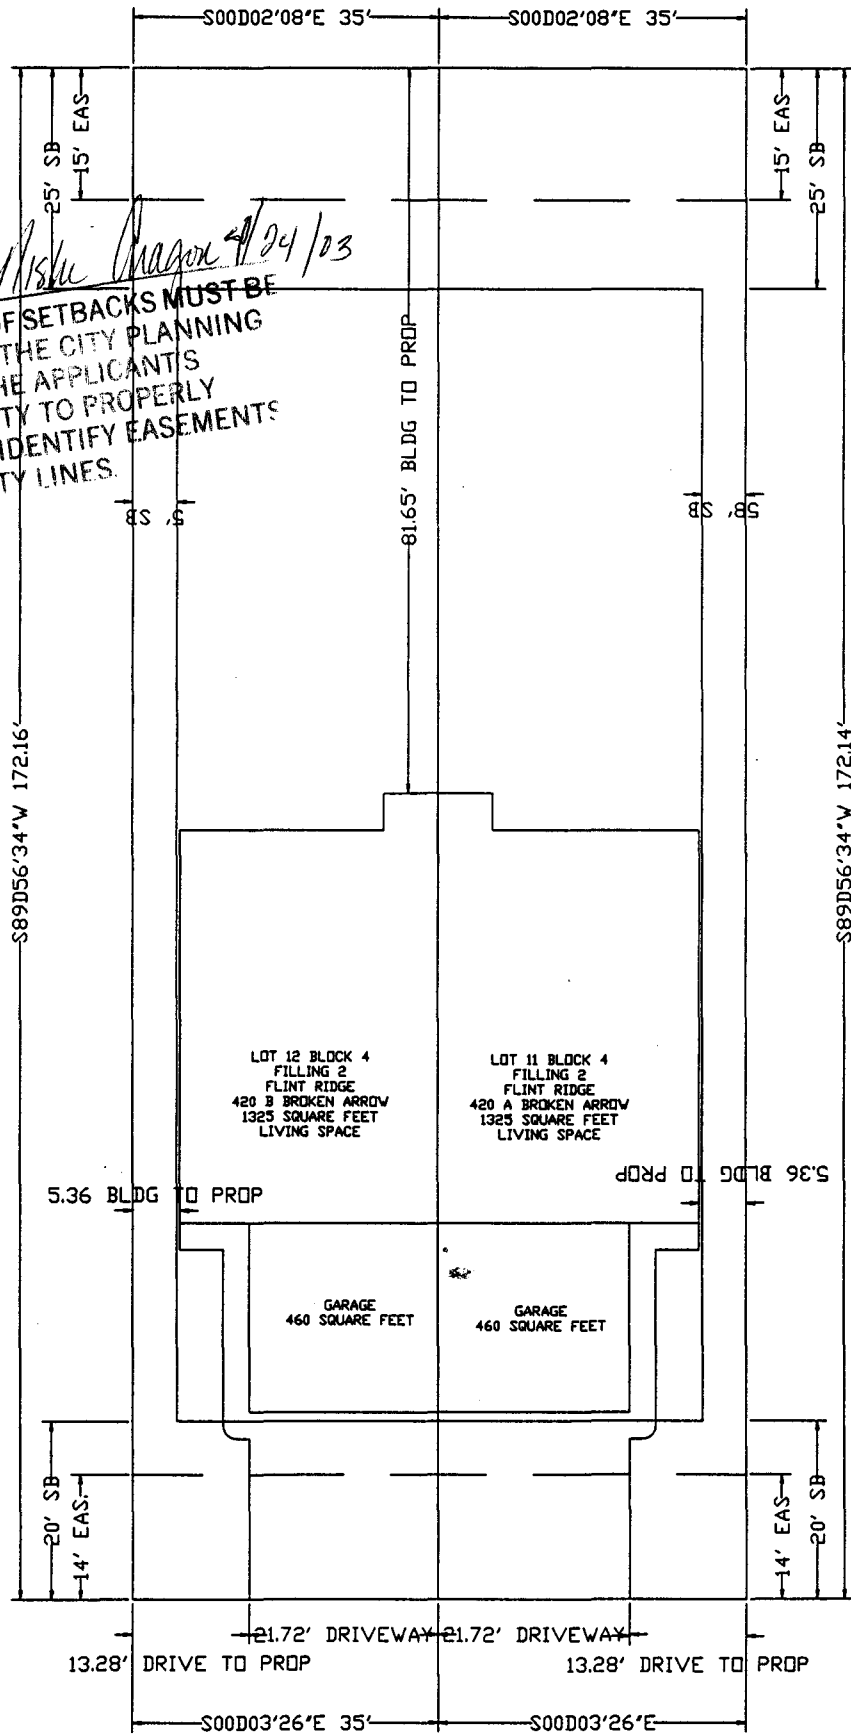

*OC*  
*u*  
 4/16/03

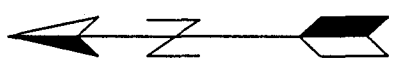

BROKEN ARROW DRIVE