

FEE \$	10.00
TCP \$	500.00
SIF \$	292.00

PLANNING CLEARANCE
 (Single Family Residential and Accessory Structures)
Community Development Department

BLDG PERMIT NO. 89190



Your Bridge to a Better Community

BLDG ADDRESS 421 1/2 A. Broken Arrow SQ. FT. OF PROPOSED BLDGS/ADDITION 1325

TAX SCHEDULE NO. 2943-174-20-011 SQ. FT. OF EXISTING BLDGS

SUBDIVISION FLINT RIDGE TOTAL SQ. FT. OF EXISTING & PROPOSED 1325

FILING 2 BLK 3 LOT 13 NO. OF DWELLING UNITS:
 Before: 0 After: 1 this Construction

(1) OWNER TML ENTERPRISES INC NO. OF BUILDINGS ON PARCEL
 Before: 0 After: 1 this Construction

(1) ADDRESS P.O. Box 2569 USE OF EXISTING BUILDINGS

(1) TELEPHONE (970) 245-9271 DESCRIPTION OF WORK & INTENDED USE New home Construction

(2) APPLICANT TML ENTERPRISES INC TYPE OF HOME PROPOSED:
 Site Built Manufactured Home (UBC)

(2) ADDRESS P.O. Box 2569 Manufactured Home (HUD)

(2) TELEPHONE (970) 245-9271 Other (please specify)

REQUIRED: One plot plan, on 8 1/2" x 11" paper, showing all existing & proposed structure location(s), parking, setbacks to all property lines, ingress/egress to the property, driveway location & width & all easements & rights-of-way which abut the parcel.

THIS SECTION TO BE COMPLETED BY COMMUNITY DEVELOPMENT DEPARTMENT STAFF

ZONE RMF-8 Maximum coverage of lot by structures 7090

SETBACKS: Front 20' from property line (PL) Permanent Foundation Required: YES NO
 or from center of ROW, whichever is greater

Side 0'/5' from PL, Rear 10 from PL Parking Req'mt 2

Maximum Height 35' Special Conditions

CENSUS TRAFFIC ANN#

Modifications to this Planning Clearance must be approved, in writing, by the Community Development Department. The structure authorized by this application cannot be occupied until a final inspection has been completed and a Certificate of Occupancy has been issued, if applicable, by the Building Department (Section 305, Uniform Building Code).

I hereby acknowledge that I have read this application and the information is correct; I agree to comply with any and all codes, ordinances, laws, regulations or restrictions which apply to the project. I understand that failure to comply shall result in legal action, which may include but not necessarily be limited to non-use of the building(s).

Applicant Signature [Signature] Date 4/23/03


Department Approval [Signature] Date 5/5/03

Additional water and/or sewer tap fee(s) are required:	YES <input checked="" type="checkbox"/>	NO <input type="checkbox"/>	W/O No <u>16015</u>
Utility Accounting <u>[Signature]</u>	Date <u>5-5-03</u>		

VALID FOR SIX MONTHS FROM DATE OF ISSUANCE (Section 9-3-2C Grand Junction Zoning & Development Code)


(White: Planning) (Yellow: Customer) (Pink: Building Department) (Goldenrod: Utility Accounting)

ACCEPTED
 ANY CHANGE OF SETBACKS MUST BE
 APPROVED BY THE CITY PLANNING
 DEPT. IT IS THE APPLICANT'S
 RESPONSIBILITY TO PROPERLY
 LOCATE AND IDENTIFY EASEMENTS
 AND PROPERTY LINES.

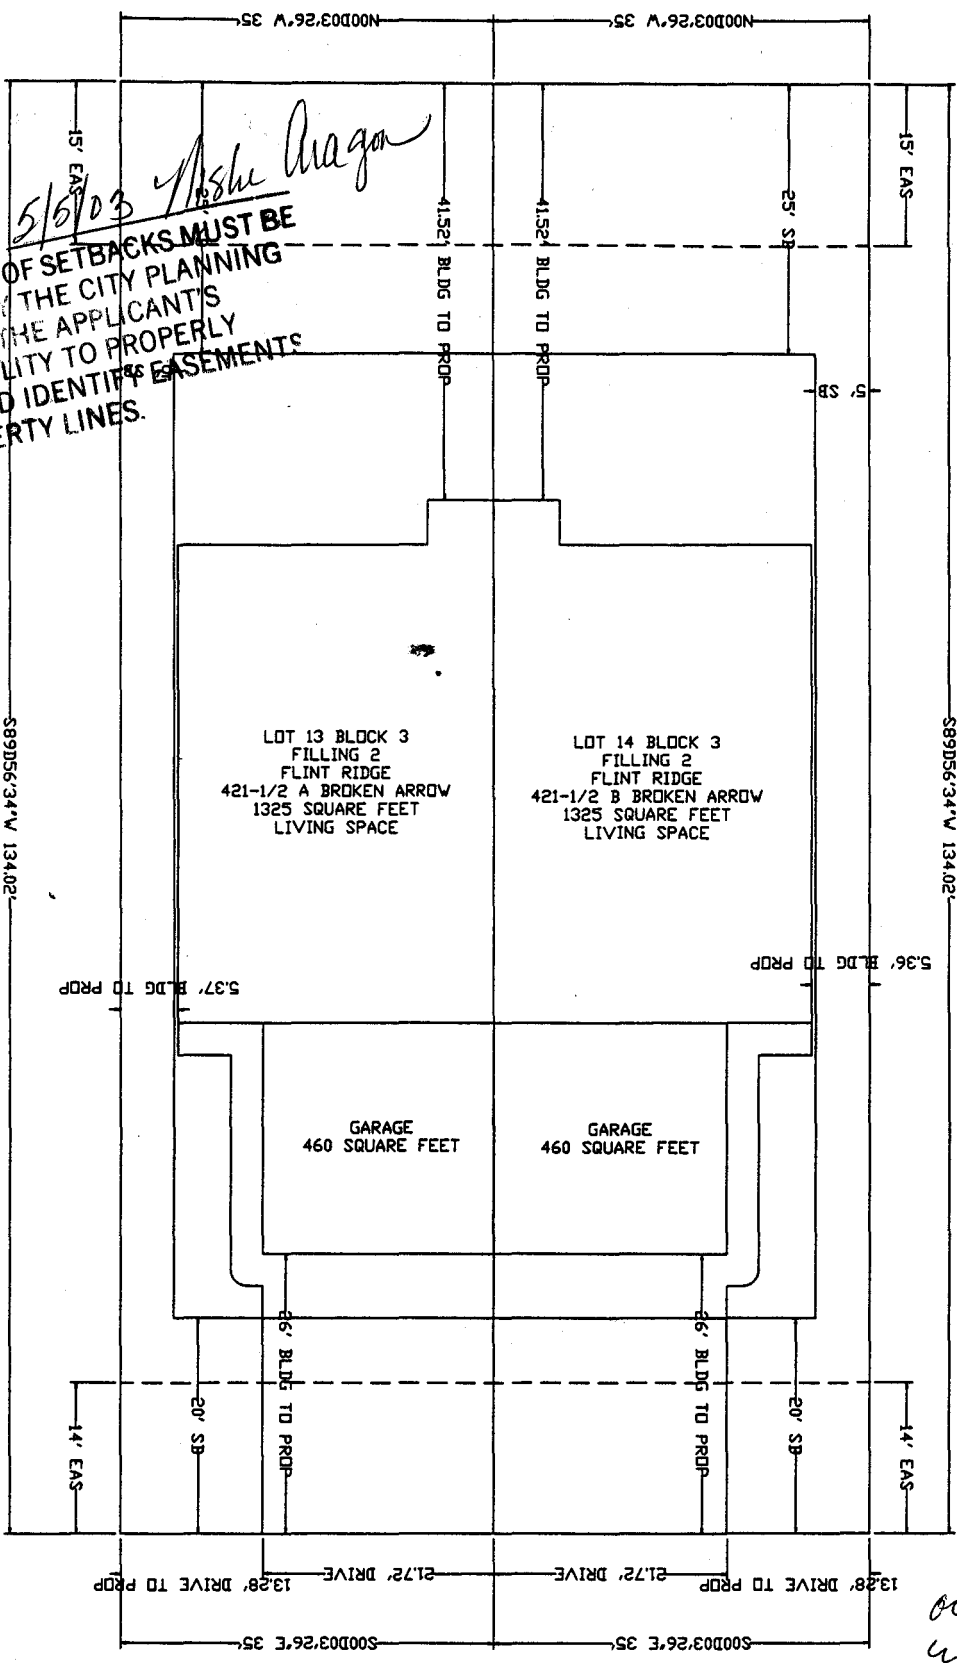

5/5/03 *Ashe Aragon*

BROKEN ARROW DRIVE

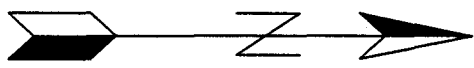

*oc
 m
 4/25/03*