

FEE \$ 10.00
TCP \$ 500.00
SIF \$ 292.00

PLANNING CLEARANCE

(Single Family Residential and Accessory Structures)
Community Development Department

BLDG PERMIT NO. 89577



Your Bridge to a Better Community

BLDG ADDRESS 737 ACACIA BLVD CIR. SQ. FT. OF PROPOSED BLDGS/ADDITION 1353

TAX SCHEDULE NO. 2701-334-36-037 SQ. FT. OF EXISTING BLDGS 0

SUBDIVISION FOUNTAIN GROVES SUB TOTAL SQ. FT. OF EXISTING & PROPOSED 1353

FILING 3 BLK --- LOT 35 NO. OF DWELLING UNITS:
 Before: 0 After: 1 this Construction

(1) OWNER FOUNTAIN GROVES LLC NO. OF BUILDINGS ON PARCEL
 Before: 0 After: 1 this Construction

(1) ADDRESS 1655 WALNUT ST. SUITE 300 USE OF EXISTING BUILDINGS N/A

(1) TELEPHONE (303) 442-3375 DESCRIPTION OF WORK & INTENDED USE ATTACHING SEVERAL

(2) APPLICANT SKELTON CONSTRUCTORS INC. TYPE OF HOME PROPOSED: FAMILY
 Site Built Manufactured Home (UBC)
 Manufactured Home (HUD)
 Other (please specify) _____

(2) ADDRESS P.O. Box 4247

(2) TELEPHONE 245-9008

REQUIRED: One plot plan, on 8 1/2" x 11" paper, showing all existing & proposed structure location(s), parking, setbacks to all property lines, ingress/egress to the property, driveway location & width & all easements & rights-of-way which abut the parcel.

THIS SECTION TO BE COMPLETED BY COMMUNITY DEVELOPMENT DEPARTMENT STAFF

ZONE PD Maximum coverage of lot by structures _____

SETBACKS: Front Per envelope from property line (PL) Permanent Foundation Required: YES NO _____
 or _____ from center of ROW whichever is greater

Side _____ from PL _____ from PL Parking Req'mt 2

Maximum Height _____ Special Conditions _____

CENSUS _____ TRAFFIC _____ ANN# _____

Modifications to this Planning Clearance must be approved, in writing, by the Community Development Department. The structure authorized by this application cannot be occupied until a final inspection has been completed and a Certificate of Occupancy has been issued, if applicable, by the Building Department (Section 305, Uniform Building Code).

I hereby acknowledge that I have read this application and the information is correct; I agree to comply with any and all codes, ordinances, laws, regulations or restrictions which apply to the project. I understand that failure to comply shall result in legal action, which may include but not necessarily be limited to non-use of the building(s).

Applicant Signature [Signature] Date 5/21/03

Department Approval [Signature] Date 5/23/03

Additional water and/or sewer tap fee(s) are required:	YES <input checked="" type="checkbox"/>	NO <input type="checkbox"/>	W/O No. <u>1010</u>
Utility Accounting	<u>[Signature]</u>	Date	<u>5/23/03</u>

VALID FOR SIX MONTHS FROM DATE OF ISSUANCE (Section 9-3-2C Grand Junction Zoning & Development Code)

(White: Planning) (Yellow: Customer) (Pink: Building Department) (Goldenrod: Utility Accounting)

to be vacated by separate document when the new drainage facilities are in place.

5/23/03




C. Fay Gibson

ACCEPTED
ANY CHANGE OF SETBACKS MUST BE APPROVED BY THE CITY PLANNING DEPT. IT IS THE APPLICANT'S RESPONSIBILITY TO PROPERLY LOCATE AND IDENTIFY EASEMENTS AND PROPERTY LINES

Gravel Road

S79°52'35"
120.94'


737

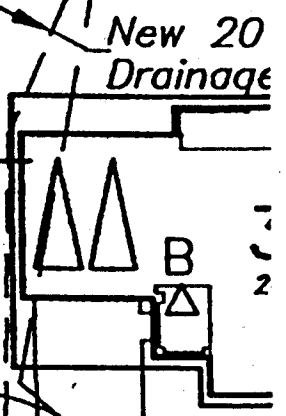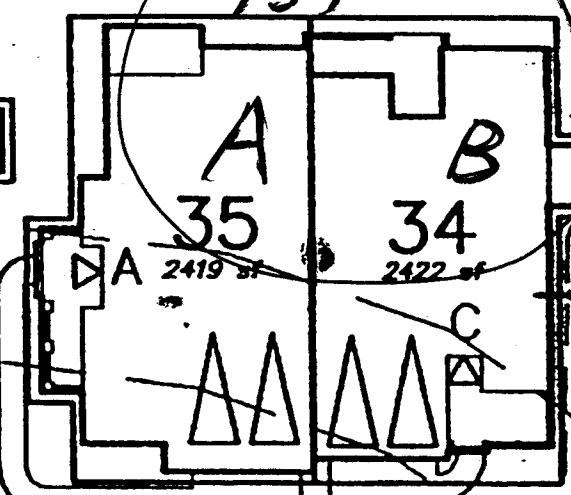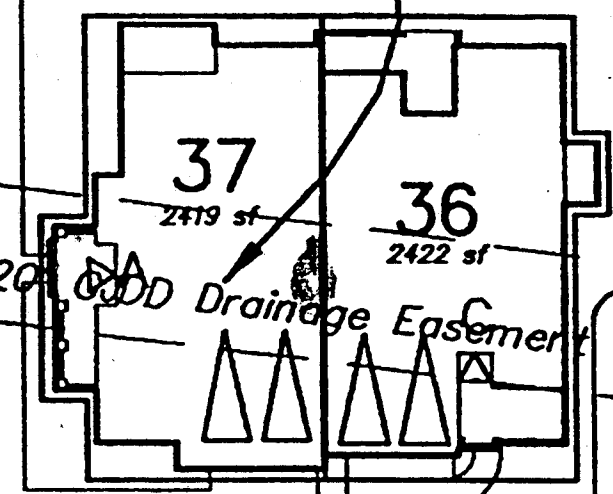

Tract E


ole
over
5/23/03

14' Multipurpose Easement

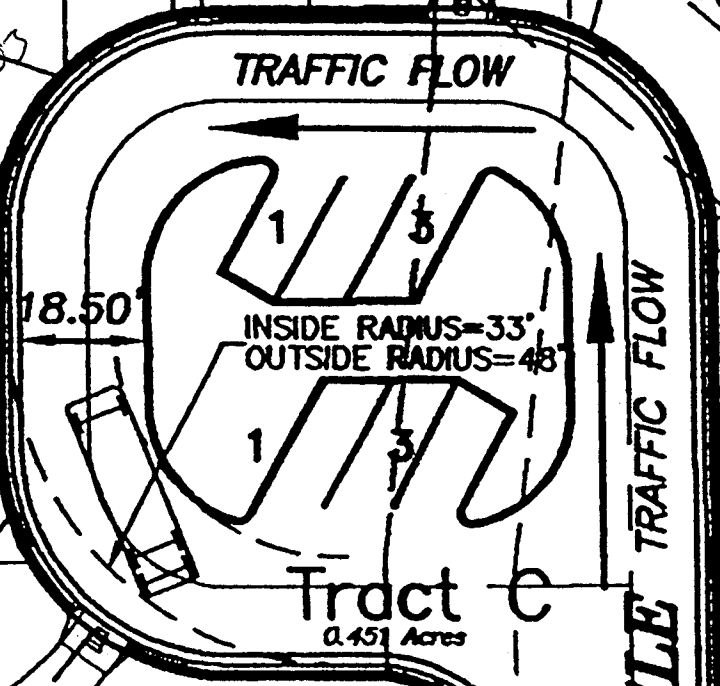


Tract C
0.451 Acres

16' CIRCULAR TRAFFIC FLOW EASEMENT

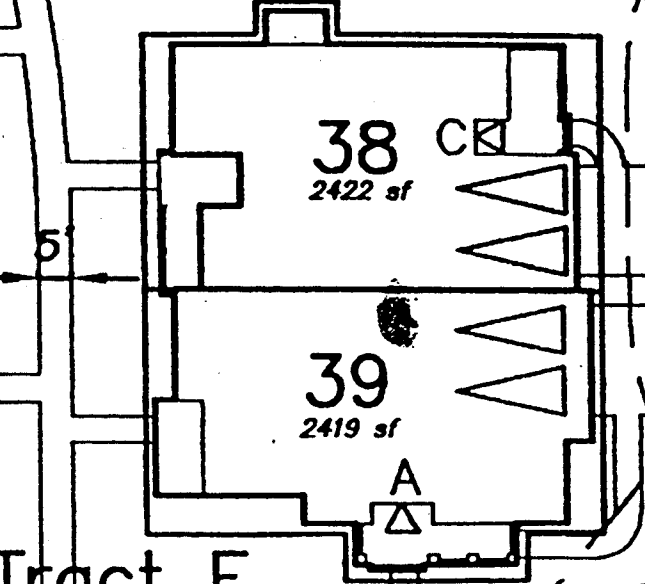

Tract E

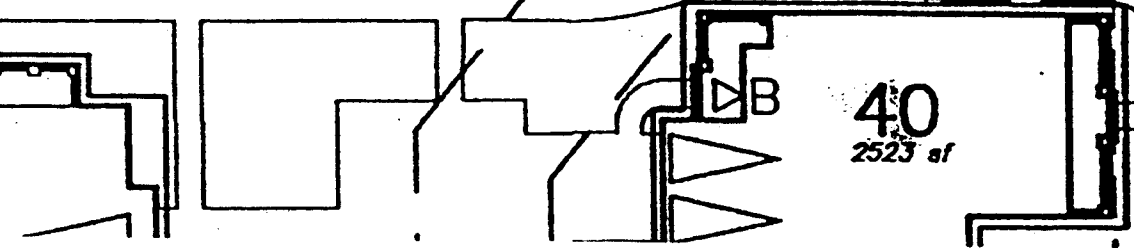

Easement