## TCP\$ 500.00 SIF\$ 292.00

## **PLANNING CLEARANCE**

(Single Family Residential and Accessory Structures)


Community Development Department

BLDG PERMIT NO.	90972
-----------------	-------



our Bridge to a Better Community

BLDG ADDRESS 4/8/ W CANVASSACK /2,	SQ. FT. OF PROPOSED BLDGS/ADDITION 1625	
TAX SCHEDULE NO. 270/- 334-36-047	SQ. FT. OF EXISTING BLDGS	
SUBDIVISION KONTAN GROTUS	TOTAL SQ. FT. OF EXISTING & PROPOSED 1625	
FILING 3 BLK LOT 45	NO. OF DWELLING UNITS:  Before:	
(1) OWNER FUNTAIN GROTING LAC 1655 WALNUT ST SUITE SUD (1) ADDRESS BOULDIE CO 80302	NO. OF BUILDINGS ON PARCEL  Before: After: this Construction	
(1) ADDRESS <u>86017/R</u> (3 80502	USE OF EXISTING BUILDINGS	
(2) APPLICANT SKELTON CONSTRUCTON LOS	DESCRIPTION OF WORK & INTENDED USE STORE FAMILY	
(2) ADDRESS $P = 0$ Box $42 \times 7$ G.T. (2) TELEPHONE $(970)$ $2\times 5-950$	TYPE OF HOME PROPOSED:  Site Built Manufactured Home (UBC)  Manufactured Home (HUD)  Other (please specify)	
REQUIRED: One plot plan, on 8 ½" x 11" paper, showing all existing & proposed structure location(s), parking, setbacks to all property lines, ingress/egress to the property, driveway location & width & all easements & rights-of-way which abut the parcel.		
THIS SECTION TO BE COMPLETED BY CO	MMUNITY DEVELOPMENT DEPARTMENT STAFF ®	
zone PD	Maximum coverage of lot by structures	
SETBACKS: Front from property line (PL) or from center of ROW, whichever is greater	Permanent Foundation Required: YES $X$ NO	
Sideflom PL Rear Jope from PL	Special Conditions	
Maximum Height	$\rho$	
	CENSUS B TRAFFIC ANNX#	
Structure authorized by this application cannot be occupied Occupancy has been issued, if applicable, by the Building I hereby acknowledge that I have read this application and ordinances, laws, regulations or restrictions which apply to action, which may include but not necessarily be limited to Applicant Signature	ed, in writing, by the Community Development Department. The ed until a final inspection has been completed and a Certificate of Department (Section 305, Uniform Building Code).  the information is correct; I agree to comply with any and all codes, the project. I understand that failure to comply shall result in legal pronon-use of the building(s).  Date	
Structure authorized by this application cannot be occupied Occupancy has been issued, if applicable, by the Building I hereby acknowledge that I have read this application and ordinances, laws, regulations or restrictions which apply to action, which may include but not necessarily be limited to	ed, in writing, by the Community Development Department. The ed until a final inspection has been completed and a Certificate of Department (Section 305, Uniform Building Code).  the information is correct; I agree to comply with any and all codes, the project. I understand that failure to comply shall result in legal or non-use of the building(s).	
structure authorized by this application cannot be occupied Occupancy has been issued, if applicable, by the Building I hereby acknowledge that I have read this application and ordinances, laws, regulations or restrictions which apply to action, which may include but not necessarily be limited to Applicant Signature  Department Approval	ed, in writing, by the Community Development Department. The ed until a final inspection has been completed and a Certificate of Department (Section 305, Uniform Building Code).  the information is correct; I agree to comply with any and all codes, the project. I understand that failure to comply shall result in legal pronon-use of the building(s).  Date	

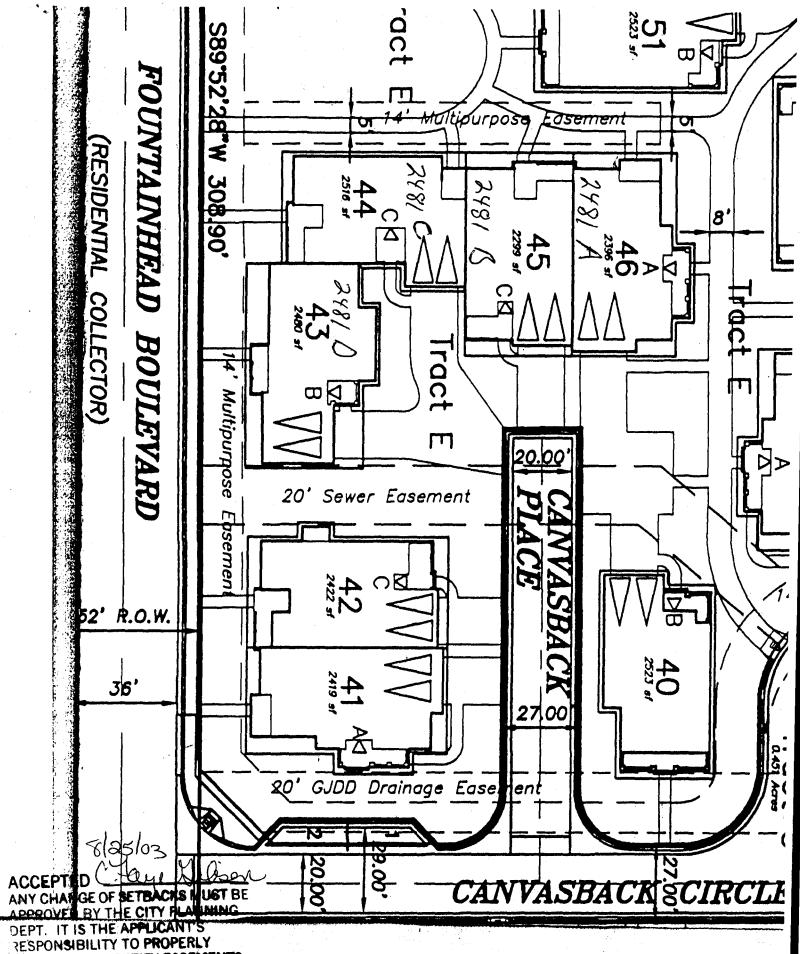

DEPT. IT IS THE APPLICANT'S
RESPONSIBILITY TO PROPERLY
LOCATE AND IDENTIFY EASEMENTS
AND PROPERTY LINES.

Ole 8/21/63