
PLANNING CLEARANCE BLDG PERMIT NO. 9/1/89	
TCP\$ (Single Family Residential and Ad	
SIF.\$ Community Developme	nt Department
Building Address 302 East Dc Kota -815	Proposed Proposed
Parcel No. 2945 - 301 - 08 - 011	Sq. Ft. of Existing Bldgs 4800 Proposed 608
Subdivision Monument Valley	Sq. Ft. of Lot / Parcel ~ 1.3 acres
Filing 5 Block 2 Lot 12	Sq. Ft. Coverage of Lot by Structures & Impervious Surface (Total Existing & Proposed)
OWNER INFORMATION:	DESCRIPTION OF WORK & INTENDED USE:
Name Ron & Barbara Mack	
Address 302 East Dakota	New Single Family Home (*check type below) Interior Remodel Other (please specify): R.V. Gerege - Detacked
City/State/Zip Grand Jet, CO 81503	*TYPE OF HOME PROPOSED:
APPLICANT INFORMATION:	
Name RED HART CONST - (Dan)	Site Built Manufactured Home (UBC) Manufactured Home (HUD) Other (please specify):
Address 2320 - E/2 Rd.	
City / State / Zip G. J. CO 81503	NOTES:
Telephone 234-0822	
REQUIRED: One plot plan, on 8 ½" x 11" paper, showing all e	xisting & proposed structure location(s), parking, setbacks to all on & width & all easements & rights-of-way which abut the parcel.
REQUIRED: One plot plan, on 8 ½" x 11" paper, showing all e	
REQUIRED: One plot plan, on 8 ½" x 11" paper, showing all exproperty lines, ingress/egress to the property, driveway location. THIS SECTION TO BE COMPLETED BY C	MUNITY DEVELOPMENT DEPARTMENT STAFF M Maximum coverage of lot by structures
REQUIRED: One plot plan, on 8 ½" x 11" paper, showing all exproperty lines, ingress/egress to the property, driveway location. THIS SECTION TO BE COMPLETED BY C	MUNITY DEVELOPMENT DEPARTMENT STAFF Maximum coverage of lot by structures Permanent Foundation Required: YESNO
REQUIRED: One plot plan, on 8 ½" x 11" paper, showing all exproperty lines, ingress/egress to the property, driveway location THIS SECTION TO BE COMPLETED BY CO	MUNITY DEVELOPMENT DEPARTMENT STAFF Maximum coverage of lot by structures Permanent Foundation Required: YESNO Parking Requirement Special Conditions
REQUIRED: One plot plan, on 8 ½" x 11" paper, showing all exproperty lines, ingress/egress to the property, driveway location THIS SECTION TO BE COMPLETED BY CO	MUNITY DEVELOPMENT DEPARTMENT STAFF Maximum coverage of lot by structures Permanent Foundation Required: YESNO Parking Requirement Special Conditions
REQUIRED: One plot plan, on 8 ½" x 11" paper, showing all exproperty lines, ingress/egress to the property, driveway location THIS SECTION TO BE COMPLETED BY CO	MUNITY DEVELOPMENT DEPARTMENT STAFF Maximum coverage of lot by structures Permanent Foundation Required: YES NO Parking Requirement Special Conditions in writing, by the Community Development Department. The until a final inspection has been completed and a Certificate of
REQUIRED: One plot plan, on 8 ½" x 11" paper, showing all exproperty lines, ingress/egress to the property, driveway location. THIS SECTION TO BE COMPLETED BY C	MUNITY DEVELOPMENT DEPARTMENT STAFF Maximum coverage of lot by structures Permanent Foundation Required: YES NO Parking Requirement Special Conditions i) ii) iii) iii) iii) iii) iiii) iiiiii
REQUIRED: One plot plan, on 8 ½" x 11" paper, showing all exproperty lines, ingress/egress to the property, driveway location. THIS SECTION TO BE COMPLETED BY C	MUNITY DEVELOPMENT DEPARTMENT STAFF Maximum coverage of lot by structures Permanent Foundation Required: YES NOX Parking Requirement Special Conditions in writing, by the Community Development Department. The until a final inspection has been completed and a Certificate of epartment (Section 305, Uniform Building Code). information is correct; I agree to comply with any and all codes, the project. I understand that failure to comply shall result in legal on-use of the building(s). Date
REQUIRED: One plot plan, on 8 ½" x 11" paper, showing all exproperty lines, ingress/egress to the property, driveway location. THIS SECTION TO BE COMPLETED BY C	MUNITY DEVELOPMENT DEPARTMENT STAFF Maximum coverage of lot by structures Permanent Foundation Required: YESNOX Parking Requirement Special Conditions in writing, by the Community Development Department. The until a final inspection has been completed and a Certificate of epartment (Section 305, Uniform Building Code). in information is correct; I agree to comply with any and all codes, the project. I understand that failure to comply shall result in legal on-use of the building(s). Date 8-29-05 Date 9/2/13.
REQUIRED: One plot plan, on 8 ½" x 11" paper, showing all exproperty lines, ingress/egress to the property, driveway location. THIS SECTION TO BE COMPLETED BY C	MUNITY DEVELOPMENT DEPARTMENT STAFF Maximum coverage of lot by structures Permanent Foundation Required: YES

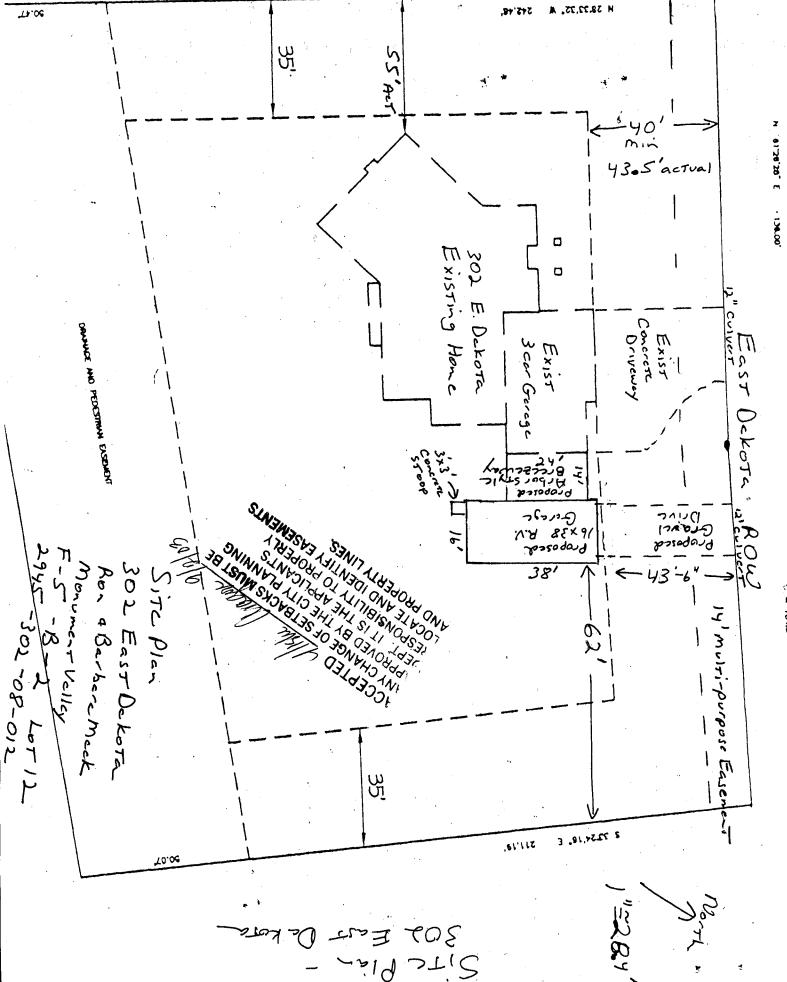

0 = 104.81