

FEE \$ 10.00
TCP \$ 500.00
SIF \$ 292.00

PLANNING CLEARANCE
 (Single Family Residential and Accessory Structures)
Community Development Department

BLDG PERMIT NO. 89357



Your Bridge to a Better Community

BLDG ADDRESS 2222 DAVINCI PLACE SQ. FT. OF PROPOSED BLDGS/ADDITION 2926
 TAX SCHEDULE NO. 2945-183-09-020 SQ. FT. OF EXISTING BLDGS 0
 SUBDIVISION RENAISSANCE IN THE REDLANDS TOTAL SQ. FT. OF EXISTING & PROPOSED 2926
 FILING 2 BLK 1 LOT 13 NO. OF DWELLING UNITS:
 Before: 0 After: 1 this Construction
 (1) OWNER Bur-Paint Homes NO. OF BUILDINGS ON PARCEL
 Before: 0 After: 1 this Construction
 (1) ADDRESS 3310 C RD PALISADE, Co. 81821 USE OF EXISTING BUILDINGS N/A
 (1) TELEPHONE 434-1862 DESCRIPTION OF WORK & INTENDED USE NEW CONST. SINGLE FAMILY
 (2) APPLICANT SAME TYPE OF HOME PROPOSED:
 (2) ADDRESS _____ Site Built _____ Manufactured Home (UBC)
 _____ Manufactured Home (HUD)
 (2) TELEPHONE _____ Other (please specify) _____

REQUIRED: One plot plan, on 8 1/2" x 11" paper, showing all existing & proposed structure location(s), parking, setbacks to all property lines, ingress/egress to the property, driveway location & width & all easements & rights-of-way which abut the parcel.

THIS SECTION TO BE COMPLETED BY COMMUNITY DEVELOPMENT DEPARTMENT STAFF

ZONE BSF-4 Maximum coverage of lot by structures 50%
 SETBACKS: Front 20' from property line (PL) Permanent Foundation Required: YES NO _____
 or _____ from center of ROW, whichever is greater
 Side 7' from PL, Rear 25' from PL Parking Req'mt 2
 Maximum Height 35' Special Conditions _____
 CENSUS _____ TRAFFIC _____ ANN# _____

Modifications to this Planning Clearance must be approved, in writing, by the Community Development Department. The structure authorized by this application cannot be occupied until a final inspection has been completed and a Certificate of Occupancy has been issued, if applicable, by the Building Department (Section 305, Uniform Building Code).

I hereby acknowledge that I have read this application and the information is correct; I agree to comply with any and all codes, ordinances, laws, regulations or restrictions which apply to the project. I understand that failure to comply shall result in legal action, which may include but not necessarily be limited to non-use of the building(s).

Applicant Signature M. Bur-Paint Date 5/6/03
 Department Approval J. Gayles Henderson Date 5-9-03


Additional water and/or sewer tap fee(s) are required:	YES <input checked="" type="checkbox"/>	NO	W/O No. <u>16044</u>
Utility Accounting <u>Alley</u>		Date <u>5/9/03</u>	

VALID FOR SIX MONTHS FROM DATE OF ISSUANCE (Section 9-3-2C Grand Junction Zoning & Development Code)

(White: Planning) (Yellow: Customer) (Pink: Building Department) (Goldenrod: Utility Accounting)

5-9-03 *Gayleen Henderson*
ACCEPTED

ANY CHANGE OF SETBACKS MUST BE APPROVED BY THE CITY PLANNING DEPT. IT IS THE APPLICANT'S RESPONSIBILITY TO PROPERLY LOCATE AND IDENTIFY EASEMENTS AND PROPERTY LINES.

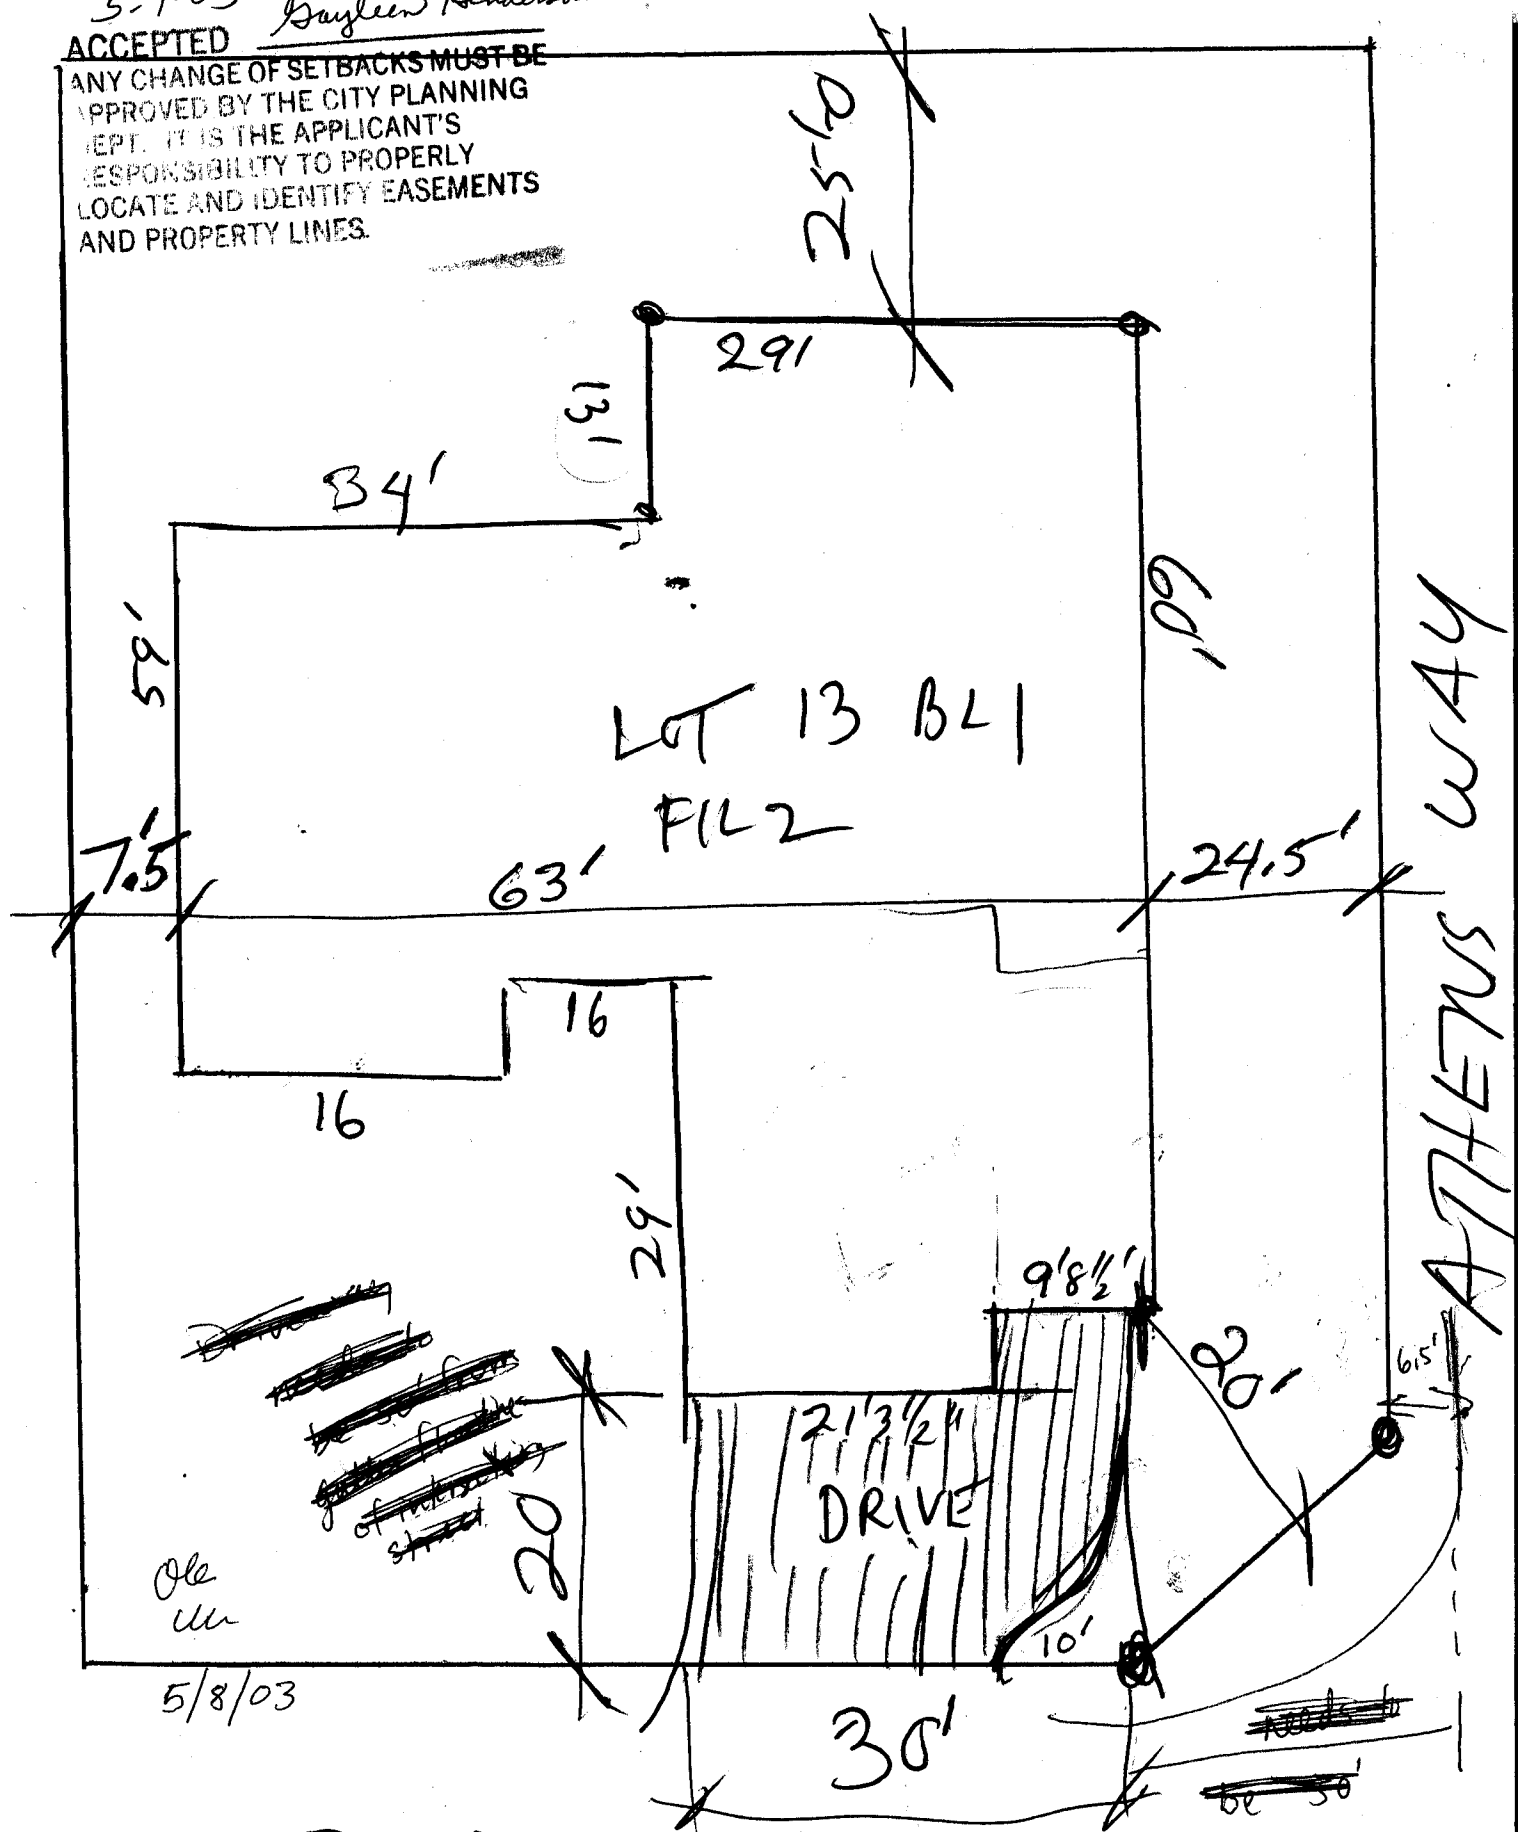

2222 DA VINCI PLACE