FEE \$ 10.00 500.00 292.00

PLANNING CLEARANCE


BLDG PERMIT NO.

(Single Family Residential and Accessory Structures)

Community Development Department



Building Address 2860 fenel one.	No. of Existing Bldgs Nove Proposed/
Parcel No. 2943 - 191 - 30 - 002	Sq. Ft. of Existing Bldgs Proposed
Subdivision White Willow bling #1	Sq. Ft. of Lot / Parcel 93 X 103
Filing Block Lot	Sq. Ft. Coverage of Lot by Structures & Impervious Surface (Total Existing & Proposed)
OWNER INFORMATION:	· · · · · · · · · · · · · · · · · · ·
Name Emil Jafage	DESCRIPTION OF WORK & INTENDED USE:
Address 2647 Ellowne Di	New Single Family Home (*check type below) Interior Remodel Addition Other (please specify):
City / State / Zip Stand Jel CO 8/50/	*TYPE OF HOME PROPOSED:
APPLICANT INFORMATION:	
Name Emel Datoya	 ✓ Site Built
Address 2647 El Corona De	Other (please specify):
City / State / Zip State / Zip	NOTES:
Telephone (970) 242-2956	· · · · · · · · · · · · · · · · · · ·
REQUIRED: One plot plan, on 8 ½" x 11" paper, showing all existing & proposed structure location(s), parking, setbacks to all property lines, ingress/egress to the property, driveway location & width & all easements & rights-of-way which abut the parcel.	
property lines, ingress/egress to the property, driveway location	
	MUNITY DEVELOPMENT DEPARTMENT STAFF
THIS SECTION TO BE COMPLETED BY COM	MUNITY DEVELOPMENT DEPARTMENT STAFF Maximum coverage of lot by structures
ZONE SECTION TO BE COMPLETED BY COM	MUNITY DEVELOPMENT DEPARTMENT STAFF Maximum coverage of lot by structures 50 % Permanent Foundation Required: YES X NO
ZONE	MUNITY DEVELOPMENT DEPARTMENT STAFF Maximum coverage of lot by structures 50 70 Permanent Foundation Required: YES X NO Parking Requirement 2
ZONE	MUNITY DEVELOPMENT DEPARTMENT STAFF Maximum coverage of lot by structures 50 70 Permanent Foundation Required: YES X NO Parking Requirement 2 Special Conditions Engineered foundation
ZONE	MUNITY DEVELOPMENT DEPARTMENT STAFF Maximum coverage of lot by structures 50 % Permanent Foundation Required: YES X NO Parking Requirement 2 Special Conditions Engineered foundation
THIS SECTION TO BE COMPLETED BY COM ZONE SETBACKS: Front 90' from property line (PL) Side 7' from PL Rear 95' From PL Maximum Height of Structure(s) Driveway Location Approval (Engineer's Initials) Modifications to this Planning Clearance must be approved	MUNITY DEVELOPMENT DEPARTMENT STAFF Maximum coverage of lot by structures 50 % Permanent Foundation Required: YES X NO Parking Requirement 2 Special Conditions Engineered foundations (IQVIVED) In writing, by the Community Development Department. The until a final inspection has been completed and a Certificate of
THIS SECTION TO BE COMPLETED BY COM ZONE SETBACKS: Front Tom PL Rear Side Tom PL Maximum Height of Structure(s) Driveway Location Approval (Engineer's Initials) Modifications to this Planning Clearance must be approved structure authorized by this application cannot be occupied Occupancy has been issued, if applicable, by the Building D I hereby acknowledge that I have read this application and the	MUNITY DEVELOPMENT DEPARTMENT STAFF Maximum coverage of lot by structures Maximum coverage of lot by structures Permanent Foundation Required: YES X NO Parking Requirement Special Conditions Engineered foundation (Special Conditions Engineered foundation) (Special Conditions En
THIS SECTION TO BE COMPLETED BY COM ZONE SETBACKS: Front The property line (PL) Side The promote property line (PL) Side The promote property line (PL) Side The promote prom	MUNITY DEVELOPMENT DEPARTMENT STAFF Maximum coverage of lot by structures Maximum coverage of lot by structures Permanent Foundation Required: YES X NO Parking Requirement Special Conditions Engineered foundation (Special Conditions) Figured No In writing, by the Community Development Department. The until a final inspection has been completed and a Certificate of epartment (Section 305, Uniform Building Code). In information is correct; I agree to comply with any and all codes, we project. I understand that failure to comply shall result in legal
THIS SECTION TO BE COMPLETED BY COM ZONE SETBACKS: Front from PL Rear From PL Maximum Height of Structure(s) Driveway Location Approval (Engineer's Initials) Modifications to this Planning Clearance must be approved structure authorized by this application cannot be occupied Occupancy has been issued, if applicable, by the Building D I hereby acknowledge that I have read this application and the ordinances, laws, regulations or restrictions which apply to the action, which may include but not necessarily be limited to n	MUNITY DEVELOPMENT DEPARTMENT STAFF Maximum coverage of lot by structures Maximum coverage of lot by structures Permanent Foundation Required: YES X NO Parking Requirement Special Conditions Engineered foundation CLQVIVED In writing, by the Community Development Department. The until a final inspection has been completed and a Certificate of epartment (Section 305, Uniform Building Code). In information is correct; I agree to comply with any and all codes, the project. I understand that failure to comply shall result in legal on-use of the building(s).
THIS SECTION TO BE COMPLETED BY COM ZONE SETBACKS: Front from PL Rear 5' from PL Maximum Height of Structure(s) Driveway Voting District Driveway Location Approval (Engineer's Initials) Modifications to this Planning Clearance must be approved structure authorized by this application cannot be occupied Occupancy has been issued, if applicable, by the Building D I hereby acknowledge that I have read this application and the ordinances, laws, regulations or restrictions which apply to the action, which may include but not necessarily be limited to n Applicant Signature	MUNITY DEVELOPMENT DEPARTMENT STAFF Maximum coverage of lot by structures 50 % Permanent Foundation Required: YES X NO Parking Requirement 2 Special Conditions Engineered foundations (LQUINE) in writing, by the Community Development Department. The until a final inspection has been completed and a Certificate of epartment (Section 305, Uniform Building Code). in information is correct; I agree to comply with any and all codes, he project. I understand that failure to comply shall result in legal on-use of the building(s). Date 11/193

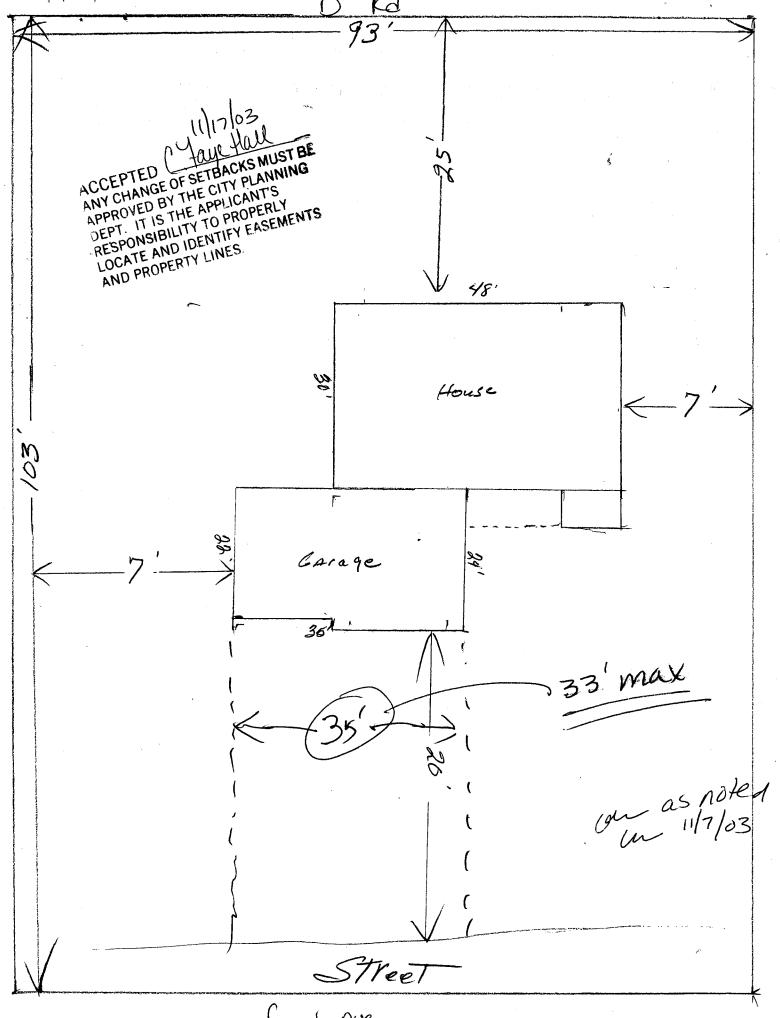

fenel AUE