

FEE \$	10.00
TCP \$	
SIF \$	

PLANNING CLEARANCE

BLDG PERMIT NO.

(Single Family Residential and Accessory Structures)
Community Development Department



Your Bridge to a Better Community

4572-2858

BLDG ADDRESS 2606 Grand Ave SQ. FT. OF PROPOSED BLDGS/ADDITION Covered Patio 252 sq ft

TAX SCHEDULE NO. 2945-131-09-015 SQ. FT. OF EXISTING BLDGS _____

SUBDIVISION No TOTAL SQ. FT. OF EXISTING & PROPOSED _____

FILING _____ BLK _____ LOT _____

NO. OF DWELLING UNITS:
 Before: _____ After: _____ this Construction

NO. OF BUILDINGS ON PARCEL
 Before: _____ After: _____ this Construction

(1) OWNER PATRICK C. GARNER

(1) ADDRESS 2606 Grand Ave.

(1) TELEPHONE 970-245-3971

USE OF EXISTING BUILDINGS _____

(2) APPLICANT Same

DESCRIPTION OF WORK & INTENDED USE Covered Patio

(2) ADDRESS _____

TYPE OF HOME PROPOSED:
 Site Built Manufactured Home (UBC)
 Manufactured Home (HUD)
 Other (please specify) _____

(2) TELEPHONE _____

REQUIRED: One plot plan, on 8 1/2" x 11" paper, showing all existing & proposed structure location(s), parking, setbacks to all property lines, ingress/egress to the property, driveway location & width & all easements & rights-of-way which abut the parcel.

THIS SECTION TO BE COMPLETED BY COMMUNITY DEVELOPMENT DEPARTMENT STAFF

ZONE RMF-8 Maximum coverage of lot by structures 70%

SETBACKS: Front 20' from property line (PL)
 or _____ from center of ROW, whichever is greater

Side 5' from PL, Rear 10' from PL

Permanent Foundation Required: YES _____ NO X

Maximum Height 35' Parking Req'mt 2

Special Conditions _____

CENSUS _____ TRAFFIC _____ ANNEX# _____

Modifications to this Planning Clearance must be approved, in writing, by the Community Development Department. The structure authorized by this application cannot be occupied until a final inspection has been completed and a Certificate of Occupancy has been issued, if applicable, by the Building Department (Section 305, Uniform Building Code).

I hereby acknowledge that I have read this application and the information is correct; I agree to comply with any and all codes, ordinances, laws, regulations or restrictions which apply to the project. I understand that failure to comply shall result in legal action, which may include but not necessarily be limited to non-use of the building(s).

Applicant Signature [Signature] Date _____

Department Approval [Signature] Date 10/14/03


Additional water and/or sewer tap fee(s) are required:	YES	NO	W/O No. <u>None in Use</u>
Utility Accounting	<u>Marshall Cole</u>		Date <u>10/14/03</u>

VALID FOR SIX MONTHS FROM DATE OF ISSUANCE (Section 9-3-2C Grand Junction Zoning & Development Code)

(White: Planning) (Yellow: Customer) (Pink: Building Department) (Goldenrod: Utility Accounting)

N 20th St

□ = 3'

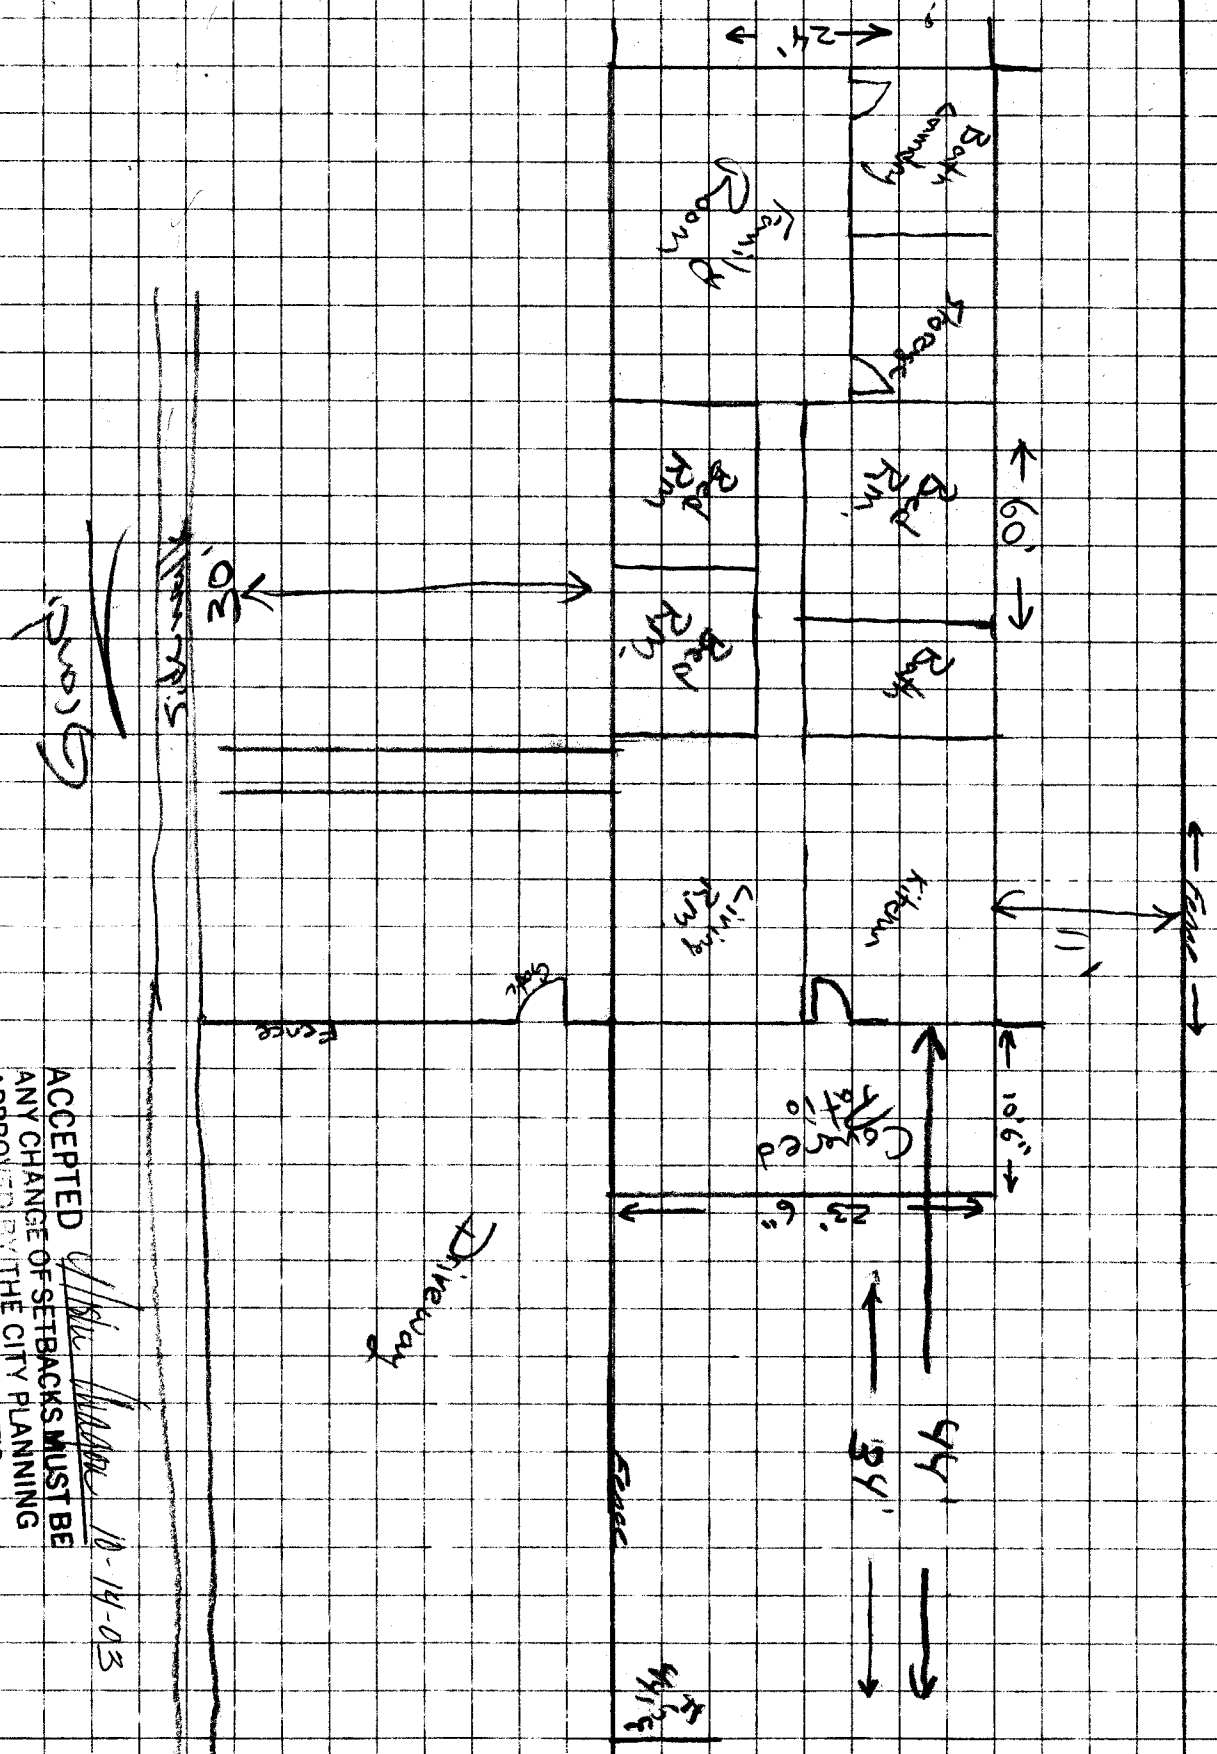

ACCEPTED
 ANY CHANGE OF SETBACKS MUST BE
 APPROVED BY THE CITY PLANNING
 DEPT.
 RESPONSIBILITY TO PROPERLY
 LOCATE AND IDENTIFY EASEMENTS
 AND PROPERTY LINES

Michelle Walker
 10-14-03