

Planning \$ <u>Pd W/SPR</u>	Drainage \$ <u> </u>
TCP \$ <u> </u>	School Impact \$ <u> </u>

BLDG PERMIT NO. <u>87984</u>
FILE # <u>SPR-2002-165</u>

PLANNING CLEARANCE

(site plan review, multi-family development, non-residential development)
Grand Junction Community Development Department

THIS SECTION TO BE COMPLETED BY APPLICANT

BUILDING ADDRESS <u>677 HORIZON DRIVE</u>	TAX SCHEDULE NO. <u>2945-012-50-004</u>
SUBDIVISION <u>SAFENAY AT HORIZON PARK</u>	SQ. FT. OF PROPOSED BLDG(S)/ADDITION <u>424 ϕ</u>
FILING _____ BLK _____ LOT <u>1</u>	SQ. FT OF EXISTING BLDG(S) <u>N/A</u>
OWNER <u>DOMINICK'S FINER FOODS, INC.</u>	NO. OF DWELLING UNITS: BEFORE <u>N/A</u> AFTER <u>N/A</u>
ADDRESS <u>5918 STONERIDGE MALL ROAD</u>	CONSTRUCTION
ADDRESS <u>PLEASANTON, CA 94588</u>	NO. OF BLDGS ON PARCEL: BEFORE <u>N/A</u> AFTER _____
TELEPHONE <u>303.843.7567</u>	CONSTRUCTION
APPLICANT <u>GALLOWAY, ROMERO & ASSOCIATES</u>	USE OF ALL EXISTING BLDGS <u>N/A</u>
ADDRESS <u>5350 DTC PKWY. GREENWOOD VILLAGE CO 80111</u>	DESCRIPTION OF WORK & INTENDED USE: <u>CONSTRUCTION</u>
TELEPHONE <u>303.770.8884</u>	<u>AND OPERATION OF A FUELING FACILITY,</u>
<u>✓ Submittal requirements are outlined in the SSID (Submittal Standards for Improvements and Development) document.</u>	<u>KIOSK / CONVENIENCE STORE, AND PARKING</u>

THIS SECTION TO BE COMPLETED BY COMMUNITY DEVELOPMENT DEPARTMENT STAFF

ZONE <u>C-1</u>	LANDSCAPING/SCREENING REQUIRED: YES <input checked="" type="checkbox"/> NO _____
SETBACKS: FRONT: <u>15</u> from Property Line (PL) or from center of ROW, whichever is greater	PARKING REQUIREMENT: <u>Per Plan</u>
SIDE: <u>0</u> from PL REAR: <u>10</u> from PL	SPECIAL CONDITIONS: _____
MAXIMUM HEIGHT <u>40</u>	_____
MAXIMUM COVERAGE OF LOT BY STRUCTURES <u>1.0 FAR</u>	CENSUS TRACT _____ TRAFFIC ZONE _____ ANNEX _____

Modifications to this Planning Clearance must be approved, in writing, by the Community Development Department Director. The structure authorized by this application cannot be occupied until a final inspection has been completed and a Certificate of Occupancy has been issued by the Building Department (Section 307, Uniform Building Code). Required improvements in the public right-of-way must be guaranteed prior to issuance of a Planning Clearance. All other required site improvements must be completed or guaranteed prior to issuance of a Certificate of Occupancy. Any landscaping required by this permit shall be maintained in an acceptable and healthy condition. The replacement of any vegetation materials that die or are in an unhealthy condition is required by the Grand Junction Zoning and Development Code.

Four (4) sets of final construction drawings must be submitted and stamped by City Engineering prior to issuing the Planning Clearance. One stamped set must be available on the job site at all times.


I hereby acknowledge that I have read this application and the information is correct; I agree to comply with any and all codes, ordinances, laws, regulations, or restrictions which apply to the project. I understand that failure to comply shall result in legal action, which may include but not necessarily be limited to non-use of the building(s).

Applicant's Signature <u>[Signature]</u>	Date <u>7/25/02</u>
Department Approval <u>[Signature]</u>	Date <u>12/17/02</u>

Additional water and/or sewer tap fee(s) are required:	YES <input checked="" type="checkbox"/> NO _____	W/O No. <u>15645</u>
Utility Accounting <u>[Signature]</u>		Date <u>1/22/03</u>

VALID FOR SIX MONTHS FROM DATE OF ISSUANCE (Section 9-3-2C Grand Junction Zoning and Development Code)

(White: Planning) (Yellow: Customer) (Pink: Building Department) (Goldenrod: Utility Accounting)

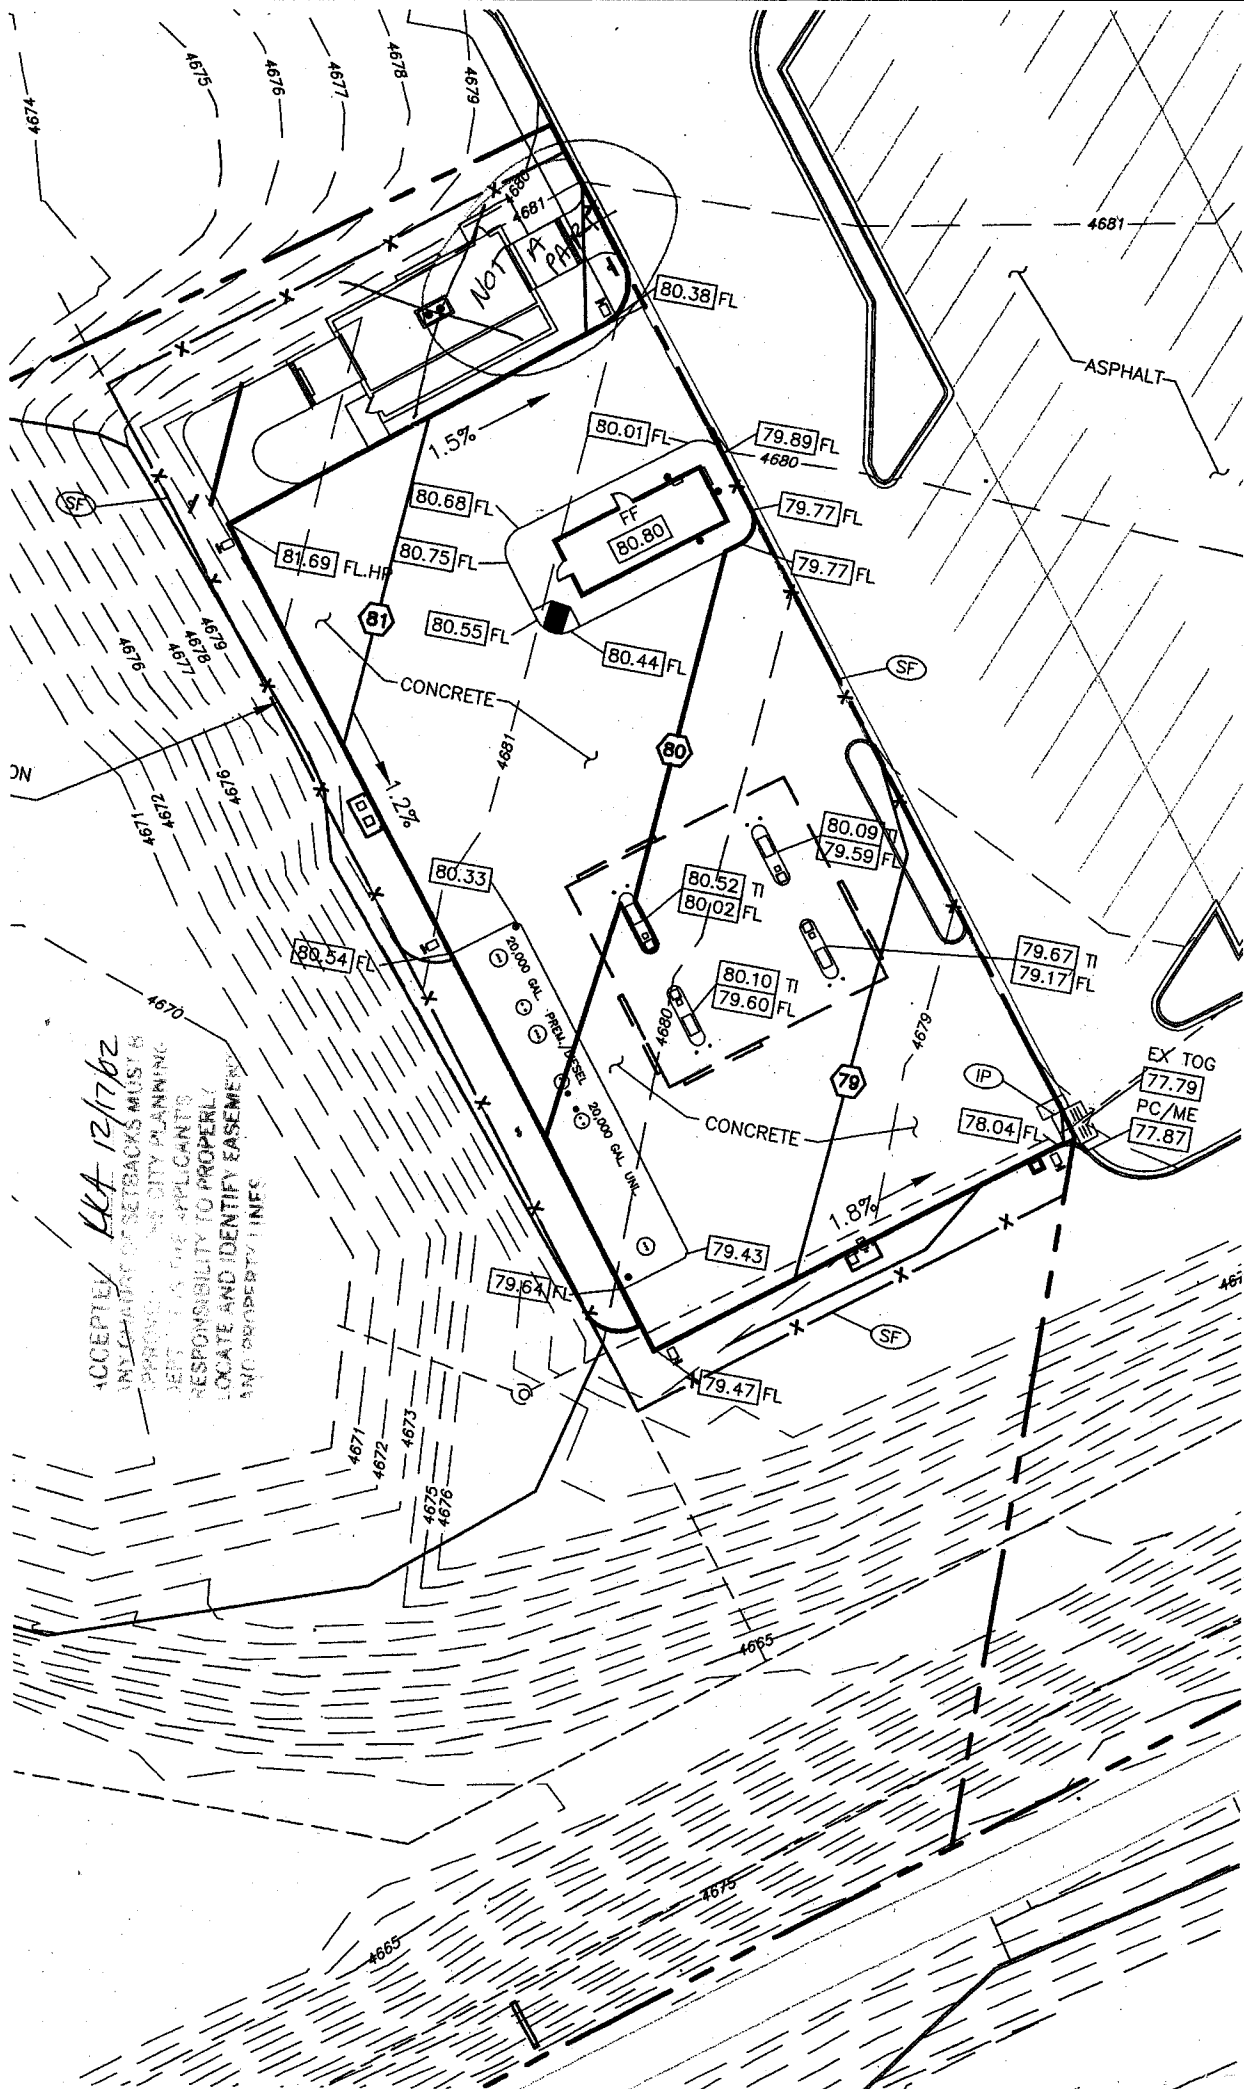

ACCEPTLY KKA 12/17/62
 ANY CHANGE OF SETBACKS MUST BE
 APPROVED BY THE CITY PLANNING
 DEPT. IT IS THE APPLICANT'S
 RESPONSIBILITY TO PROPERLY
 LOCATE AND IDENTIFY EASEMENTS
 AND PROPERTY LINES

NOT TO SCALE

EX TOG
 77.79
 PC/ME
 77.87