

FEE \$	10.00
TCP \$	None
SIF \$	

PLANNING CLEARANCE
 (Single Family Residential and Accessory Structures)
Community Development Department

BLDG PERMIT NO. _____



Building Address 482 Jaquette Lane
 Parcel No. 2943-101-15-009
 Subdivision Ruby Meadows
 Filing _____ Block _____ Lot _____

No. of Existing Bldgs 1 Proposed 1
 Sq. Ft. of Existing Bldgs 1,305 Proposed 284
 Sq. Ft. of Lot / Parcel _____
 Sq. Ft. Coverage of Lot by Structures & Impervious Surface (Total Existing & Proposed) _____

OWNER INFORMATION:

Name Joseph Vialpando
 Address Same
 City / State / Zip Grand Junction

DESCRIPTION OF WORK & INTENDED USE:

- New Single Family Home (*check type below)
- Interior Remodel Addition Shed
- Other (please specify): _____

APPLICANT INFORMATION:

Name Same
 Address _____
 City / State / Zip _____
 Telephone 523-0578

***TYPE OF HOME PROPOSED:**

- Site Built Manufactured Home (UBC)
- Manufactured Home (HUD)
- Other (please specify): _____

NOTES: _____

REQUIRED: One plot plan, on 8 1/2" x 11" paper, showing all existing & proposed structure location(s), parking, setbacks to all property lines, ingress/egress to the property, driveway location & width & all easements & rights-of-way which abut the parcel.

THIS SECTION TO BE COMPLETED BY COMMUNITY DEVELOPMENT DEPARTMENT STAFF	
ZONE <u>RMF-8</u>	Maximum coverage of lot by structures <u>70%</u>
SETBACKS: Front <u>25'</u> from property line (PL)	Permanent Foundation Required: YES _____ NO <u>X</u>
Side <u>3'</u> from PL Rear <u>5'</u> from PL	Parking Requirement <u>2</u>
Maximum Height of Structure(s) <u>35'</u>	Special Conditions _____
Voting District _____	Driveway Location Approval _____ (Engineer's Initials)

Modifications to this Planning Clearance must be approved, in writing, by the Community Development Department. The structure authorized by this application cannot be occupied until a final inspection has been completed and a Certificate of Occupancy has been issued, if applicable, by the Building Department (Section 305, Uniform Building Code).

I hereby acknowledge that I have read this application and the information is correct; I agree to comply with any and all codes, ordinances, laws, regulations or restrictions which apply to the project. I understand that failure to comply shall result in legal action, which may include but not necessarily be limited to non-use of the building(s).

Applicant Signature Joseph Vialpando Date _____
 Department Approval W/She Magon Date 11/12/03

Additional water and/or sewer tap fee(s) are required:	YES	NO <u>X</u>	W/O No. <u>No chg in use</u>
Utility Accounting <u>CM Cole</u>	Date <u>11/12/03</u>		

VALID FOR SIX MONTHS FROM DATE OF ISSUANCE (Section 2.2.C.1 Grand Junction Zoning & Development Code)
 (White: Planning) (Yellow: Customer) (Pink: Building Department) (Goldenrod: Utility Accounting)

N00°03'11" W 60.00'

60.00'

SMT 60.00'

LOT 8
0.12 Acres.
5337 Sq.ft.

90.00'

482
JAQUETT
LANE

LOT 10
0.12 Acres.
5400 Sq.ft.

90.00'

C7A

43.30'


14' Multi-pu

ACCEPTED *Y. Hsu* *2/21/03*
ANY CHANGE OF SETBACKS MUST BE
APPROVED BY THE CITY PLANNING
DEPT. IT IS THE APPLICANT'S
RESPONSIBILITY TO PROPERLY
LOCATE AND IDENTIFY EASEMENTS
AND PROPERTY LINES.

60.00'
JAQUETTE


ACCEPTED
ANY CHANGE OF SETBACKS MUST BE
APPROVED BY THE CITY PLANNING
DEPT. IT IS THE APPLICANT'S
RESPONSIBILITY TO PROPERLY
LOCATE AND IDENTIFY EASEMENTS
AND PROPERTY LINES.

SETBACKS MUST BE 20'

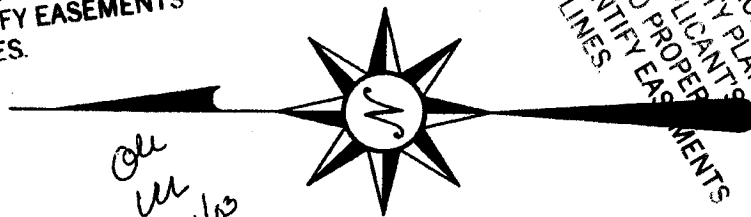

OK
ll
2/21/03

Cap
2/11/03

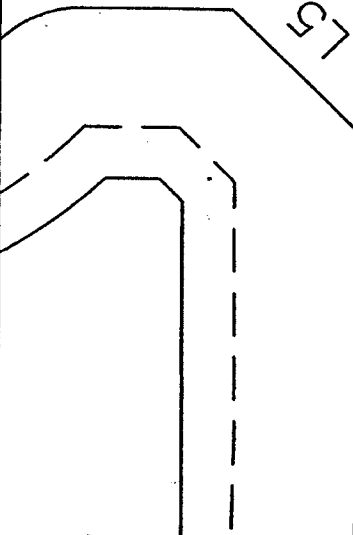


36.99'

22.0'

L6

65.72'

L10
Easmt

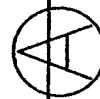

LOT 8
0.11 Acres.
4936 Sq.ft.

N0°03'11" W