

FEE \$ <u>10.00</u>
TCP \$ <u>500.00</u>
SIF \$ <u>292.00</u>

PLANNING CLEARANCE
 (Single Family Residential and Accessory Structures)
Community Development Department

BLDG PERMIT NO. _____



Your Bridge to a Better Community

BLDG ADDRESS 2807 MEADE CT SQ. FT. OF PROPOSED BLDGS/ADDITION 1901

TAX SCHEDULE NO. 2443-063-45-018 SQ. FT. OF EXISTING BLDGS _____

SUBDIVISION Village Park TOTAL SQ. FT. OF EXISTING & PROPOSED 1901

FILING 2 BLK 1 LOT 18 NO. OF DWELLING UNITS:
 Before: _____ After: 1 this Construction

(1) OWNER Sonshine II NO. OF BUILDINGS ON PARCEL
 Before: _____ After: 1 this Construction

(1) ADDRESS 2350 G ROAD USE OF EXISTING BUILDINGS _____

(1) TELEPHONE 255-8853 DESCRIPTION OF WORK & INTENDED USE Single Family

(2) APPLICANT Sonshine II TYPE OF HOME PROPOSED:
 Site Built _____ Manufactured Home (UBC)
 _____ Manufactured Home (HUD)
 _____ Other (please specify) _____

(2) ADDRESS 2350 G ROAD

(2) TELEPHONE 255-8853

REQUIRED: One plot plan, on 8 1/2" x 11" paper, showing all existing & proposed structure location(s), parking, setbacks to all property lines, ingress/egress to the property, driveway location & width & all easements & rights-of-way which abut the parcel.

THIS SECTION TO BE COMPLETED BY COMMUNITY DEVELOPMENT DEPARTMENT STAFF

ZONE PD Maximum coverage of lot by structures 50%

SETBACKS: Front 15' house 20' garage from property line (PL)
 or _____ from center of ROW, whichever is greater Permanent Foundation Required: YES NO _____

Side 5' from PL, Rear 10' from PL Parking Req'mt 2

Maximum Height 32' Special Conditions Engineered Foundations required

D CENSUS _____ TRAFFIC _____ ANN# _____

Modifications to this Planning Clearance must be approved, in writing, by the Community Development Department. The structure authorized by this application cannot be occupied until a final inspection has been completed and a Certificate of Occupancy has been issued, if applicable, by the Building Department (Section 305, Uniform Building Code).

I hereby acknowledge that I have read this application and the information is correct; I agree to comply with any and all codes, ordinances, laws, regulations or restrictions which apply to the project. I understand that failure to comply shall result in legal action, which may include but not necessarily be limited to non-use of the building(s).

Applicant Signature D. J. McK Date 12-22-03

Department Approval F.H. Gayleen Henderson Date 12-31-03

Additional water and/or sewer tap fee(s) are required:	YES <input checked="" type="checkbox"/>	NO	W/O No. <u>16903</u>
Utility Accounting <u>D. McK</u>	Date <u>12/31/03</u>		

VALID FOR SIX MONTHS FROM DATE OF ISSUANCE (Section 9-3-2C Grand Junction Zoning & Development Code)

(White: Planning) (Yellow: Customer) (Pink: Building Department) (Goldenrod: Utility Accounting)

IT IS THE RESPONSIBILITY OF THE BUILDER OR OWNER TO VERIFY ALL DETAILS AND DIMENSIONS PRIOR TO CONSTRUCTION.
 USE OF THIS PLAN CONSTITUTES BUILDER AND OR HOME OWNERS ACCEPTANCE OF THESE TERMS.
 ALL DIMENSIONS ARE TO FACE OF STUD UNLESS OTHER WISE NOTED.
 WALLS ARE DRAWN AS 3-1/2" THICK FOR 2x4 WALLS AND 5-1/2" FOR 2x6 WALLS.
 THIS PLAN HAS NOT BEEN ENGINEERED BY AUTODRAFT. SEE SEPARATE DRAWINGS BY OTHERS FOR ENGINEERING DATA.


BLOCK 1
 LOT 18
 5037 sf
 2807 MEADE CT.

SETBACKS:
 FRONT SB TO GARAGE 20' (15' TO HOUSE)
 SIDE SB 5'
 REAR SB BY GRAND VIEW 25'
 REAR SB BY DAWN 20'
 REAR SB BY VILLAGE PARK 10'

NOTE:
 BUILDER TO VERIFY ALL SETBACK AND EASEMENT ENCROACHMENTS PRIOR TO CONSTRUCTION

NOTE:
 DIMENSIONS PULLED TO BRICK LEDGE
 VERIFY WITH FLOORPLAN

MEADE COURT

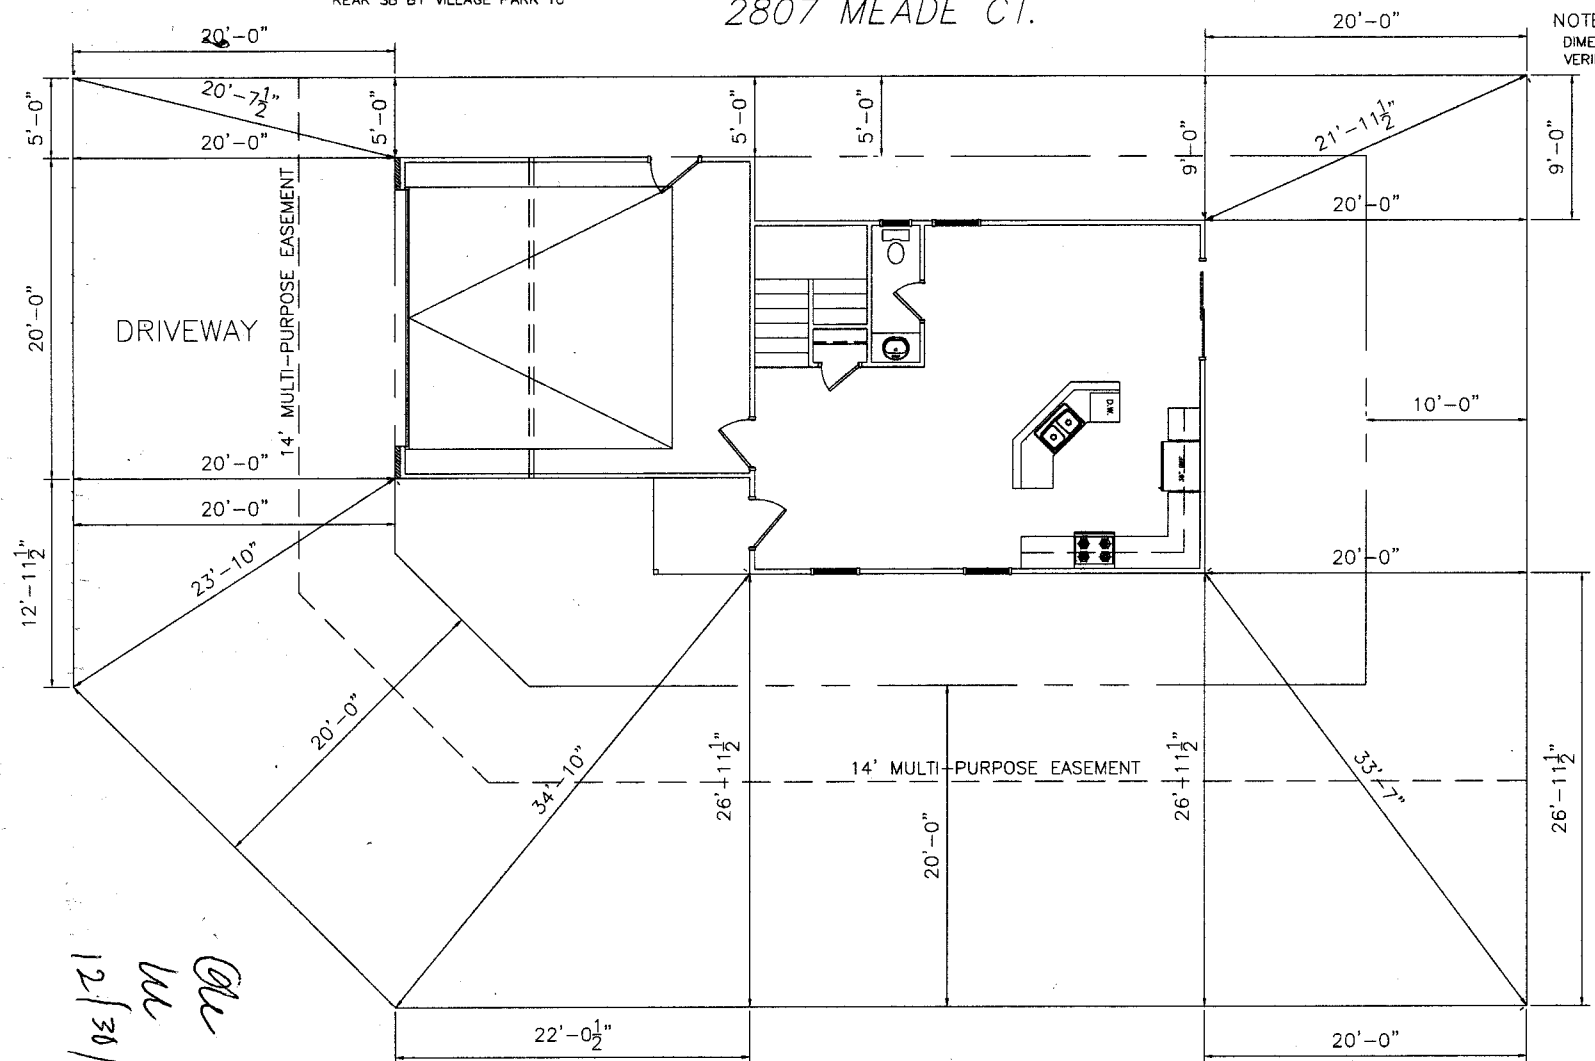

12-31-03
 ACCEPTED
 ANY CHANGE OF SETBACKS MUST BE APPROVED BY THE CITY PLANNING DEPT. IT IS THE APPLICANTS RESPONSIBILITY TO PROPERLY LOCATE AND IDENTIFY EASEMENTS AND PROPERTY LINES
Angela Henderson

12/30/03
 ML
 OLL

VILLAGE PARK DRIVE
 THE TETON