

FEE \$	10.00
TCP \$	500.00
SIF \$	292.00

**PLANNING CLEARANCE**  
 (Single Family Residential and Accessory Structures)  
Community Development Department

BLDG PERMIT NO. 90606



Your Bridge to a Better Community

BLDG ADDRESS 396 Myrick SQ. FT. OF PROPOSED BLDGS/ADDITION 1466  
 TAX SCHEDULE NO. 2943-191-27-010 SQ. FT. OF EXISTING BLDGS \_\_\_\_\_  
 SUBDIVISION White Willows TOTAL SQ. FT. OF EXISTING & PROPOSED 1466  
 FILING 1 BLK 7 LOT 10 NO. OF DWELLING UNITS:  
 Before: 0 After: 1 this Construction  
 NO. OF BUILDINGS ON PARCEL  
 Before: 0 After: 1 this Construction  
 (1) OWNER John Ray USE OF EXISTING BUILDINGS \_\_\_\_\_  
 (1) ADDRESS 420 29rd. GJ. 81504 DESCRIPTION OF WORK & INTENDED USE Man Res  
 (1) TELEPHONE (970) 261-0376 TYPE OF HOME PROPOSED:  
 (2) APPLICANT same  Site Built \_\_\_\_\_ Manufactured Home (UBC)  
 (2) ADDRESS \_\_\_\_\_  Manufactured Home (HUD)  
 (2) TELEPHONE \_\_\_\_\_  Other (please specify) \_\_\_\_\_

**REQUIRED: One plot plan, on 8 1/2" x 11" paper, showing all existing & proposed structure location(s), parking, setbacks to all property lines, ingress/egress to the property, driveway location & width & all easements & rights-of-way which abut the parcel.**

**THIS SECTION TO BE COMPLETED BY COMMUNITY DEVELOPMENT DEPARTMENT STAFF**

ZONE RSF-4 Maximum coverage of lot by structures 50%  
 SETBACKS: Front 20' from property line (PL) Permanent Foundation Required: YES  NO \_\_\_\_\_  
 or \_\_\_\_\_ from center of ROW, whichever is greater  
 Side 7' from PL, Rear 25' from PL Parking Req'mt 2  
 Maximum Height 35' Special Conditions Engineered Foundation Required  
 E CENSUS \_\_\_\_\_ TRAFFIC \_\_\_\_\_ ANN# \_\_\_\_\_

Modifications to this Planning Clearance must be approved, in writing, by the Community Development Department. The structure authorized by this application cannot be occupied until a final inspection has been completed and a Certificate of Occupancy has been issued, if applicable, by the Building Department (Section 305, Uniform Building Code).

I hereby acknowledge that I have read this application and the information is correct; I agree to comply with any and all codes, ordinances, laws, regulations or restrictions which apply to the project. I understand that failure to comply shall result in legal action, which may include but not necessarily be limited to non-use of the building(s).

Applicant Signature John Ray Date 7-21-03  
 Department Approval A. B. Vishu Thagun Date 7-28-03


Additional water and/or sewer tap fee(s) are required:	YES <input checked="" type="checkbox"/>	NO	W/O No. <u>16357</u>
Utility Accounting	<u>Debi Oubolt</u>	Date	<u>7/28/03</u>

VALID FOR SIX MONTHS FROM DATE OF ISSUANCE (Section 9-3-2C Grand Junction Zoning & Development Code)

(White: Planning) (Yellow: Customer) (Pink: Building Department) (Goldenrod: Utility Accounting)

396 Myrtle

ACCEPTED *Alma Brown* 7/28/03  
ANY CHANGE OF SETBACKS MUST BE  
APPROVED BY THE CITY PLANNING  
DEPT. IT IS THE APPLICANT'S  
RESPONSIBILITY TO PROPERLY  
LOCATE AND IDENTIFY EASEMENTS  
AND PROPERTY LINES.

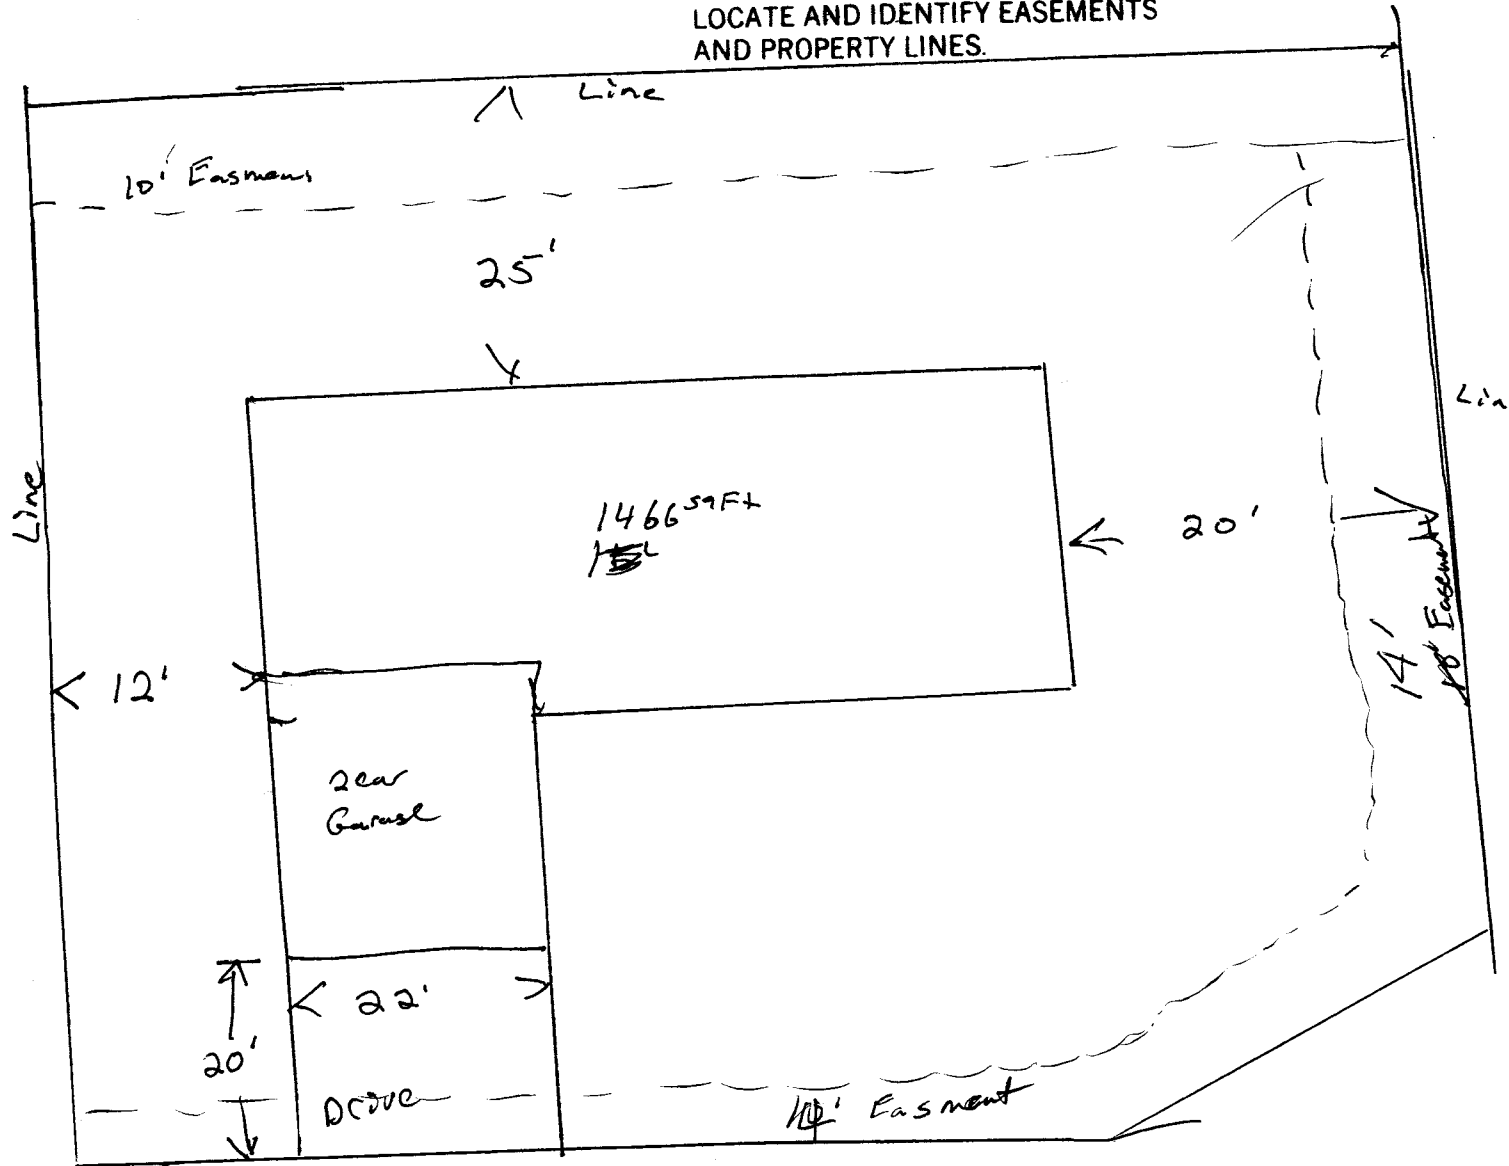

*Yarrow Dr. on*  
*6/22/03*

Myrtle St.