

FEE \$	10.00
TCP \$	0
SIF \$	292.00

PLANNING CLEARANCE
 (Single Family Residential and Accessory Structures)
Community Development Department

BLDG PERMIT NO. 89704



Your Bridge to a Better Community

BLDG ADDRESS 576 Norma Jean SQ. FT. OF PROPOSED BLDGS/ADDITION 1386

TAX SCHEDULE NO. 2943-071-23-004 SQ. FT. OF EXISTING BLDGS 0

SUBDIVISION The Legends TOTAL SQ. FT. OF EXISTING & PROPOSED 1386

FILING 4 BLK 3 LOT 1

NO. OF DWELLING UNITS:
 Before: 0 After: 1 this Construction

(1) OWNER The Legend Partners.

NO. OF BUILDINGS ON PARCEL
 Before: 0 After: 1 this Construction

(1) ADDRESS P.O. Box 1765, 6J, LO 81502

USE OF EXISTING BUILDINGS N/A

(1) TELEPHONE 244-9986 #17

DESCRIPTION OF WORK & INTENDED USE new single family

(2) APPLICANT Legend Partners

TYPE OF HOME PROPOSED:

(2) ADDRESS P.O. Box 1765, 6J, LO 81502

- Site Built
- Manufactured Home (UBC)
- Manufactured Home (HUD)
- Other (please specify) _____

(2) TELEPHONE 244-9986 #17

REQUIRED: One plot plan, on 8 1/2" x 11" paper, showing all existing & proposed structure location(s), parking, setbacks to all property lines, ingress/egress to the property, driveway location & width & all easements & rights-of-way which abut the parcel.

THIS SECTION TO BE COMPLETED BY COMMUNITY DEVELOPMENT DEPARTMENT STAFF

ZONE PD ~~detached~~ detached

Maximum coverage of lot by structures 80

SETBACKS: Front 15' residence 20' garage from property line (PL)
 or _____ from center of ROW, whichever is greater

Permanent Foundation Required: YES NO

Side 5' from PL, Rear 10' from PL

Parking Req'mt 2

Maximum Height 32'

Special Conditions Eng Foundation Required

CENSUS _____ TRAFFIC _____ ANNX# _____

Modifications to this Planning Clearance must be approved, in writing, by the Community Development Department. The structure authorized by this application cannot be occupied until a final inspection has been completed and a Certificate of Occupancy has been issued, if applicable, by the Building Department (Section 305, Uniform Building Code).

I hereby acknowledge that I have read this application and the information is correct; I agree to comply with any and all codes, ordinances, laws, regulations or restrictions which apply to the project. I understand that failure to comply shall result in legal action, which may include but not necessarily be limited to non-use of the building(s).

Applicant Signature [Signature] Date 5-29-03

Department Approval [Signature] Date 6-5-03


Additional water and/or sewer tap fee(s) are required:	YES <input checked="" type="checkbox"/>	NO <input type="checkbox"/>	W/O No. <u>16154</u>
Utility Accounting	<u>[Signature]</u>	Date <u>6/5/03</u>	

VALID FOR SIX MONTHS FROM DATE OF ISSUANCE (Section 9-3-2C Grand Junction Zoning & Development Code)

(White: Planning) (Yellow: Customer) (Pink: Building Department) (Goldenrod: Utility Accounting)

← NORTH

70'

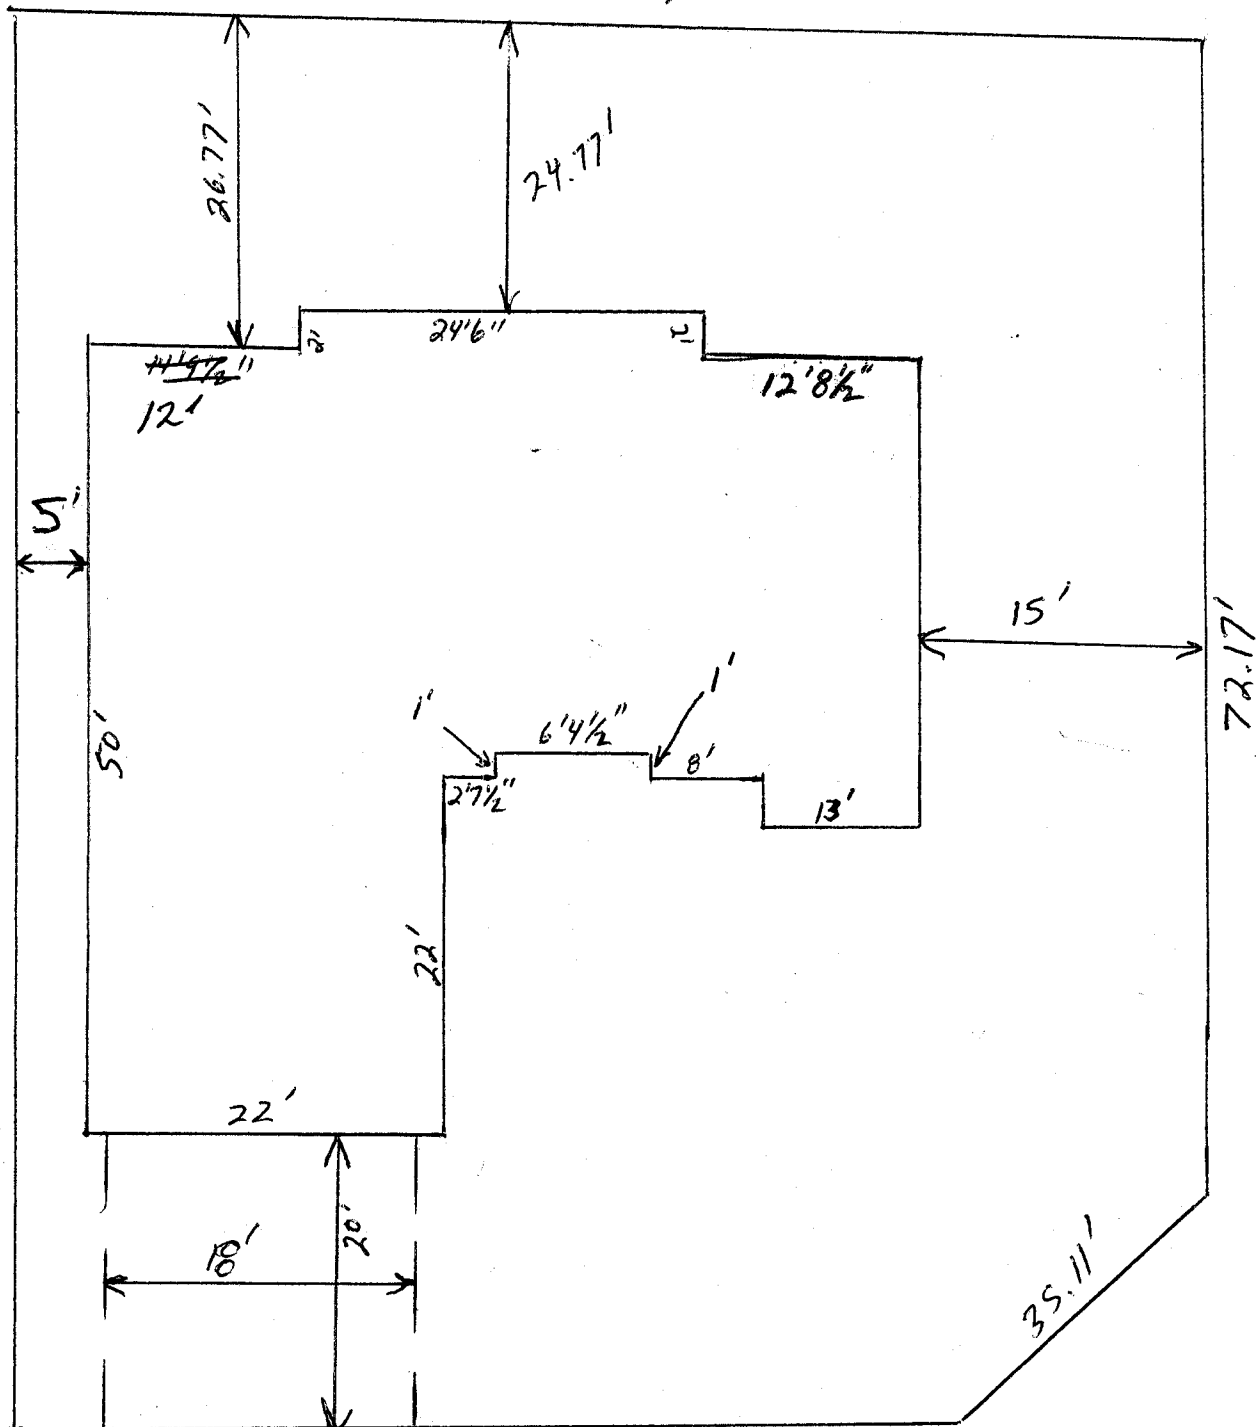

Presley Ave.

876 NORMA JEAN STREET

6-5-03

ACCEPTED *Gayle Henderson*
 ANY CHANGE OF SETBACKS MUST BE APPROVED BY THE CITY PLANNING DEPT. IT IS THE APPLICANT'S RESPONSIBILITY TO PROPERLY LOCATE AND IDENTIFY EASEMENTS AND PROPERTY LINES.

96.11

218.2