
THE & M M		ADANCE (V BLDG PERMIT NO. 9/034
FEE \$ /0.00	PLANNING CLE (Single Family Residential and	
TCP \$	(Single Family Residential and Community Developn	
SIF\$	24901	
Building Address	350 Rana Roap	No. of Existing Bldgs Proposed
Parcel No. 2940	-174-3900-1	Sq. Ft. of Existing Bldgs 200 Proposed 200
Subdivision	BLEETTHE RIDER	ESSq. Ft. of Lot / Parcel
Filing	Block 2 Lot	Sq. Ft. Coverage of Lot by Structures & Impervious Surface (Total Existing & Proposed)
OWNER INFORMATI	ON:	DESCRIPTION OF WORK & INTENDED USE:
Name HAFE	KATHALEEL KECKE	R
Address 1 <u>350</u>	Konla Rono	New Single Family Home (*check type below) Interior Remodel Other (please specify):
City / State / Zip	4. 60 61503	*TYPE OF HOME PROPOSED:
	IATION: SAME	
Name	and the second second	Site Built Manufactured Home (UBC) Manufactured Home (HUD) Other (please specify):
Address	· · · · · · · · · · · · · · · · · · ·	
City / State / Zip		NOTES BASEMENT REMODEL
Telephone <u>970</u>	2418278	( conterior Only)
REQUIRED: One plot µ		existing & proposed structure location(s), parking, setbacks to all
REQUIRED: One plot µ property lines, ingress	/egress to the property, driveway loca	ation & width & all easements & rights-of-way which abut the parcel.
REQUIRED: One plot property lines, ingress	/egress to the property, driveway loca	ation & width & all easements & rights-of-way which abut the parcel.
REQUIRED: One plot µ property lines, ingress	/egress to the property, driveway loca	Ation & width & all easements & rights-of-way which abut the parcel. MMUNITY DEVELOPMENT DEPARTMENT STAFF  Maximum coverage of lot by structures
REQUIRED: One plot property lines, ingress	/egress to the property, driveway loca	ation & width & all easements & rights-of-way which abut the parcel.
REQUIRED: One plot p property lines, ingress THIS SEC ZONE	/egress to the property, driveway loca CTION TO BE COMPLETED BY CO	Action & width & all easements & rights-of-way which abut the parcel.
REQUIRED: One plot p property lines, ingress THIS SEC ZONE	/egress to the property, driveway loca CTION TO BE COMPLETED BY CO from property line (PL) n PL Rear from PL	Action & width & all easements & rights-of-way which abut the parcel.  MMUNITY DEVELOPMENT DEPARTMENT STAFF Maximum coverage of lot by structures Permanent Foundation Required: YESNO Parking Requirement Range allow
REQUIRED: One plot property lines, ingress	/egress to the property, driveway loca CTION TO BE COMPLETED BY CO from property line (PL) n PL Rear from PL	Action & width & all easements & rights-of-way which abut the parcel.  MMUNITY DEVELOPMENT DEPARTMENT STAFF Maximum coverage of lot by structures Permanent Foundation Required: YES NO Parking Requirement Range cullow Special Conditions May not be used as a
REQUIRED: One plot property lines, ingress	/egress to the property, driveway loca CTION TO BE COMPLETED BY CO from property line (PL) PL Rear from PL tructure(s) Driveway Location Approval	Ation & width & all easements & rights-of-way which abut the parcel. MMUNITY DEVELOPMENT DEPARTMENT STAFF Maximum coverage of lot by structures Permanent Foundation Required: YES NO Parking Requirement Parage allow Special Conditions May not be used as a seperate dwelling unit. Wet Ba
REQUIRED: One plot p property lines, ingress THIS SEC ZONE	/egress to the property, driveway loca CTION TO BE COMPLETED BY CO from property line (PL) a PL Rear from PL tructure(s) Driveway Location Approval (Engineer's Initi Planning Clearance must be approved	Ation & width & all easements & rights-of-way which abut the parcel. MMUNITY DEVELOPMENT DEPARTMENT STAFF Maximum coverage of lot by structures Permanent Foundation Required: YES NO Parking Requirement Range allow Special Conditions May not be used as a seperate durilling unit. Wet Ba Seperate durilling unit. Wet Ba Mais) Sente, dishwashen Hudge Me. ed, in writing, by the Community Development Department. The
REQUIRED: One plot property lines, ingress THIS SEC ZONE SETBACKS: Front Side from Maximum Height of S Voting District Modifications to this P structure authorized b	/egress to the property, driveway loca CTION TO BE COMPLETED BY CO from property line (PL) a PL Rear from PL tructure(s) Driveway Location Approval (Engineer's Initi Planning Clearance must be approve by this application cannot be occupie	Ation & width & all easements & rights-of-way which abut the parcel. MMUNITY DEVELOPMENT DEPARTMENT STAFF Maximum coverage of lot by structures Permanent Foundation Required: YES NO Parking Requirement Required: YES NO Parking Requirement Required as a Special Conditions May not be used as a special Conditions been completed and a Certificate of
REQUIRED: One plot property lines, ingress THIS SEC ZONE	/egress to the property, driveway loca CTION TO BE COMPLETED BY CO from property line (PL) PL Rear from PL tructure(s) from PL Driveway Location Approval (Engineer's Initi Planning Clearance must be approve by this application cannot be occupie issued, if applicable, by the Building	Ation & width & all easements & rights-of-way which abut the parcel. MMUNITY DEVELOPMENT DEPARTMENT STAFF Maximum coverage of lot by structures Permanent Foundation Required: YES NO Parking Requirement Parcel as a Special Conditions May not be used as a
REQUIRED: One plot p property lines, ingress THIS SEC ZONE	/egress to the property, driveway loca CTION TO BE COMPLETED BY CO from property line (PL) a PL Rearfrom PL tructure(s)from PL Driveway Location Approval(Engineer's Initi Planning Clearance must be approve by this application cannot be occupie issued, if applicable, by the Building that I have read this application and	Ation & width & all easements & rights-of-way which abut the parcel. MMUNITY DEVELOPMENT DEPARTMENT STAFF 
REQUIRED: One plot property lines, ingress THIS SEC ZONE	degress to the property, driveway local     CTION TO BE COMPLETED BY CO     from property line (PL)     from property line (PL)     Rear from PL     tructure(s)     Driveway     Location Approval     (Engineer's Initi Planning Clearance must be approve     y this application cannot be occupie     issued, if applicable, by the Building     that I have read this application and     wations or restrictions which apply to     ide but not necessarily be limited to     wather to build to build to build to build to build to     wather to build to     wather to build to build to build to     wather to build to build to build to     wather to build to build to build to build to     wather to build	Ation & width & all easements & rights-of-way which abut the parcel. MMUNITY DEVELOPMENT DEPARTMENT STAFF 
REQUIRED: One plot property lines, ingress THIS SEC ZONE	degress to the property, driveway local     CTION TO BE COMPLETED BY CO     from property line (PL)     from property line (PL)     Rear from PL     tructure(s)     Driveway     Location Approval     (Engineer's Initi Planning Clearance must be approve     y this application cannot be occupie     issued, if applicable, by the Building     that I have read this application and     wations or restrictions which apply to     locature to     way     Locature to     way     and the property be limited to     way     and the property line (PL)	Ation & width & all easements & rights-of-way which abut the parcel. MMUNITY DEVELOPMENT DEPARTMENT STAFF Maximum coverage of lot by structures Permanent Foundation Required: YES NO Parking Requirement Parage allow Special Conditions May not be used as a special Conditions May not be used of a bed, in writing, by the Community Development Depertment. The d until a final inspection has been completed and a Certificate of Department (Section 305, Uniform Building Code). the information is correct; I agree to comply with any and all codes, the project. I understand that failure to comply shall result in legal non-use of the building(s). Date
REQUIRED: One plot property lines, ingress THIS SEC ZONE	degress to the property, driveway local     CTION TO BE COMPLETED BY CO     from property line (PL)     from property line (PL)     Rear from PL     tructure(s)     Driveway     Location Approval     (Engineer's Initi Planning Clearance must be approve     y this application cannot be occupie     issued, if applicable, by the Building     that I have read this application and     wations or restrictions which apply to     location Approval     that I have read this application and     wations or restrictions which apply to     here a the approve a structure to	Ation & width & all easements & rights-of-way which abut the parcel.
REQUIRED: One plot property lines, ingress THIS SEC ZONE	degress to the property, driveway local     CTION TO BE COMPLETED BY CO     from property line (PL)     from property line (PL)     Rear from PL     tructure(s)     Driveway     Location Approval     (Engineer's Initi Planning Clearance must be approve     y this application cannot be occupie     issued, if applicable, by the Building     that I have read this application and     wations or restrictions which apply to     locature to     way     Locature to     way     and the property be limited to     way     and the property line (PL)	Ation & width & all easements & rights-of-way which abut the parcel. MMUNITY DEVELOPMENT DEPARTMENT STAFF Maximum coverage of lot by structures Permanent Foundation Required: YES NO Parking Requirement NO Pangl allow Special Conditions May not be used as a seperate duvelling unit. West Ba seperate duvelling unit. West Ba alis) Serve, dishursher Ander Me. ed, in writing, by the Community Development Department. The d until a final inspection has been completed and a Certificate of Department (Section 305, Uniform Building Code). the information is correct; I agree to comply with any and all codes, the project. I understand that failure to comply shall result in legal non-use of the building(s). Date <u>9-4-03</u>

(Pink: Building Department) (Goldenrod: Utility Accounting) 1

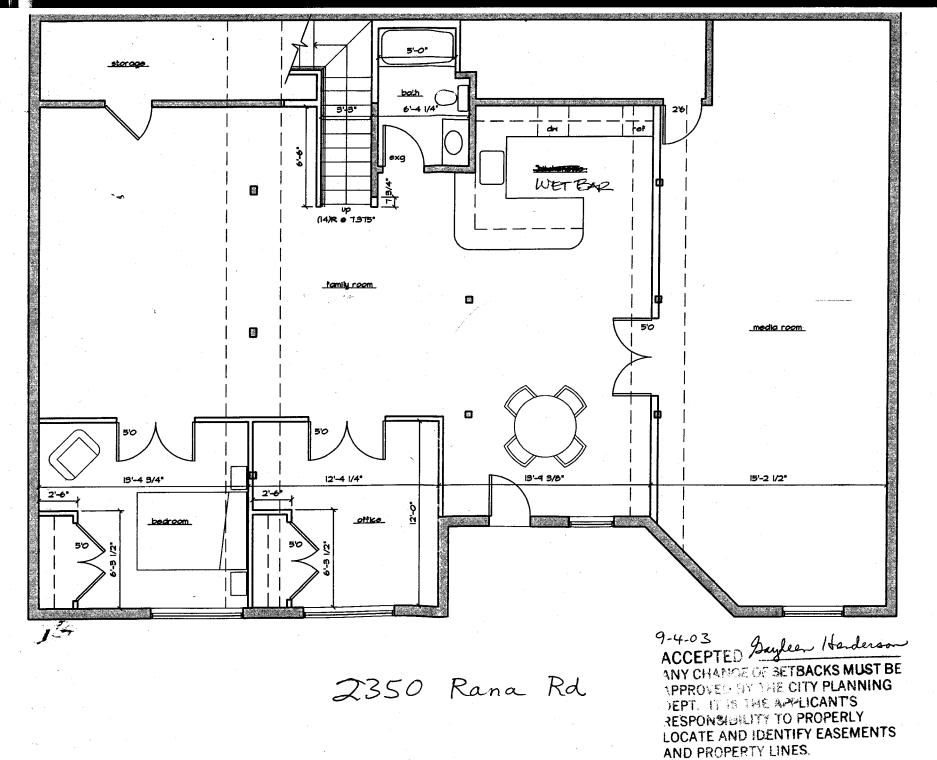

.

•

## **Cobblestone Ridges Subdivision Architectural Review Committee**

c/o Sharon Weingardt 397 Butte Court Grand Junction, CO 81503

ś

## **Plan Review Application**

Applicant: Jeff & Kathalun Recker Date:
ApplicantAddress: 2350 Kana Rd Phone:
City: Frand Oct_ State: CO Zip: 81523 Contact Jally Constructe
ProjectAddress: 3350 Rana Rd.
Project Type: <u>Lemadel basement</u> Proposed Start Date
Remarks:
Plan Review Results Approved By: Date: <u>D9-03-03</u> For the Architectural Review Committee Remarks: <u>remadel</u> hasement approved
Or
Denied By:Date:
For the Architectural Review Committee
Remarks: