

FEE \$ <u>500</u>
TCP \$
SIF \$

PLANNING CLEARANCE
 (Single Family Residential and Accessory Structures)
Community Development Department

BLDG PERMIT NO. _____



Building Address 1160 Road Ave
 Parcel No. 2945-144-12-020
 Subdivision City of GJ
 Filing _____ Block 89 Lot 18

No. of Existing Bldgs 1 Proposed _____
 Sq. Ft. of Existing Bldgs 1007 Proposed _____
 Sq. Ft. of Lot / Parcel 6400 +/- 6316.2
 Sq. Ft. Coverage of Lot by Structures & Impervious Surface
 (Total Existing & Proposed) 1007

OWNER INFORMATION:

Name Eric T. Paulson
 Address 1160 Road Ave
 City / State / Zip GJ, CO 81501

DESCRIPTION OF WORK & INTENDED USE:

- New Single Family Home (*check type below)
 Interior Remodel Addition
 Other (please specify): Demolition front & rear porches.

***TYPE OF HOME PROPOSED:**

- Site Built Manufactured Home (UBC)
 Manufactured Home (HUD)
 Other (please specify): _____

APPLICANT INFORMATION:

Name Eric T. Paulson
 Address 1160 Road Ave
 City / State / Zip GJ, CO 81501
 Telephone 970 250-7080

NOTES: _____

REQUIRED: One plot plan, on 8 1/2" x 11" paper, showing all existing & proposed structure location(s), parking, setbacks to all property lines, ingress/egress to the property, driveway location & width & all easements & rights-of-way which abut the parcel.

THIS SECTION TO BE COMPLETED BY COMMUNITY DEVELOPMENT DEPARTMENT STAFF

ZONE <u>RMF-8</u>	Maximum coverage of lot by structures <u>70%</u>
SETBACKS: Front <u>20/25</u> from property line (PL)	Permanent Foundation Required: YES <input checked="" type="checkbox"/> NO _____
Side <u>5/3</u> from PL Rear <u>10/5</u> from PL	Parking Requirement <u>2</u>
Maximum Height of Structure(s) <u>35'</u>	Special Conditions _____
Voting District _____	Driveway Location Approval _____ (Engineer's Initials)


Modifications to this Planning Clearance must be approved, in writing, by the Community Development Department. The structure authorized by this application cannot be occupied until a final inspection has been completed and a Certificate of Occupancy has been issued, if applicable, by the Building Department (Section 305, Uniform Building Code).

I hereby acknowledge that I have read this application and the information is correct; I agree to comply with any and all codes, ordinances, laws, regulations or restrictions which apply to the project. I understand that failure to comply shall result in legal action, which may include but not necessarily be limited to non-use of the building(s).


Applicant Signature [Signature] Date 11/05/03
 Department Approval [Signature] Date 11/5/03

Additional water and/or sewer tap fee(s) are required:	YES	NO	W/O No. <u>demolition</u>
Utility Accounting <u>[Signature]</u>	Date <u>11-5-03</u>		

VALID FOR SIX MONTHS FROM DATE OF ISSUANCE (Section 2.2.C.1 Grand Junction Zoning & Development Code)
 (White: Planning) (Yellow: Customer) (Pink: Building Department) (Goldenrod: Utility Accounting)

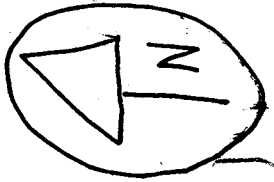

12th Street

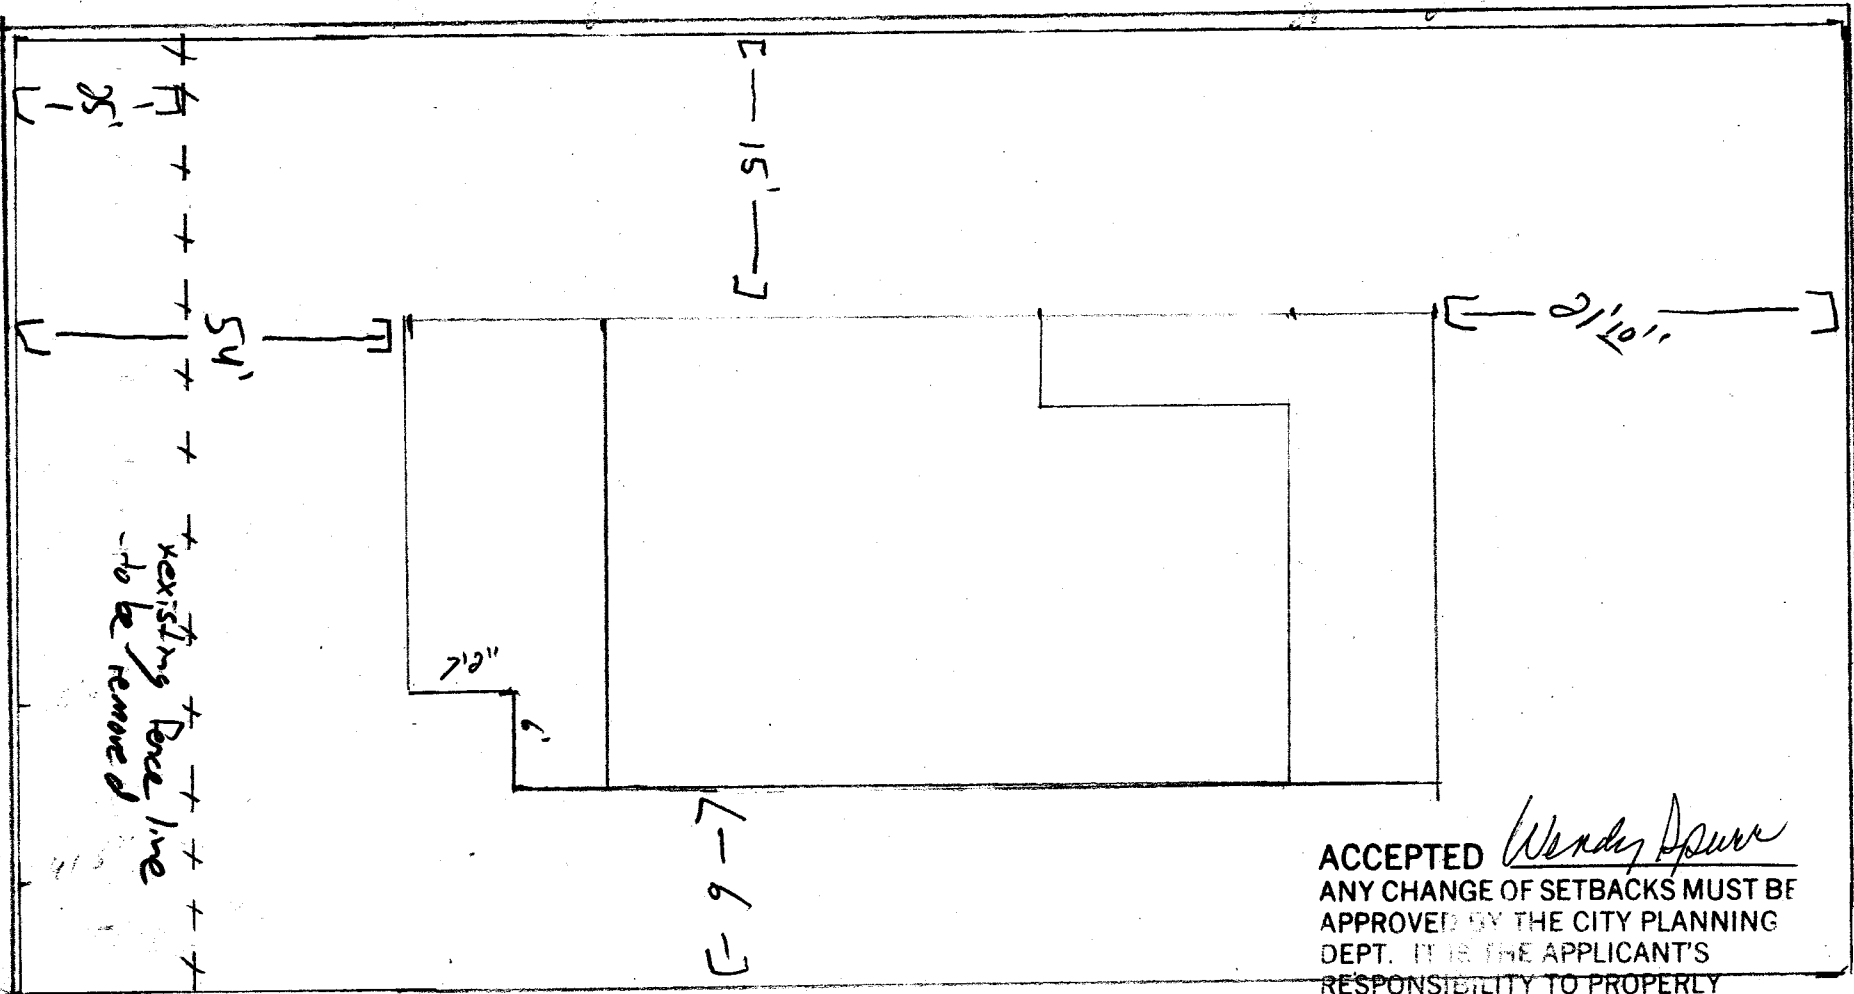

Paved Alley

Road Ave

ACCEPTED *Wendy Spurr*
 ANY CHANGE OF SETBACKS MUST BE APPROVED BY THE CITY PLANNING DEPT. IT IS THE APPLICANT'S RESPONSIBILITY TO PROPERLY LOCATE AND IDENTIFY EASEMENTS AND PROPERTY LINES.