FEE \$ 10.00 PLANNING CLEAF	RANCE BLDG PERMIT NO. 90941			
TCP \$ 5 00.00(Single Family Residential and AcceSIF \$ 3 9 2.00Community Development				
n de la constante de la constan En constante de la constante de	Your Bridge to a Better Community			
BLDG ADDRESS 710 SCOTORS GR. SQ.F	T. OF PROPOSED BLDGS/ADDITION			
TAX SCHEDULE NO. 2 201 - 334 - 36-057 SQ. F				
SUBDIVISION FOUNTAIN GROWS TOTA	SQ. FT. OF EXISTING & PROPOSED 1353			
	F DWELLING UNITS:			
(1) OWNER TUNIAN GROWS GAC NO. O	<ul> <li>∴ After: this Construction</li> <li>F BUILDINGS ON PARCEL</li> <li>∴ After: this Construction</li> </ul>			
(1) ADDRESS (1) ADDRESS (1) ADDRESS (2) ADDRESS _				
(1) TELEPHONE $(\sqrt{03})$ 442 - $\sqrt{375}$	OF EXISTING BUILDINGS			
(2) APPLICANT SKALTON CONSTRUCTION / DESCH	RIPTION OF WORK & INTENDED USE Signa FAMICY			
A R Maria TYPE	OF HOME PROPOSED:			
<sup>(2)</sup> TELEPHONE (970) 245-9008	Manufactured Home (HUD) Other (please specify)			
REQUIRED: One plot plan, on 8 ½" x 11" paper, showing all existing & proposed structure location(s), parking, setbacks to all property lines, ingress/egress to the property, driveway location & width & all easements & rights-of-way which abut the parcel.				
THIS SECTION TO BE COMPLETED BY COMMUN	ITY DEVELOPMENT DEPARTMENT STAFF 🐲			
	Maximum coverage of lot by structures <u>bldg emulipe</u>			
SETBACKS: Front from property line (PL)	Permanent Foundation Required: YES X NO			
or from center of ROW, whichever is greater	Parking Req'mt			
Side from PL, Rear from PL	Special Conditions			
Maximum Height	CENSUS_B			

Modifications to this Planning Clearance must be approved, in writing, by the Community Development Department. The structure authorized by this application cannot be occupied until a final inspection has been completed and a Certificate of Occupancy has been issued, if applicable, by the Building Department (Section 305, Uniform Building Code).


I hereby acknowledge that I have read this application and the information is correct; I agree to comply with any and all codes, ordinances, laws, regulations or restrictions which apply to the project. I understand that failure to comply shall result in legal action, which may include but pot necessarily be lipsited to non-use of the building(s).

Applicant Signature	Date 8/14/03
Department Approval 46. Romie Edwards	Date 8/22/03
Additional water and/or sewer tap fee(s) are required: YES	NO W/O No. 6265
Utility Accounting A Cover	Date 5/2263

VALID FOR SIX MONTHS FROM DATE OF ISSUANCE (Section 9-3-2C Grand Junction Zoning & Development Code)

(White: Planning)	(Yellow: Customer)	(Pink: Building Department)
-------------------	--------------------	-----------------------------

(Goldenrod: Utility Accounting)

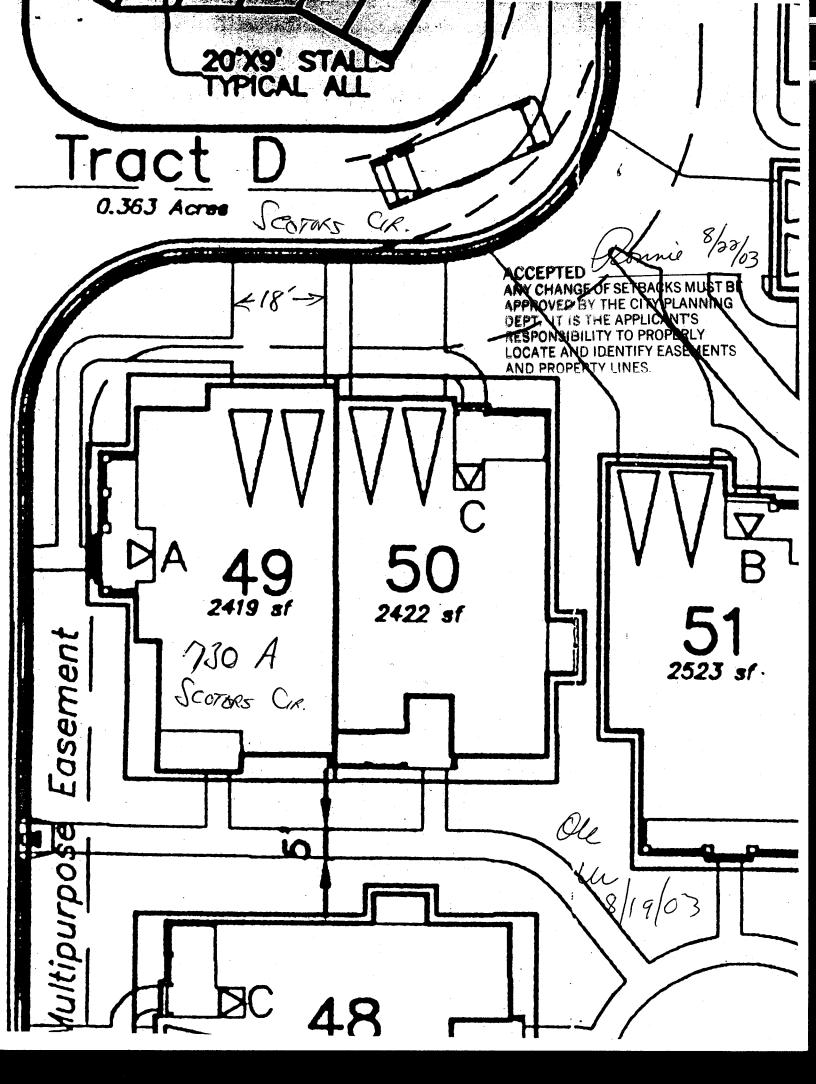

.