

FEE \$	10.00
TCP \$	500.00
SIF \$	292.00

**PLANNING CLEARANCE** <sup>(a)</sup>  
 (Single Family Residential and Accessory Structures)  
Community Development Department

BLDG PERMIT NO. 900257



Your Bridge to a Better Community

BLDG ADDRESS ~~386~~ 386 Sorrel SQ. FT. OF PROPOSED BLDGS/ADDITION 1656  
 TAX SCHEDULE NO. 2943-191-20-012 SQ. FT. OF EXISTING BLDGS         
 SUBDIVISION White Willow TOTAL SQ. FT. OF EXISTING & PROPOSED 1656  
 FILING 1 BLK 11 LOT 12 NO. OF DWELLING UNITS:  
 Before: 0 After: 1 this Construction  
 (1) OWNER TML ENTERPRISES INC NO. OF BUILDINGS ON PARCEL  
 Before: 0 After: 1 this Construction  
 (1) ADDRESS P.O. Box 2569 USE OF EXISTING BUILDINGS N/A  
 (1) TELEPHONE 245-9271 DESCRIPTION OF WORK & INTENDED USE New home Const  
 (2) APPLICANT TML ENTERPRISES INC TYPE OF HOME PROPOSED:  
 (2) ADDRESS P.O. Box 2569  Site Built  Manufactured Home (UBC)  
 (2) TELEPHONE 245-9271  Manufactured Home (HUD)  
 Other (please specify) \_\_\_\_\_

**REQUIRED: One plot plan, on 8 1/2" x 11" paper, showing all existing & proposed structure location(s), parking, setbacks to all property lines, ingress/egress to the property, driveway location & width & all easements & rights-of-way which abut the parcel.**

**THIS SECTION TO BE COMPLETED BY COMMUNITY DEVELOPMENT DEPARTMENT STAFF**

ZONE RSF-4 Maximum coverage of lot by structures 50%  
 SETBACKS: Front 20' from property line (PL) Permanent Foundation Required: YES  NO   
 or \_\_\_\_\_ from center of ROW, whichever is greater  
 Side 7' from PL, Rear 25' from PL Parking Req'mt \_\_\_\_\_  
 Maximum Height 35' Special Conditions Eng. foundation req'd  
 "E" CENSUS \_\_\_\_\_ TRAFFIC \_\_\_\_\_ ANN# \_\_\_\_\_

Modifications to this Planning Clearance must be approved, in writing, by the Community Development Department. The structure authorized by this application cannot be occupied until a final inspection has been completed and a Certificate of Occupancy has been issued, if applicable, by the Building Department (Section 305, Uniform Building Code).


I hereby acknowledge that I have read this application and the information is correct; I agree to comply with any and all codes, ordinances, laws, regulations or restrictions which apply to the project. I understand that failure to comply shall result in legal action, which may include but not necessarily be limited to non-use of the building(s).

Applicant Signature [Signature] Date 6/25/03  
 Department Approval [Signature] Date 8/21/03

Additional water and/or sewer tap fee(s) are required:	YES <input checked="" type="checkbox"/>	NO	W/O No. <u>16461</u>
Utility Accounting <u>[Signature]</u>	Date <u>8-21-03</u>		


VALID FOR SIX MONTHS FROM DATE OF ISSUANCE (Section 9-3-2C Grand Junction Zoning & Development Code)

(White: Planning) (Yellow: Customer) (Pink: Building Department) (Goldenrod: Utility Accounting)

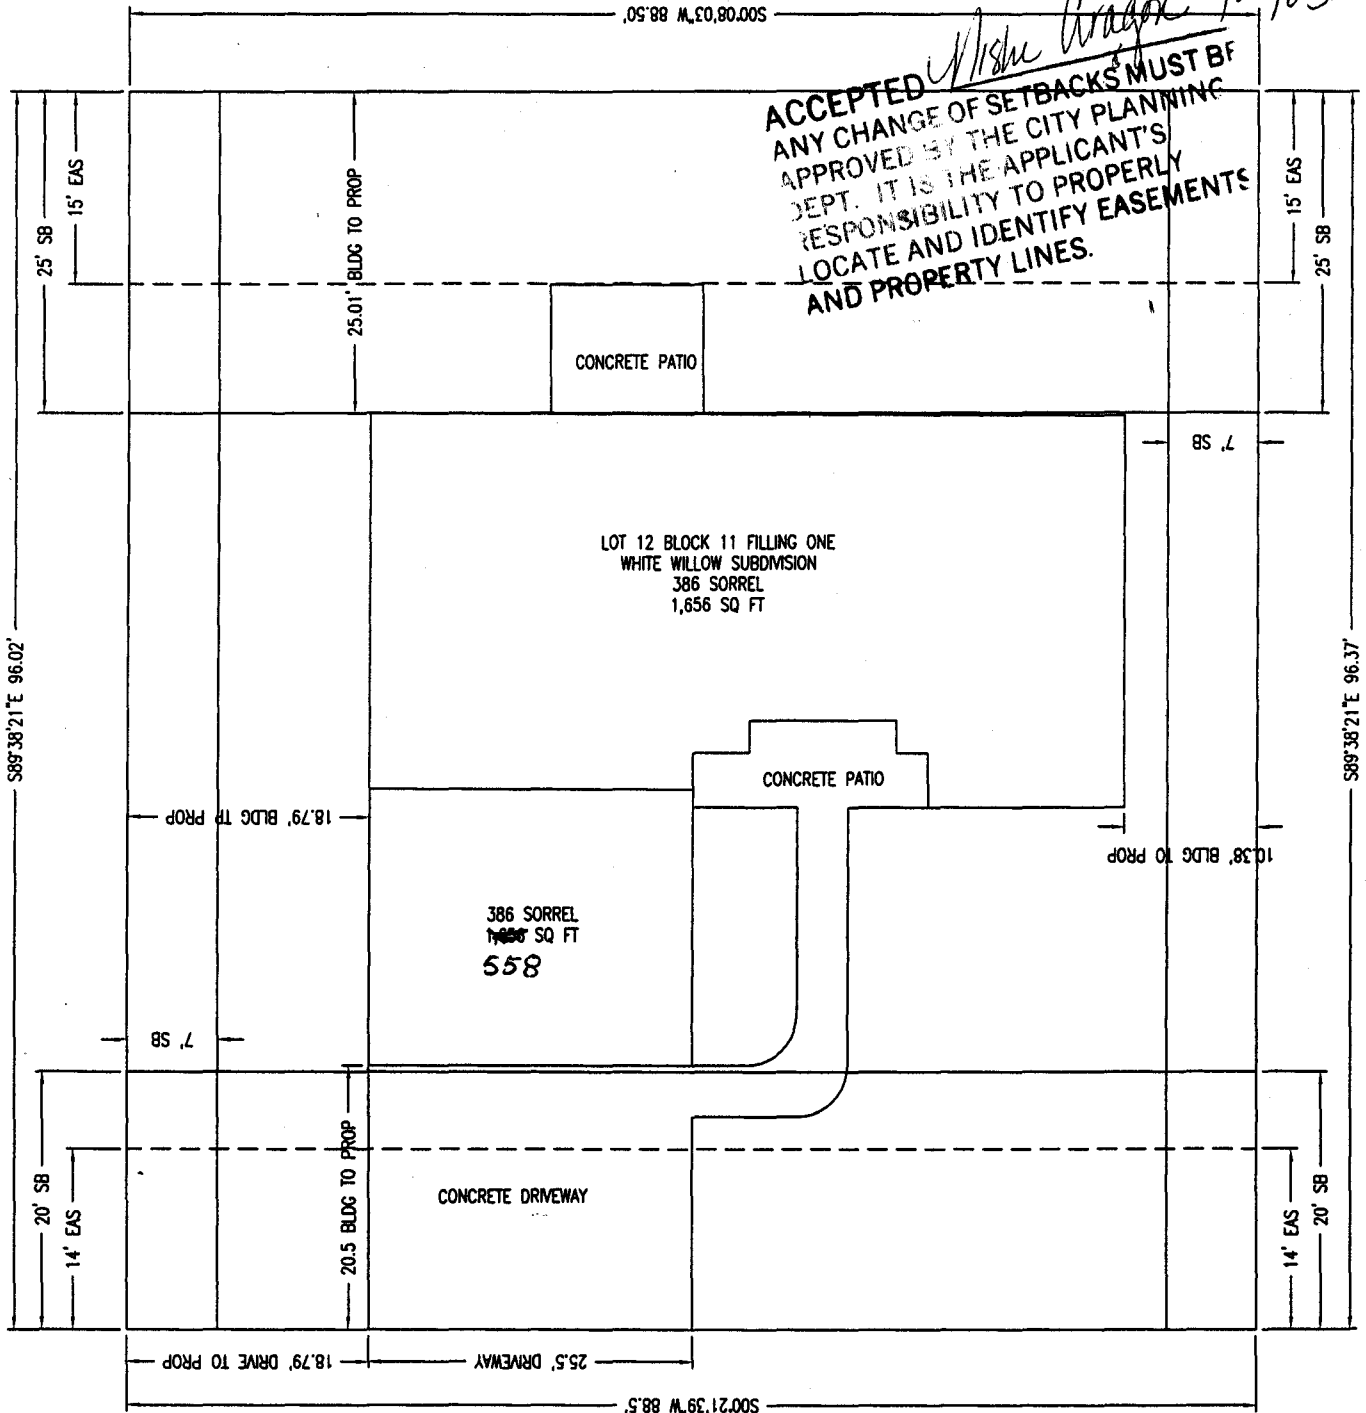

**ACCEPTED** *Wishu Aragon* 8/21/03  
 ANY CHANGE OF SETBACKS MUST BE APPROVED BY THE CITY PLANNING DEPT. IT IS THE APPLICANT'S RESPONSIBILITY TO PROPERLY LOCATE AND IDENTIFY EASEMENTS AND PROPERTY LINES.

SORREL STREET

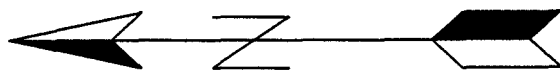

*W*  
*7/30/07*