

FEE \$	10.00
TCP \$	0
SIF \$	292.00

PLANNING CLEARANCE
 (Single Family Residential and Accessory Structures)
Community Development Department

BLDG PERMIT NO. 88232



Your Bridge to a Better Community

BLDG ADDRESS 2437 Spanish Hills Ct SQ. FT. OF PROPOSED BLDGS/ADDITION 1646
 TAX SCHEDULE NO. 2701-333-06-013 SQ. FT. OF EXISTING BLDGS 0
 SUBDIVISION Spanish Trails TOTAL SQ. FT. OF EXISTING & PROPOSED 1646
 FILING 2 BLK 7 LOT 13 NO. OF DWELLING UNITS:
 Before: 0 After: 1 this Construction
 (1) OWNER Roy & Cynthia Skults NO. OF BUILDINGS ON PARCEL
 Before: 0 After: 1 this Construction
 (1) ADDRESS 4 1/2 Prospectors Point USE OF EXISTING BUILDINGS _____
 (1) TELEPHONE 260-8080 DESCRIPTION OF WORK & INTENDED USE New House
 (2) APPLICANT Same TYPE OF HOME PROPOSED:
 (2) ADDRESS _____ Site Built _____ Manufactured Home (UBC)
 (2) TELEPHONE _____ _____ Manufactured Home (HUD)
 _____ Other (please specify) _____

REQUIRED: One plot plan, on 8 1/2" x 11" paper, showing all existing & proposed structure location(s), parking, setbacks to all property lines, ingress/egress to the property, driveway location & width & all easements & rights-of-way which abut the parcel.

THIS SECTION TO BE COMPLETED BY COMMUNITY DEVELOPMENT DEPARTMENT STAFF

ZONE PD Maximum coverage of lot by structures 60%
 SETBACKS: Front 20' from property line (PL) Permanent Foundation Required: YES NO _____
 or _____ from center of ROW, whichever is greater
 Side 5' from PL, Rear 20' from PL Parking Req'mt 2
 Maximum Height 32' Special Conditions _____
 CENSUS _____ TRAFFIC _____ ANNEX# _____

Modifications to this Planning Clearance must be approved, in writing, by the Community Development Department. The structure authorized by this application cannot be occupied until a final inspection has been completed and a Certificate of Occupancy has been issued, if applicable, by the Building Department (Section 305, Uniform Building Code).


I hereby acknowledge that I have read this application and the information is correct; I agree to comply with any and all codes, ordinances, laws, regulations or restrictions which apply to the project. I understand that failure to comply shall result in legal action, which may include but not necessarily be limited to non-use of the building(s).

Applicant Signature Roy Skults Date 2-19-03
 Department Approval G. Gaylen Henderson Date 2-24-03

Additional water and/or sewer tap fee(s) are required:	YES <input checked="" type="checkbox"/>	NO	W/O No <u>759</u>
Utility Accounting	<u>Other</u>	Date	<u>2-24-03</u>

VALID FOR SIX MONTHS FROM DATE OF ISSUANCE (Section 9-3-2C Grand Junction Zoning & Development Code)
 (White: Planning) (Yellow: Customer) (Pink: Building Department) (Goldenrod: Utility Accounting)

2-24-03
ACCEPTED *Gayle Anderson*
ANY CHANGE OF SETBACKS MUST BE
APPROVED BY THE CITY PLANNING
DEPT. IT IS THE APPLICANT'S
RESPONSIBILITY TO PROPERLY
LOCATE AND IDENTIFY EASEMENTS
AND PROPERTY LINES.

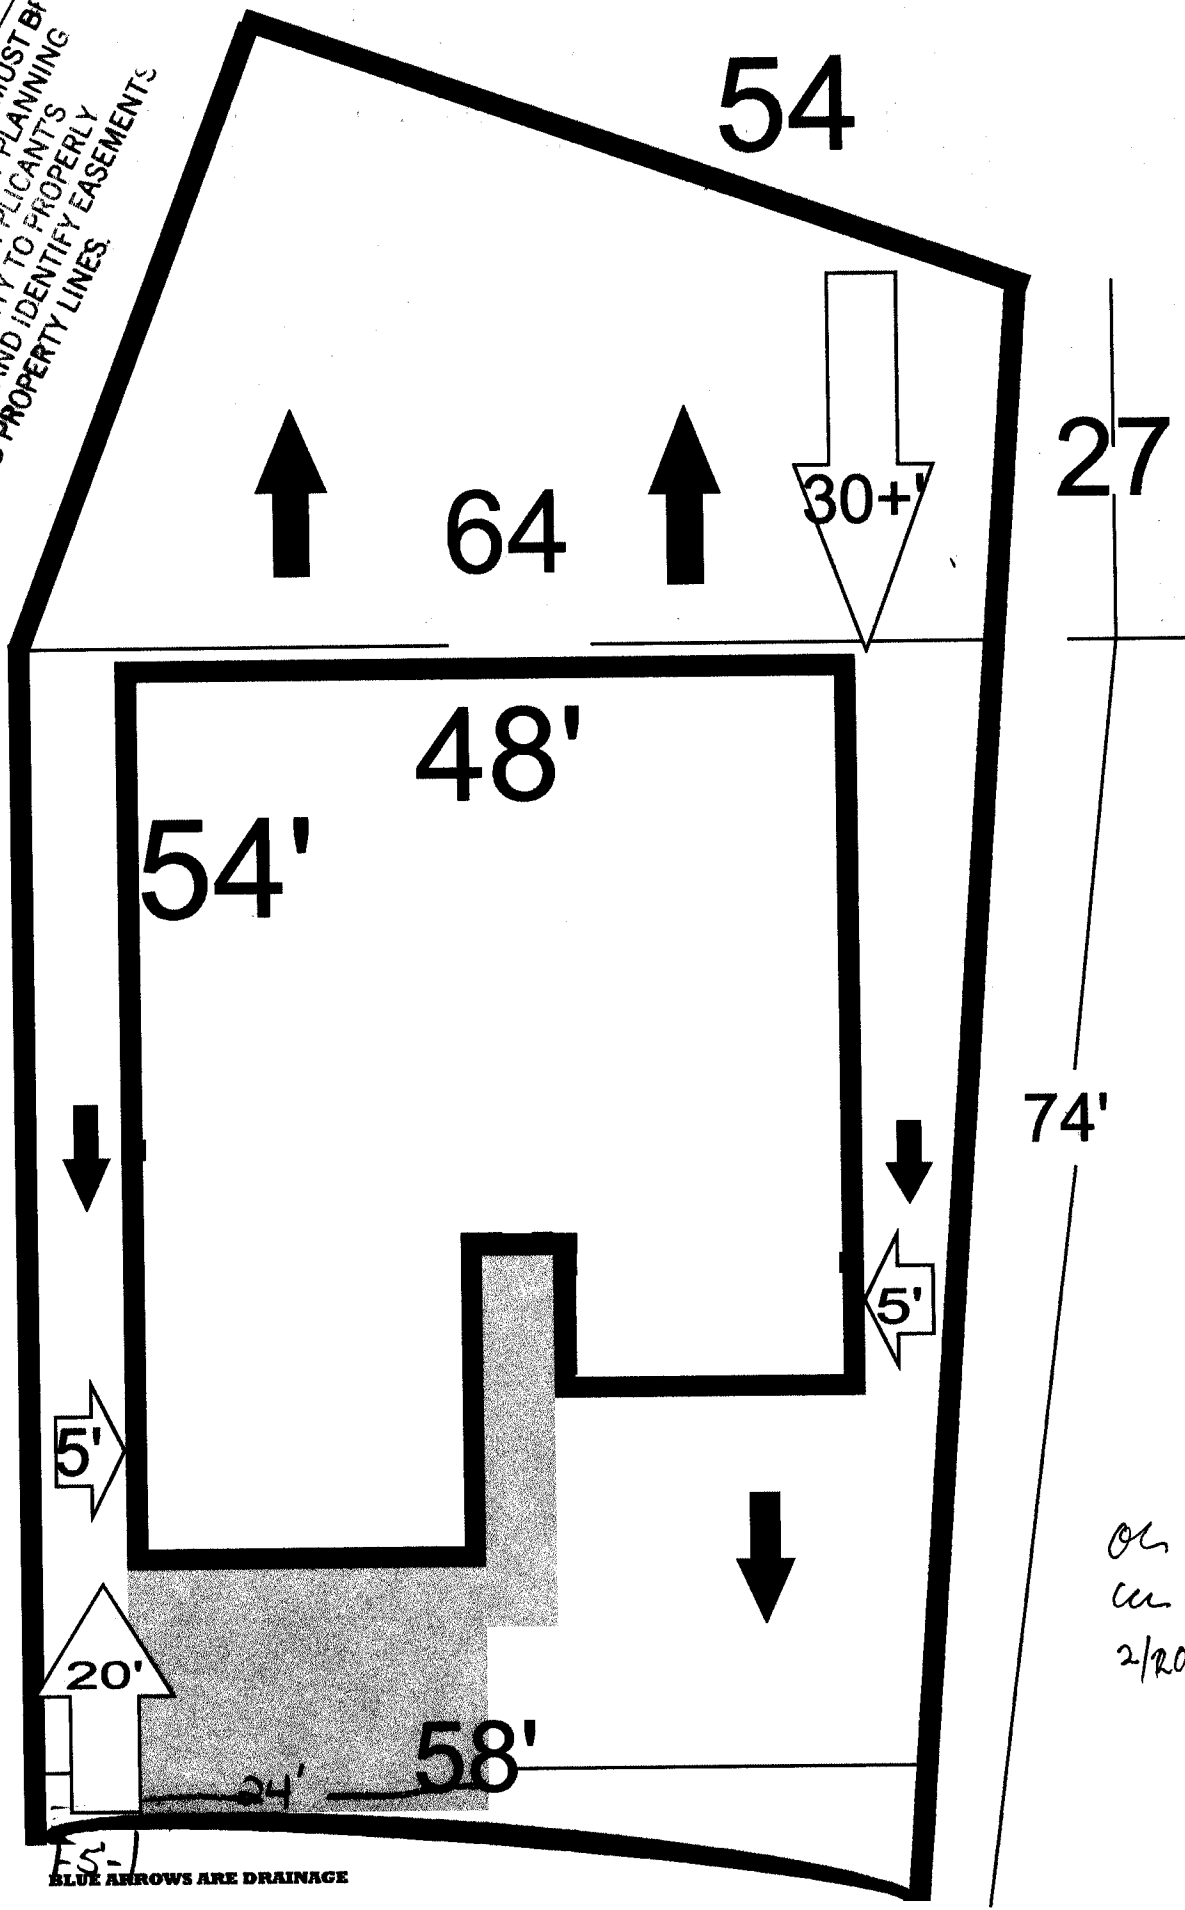

OK
ca
2/20/03

15-
BLUE ARROWS ARE DRAINAGE