

FEE \$	10.00
TCP \$	0
SIF \$	297.00

PLANNING CLEARANCE
 (Single Family Residential and Accessory Structures)
Community Development Department

BLDG PERMIT NO. 87687



Your Bridge to a Better Community

BLDG ADDRESS 2978 Summerbrook SQ. FT. OF PROPOSED BLDGS/ADDITION 1394 garage 420
 TAX SCHEDULE NO 2943-051-73-003 SQ. FT. OF EXISTING BLDGS _____
 SUBDIVISION Brookside TOTAL SQ. FT. OF EXISTING & PROPOSED 1814
 FILING 3 BLK 1 LOT 9 NO. OF DWELLING UNITS:
 Before: 0 After: 1 this Construction
 (1) OWNER Darter, LLC NO. OF BUILDINGS ON PARCEL
 Before: 0 After: 1 this Construction
 (1) ADDRESS 786 Valley Ct. USE OF EXISTING BUILDINGS _____
 (1) TELEPHONE 523-5555 DESCRIPTION OF WORK & INTENDED USE New home
 (2) APPLICANT Grace Homes TYPE OF HOME PROPOSED:
 (2) ADDRESS 786 Valley Ct. Site Built _____ Manufactured Home (UBC)
 (2) TELEPHONE 523-5555 _____ Manufactured Home (HUD)
 _____ Other (please specify) _____

REQUIRED: One plot plan, on 8 1/2" x 11" paper, showing all existing & proposed structure location(s), parking, setbacks to all property lines, ingress/egress to the property, driveway location & width & all easements & rights-of-way which abut the parcel.

THIS SECTION TO BE COMPLETED BY COMMUNITY DEVELOPMENT DEPARTMENT STAFF

ZONE PD Maximum coverage of lot by structures 3590
 SETBACKS: Front 20' from property line (PL) Permanent Foundation Required: YES NO _____
 or _____ from center of ROW, whichever is greater
 Side 5' from PL, Rear 20' from PL Parking Req'mt 2
 Maximum Height 32' Special Conditions _____
 CENSUS _____ TRAFFIC _____ ANN# _____

Modifications to this Planning Clearance must be approved, in writing, by the Community Development Department. The structure authorized by this application cannot be occupied until a final inspection has been completed and a Certificate of Occupancy has been issued, if applicable, by the Building Department (Section 305, Uniform Building Code).

I hereby acknowledge that I have read this application and the information is correct; I agree to comply with any and all codes, ordinances, laws, regulations or restrictions which apply to the project. I understand that failure to comply shall result in legal action, which may include but not necessarily be limited to non-use of the building(s).

Applicant Signature Monica Keta Date 1/13/03
 Department Approval Walter Wagner Date 1/13/03



Additional water and/or sewer tap fee(s) are required:	YES <input checked="" type="checkbox"/>	NO	W/O No. <u>15626</u>
Utility Accounting	<u>[Signature]</u>	Date	<u>1/13/03</u>

VALID FOR SIX MONTHS FROM DATE OF ISSUANCE (Section 9-3-2C Grand Junction Zoning & Development Code)
 (White: Planning) (Yellow: Customer) (Pink: Building Department) (Goldenrod: Utility Accounting)

ACCEPTED
 ANY CHANGE OF TRACKS MUST BE APPROVED BY THE PLANNING DEPT. IT IS THE APPLICANT'S RESPONSIBILITY TO PROPERLY LOCATE AND IDENTIFY EASEMENTS AND PROPERTY LINES.

Arthur Chagnon 1/13/03

2978
 Summer Brook
 Lot 9B1K1
 Scale 1=20
 12-24-02
 #7
 Cedarwood
 SO date
 01-02-03

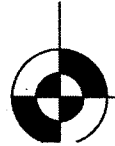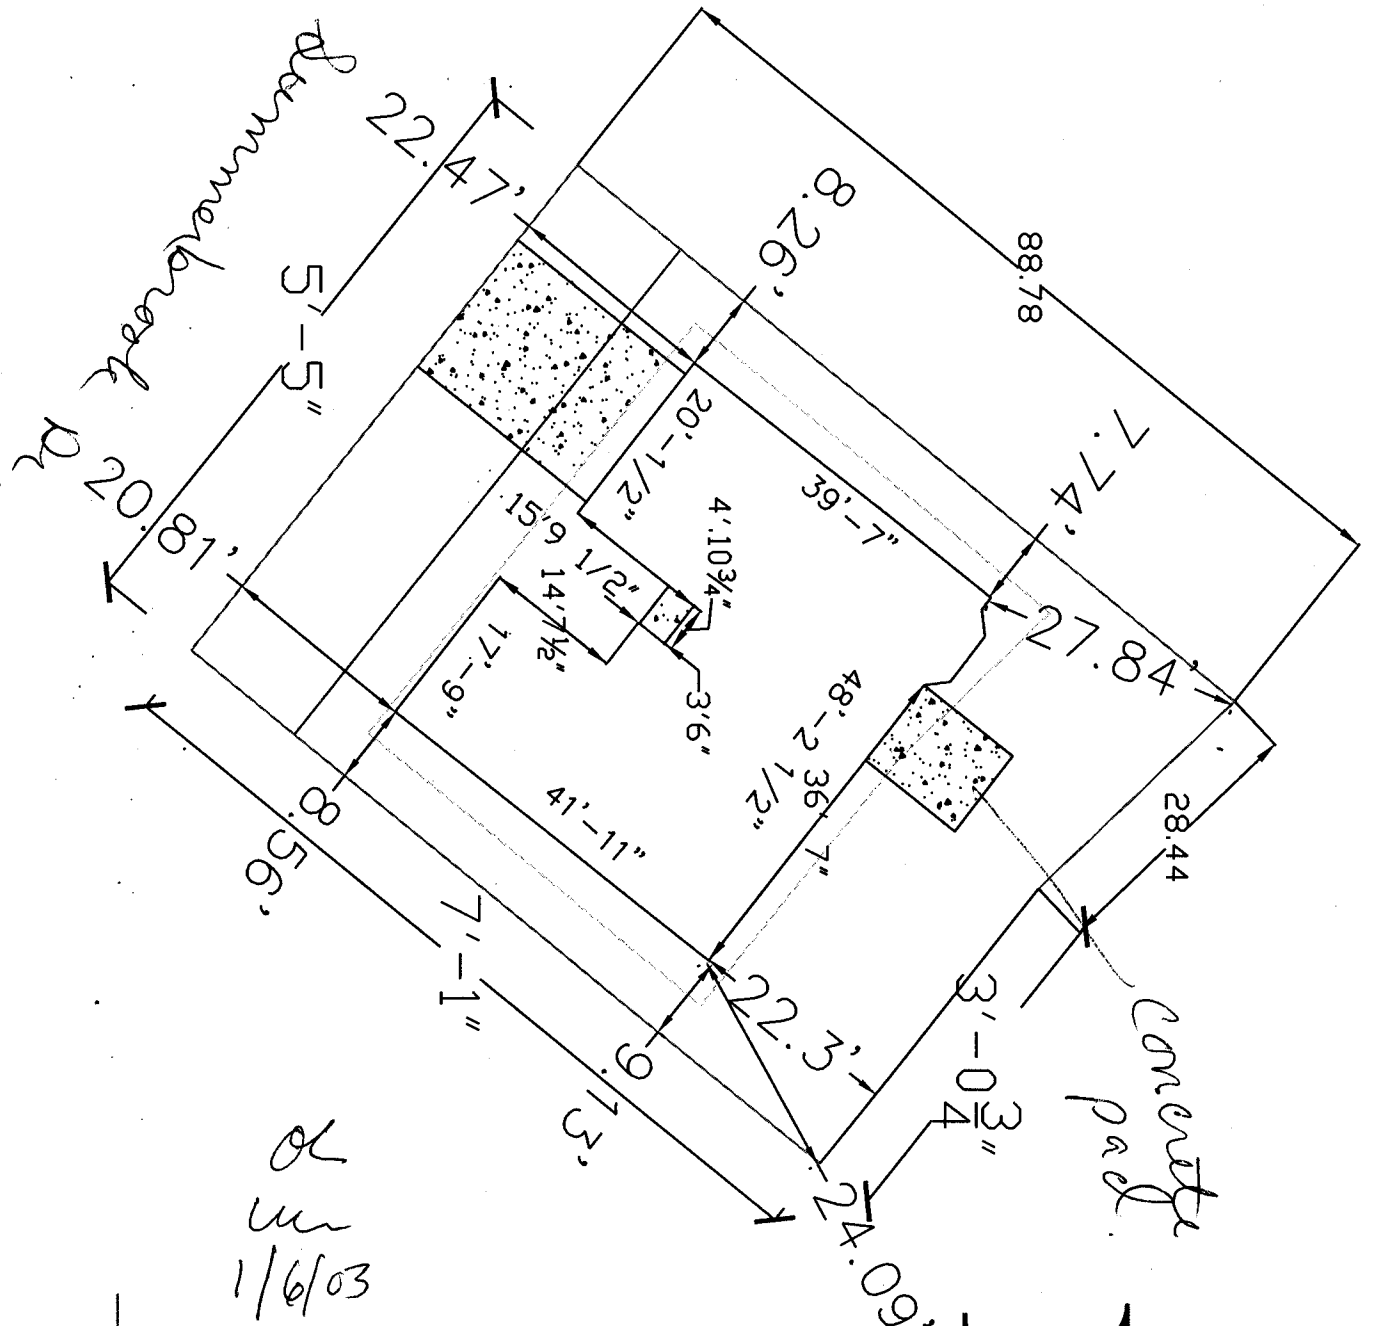

N