
FEE \$ 10,00PLANNING CITCP \$ 500,00(Single Family Residential and Community Develop)SIF \$ 292.00	nd Accessory Structures)
BLDG ADDRESS <u>7663 A Summeeerst CR</u> TAX SCHEDULE NO. <u>7701-266-31-002</u> SUBDIVISION <u>Scummerfill</u> FILING <u>BLK</u> LOT <u>7</u> (1) OWNER <u>60 Const</u> (1) ADDRESS <u>D.0 Box 1975</u> (1) TELEPHONE <u>743-6471</u> (2) APPLICANT <u>6796</u> (2) TELEPHONE	SQ. FT. OF PROPOSED BLDGS/ADDITION
property lines, ingress/egress to the property, driveway loo	All existing & proposed structure location(s), parking, setbacks to all cation & width & all easements & rights-of-way which abut the parcel DMMUNITY DEVELOPMENT DEPARTMENT STAFF Maximum coverage of lot by structures <u>50%</u> Permanent Foundation Required: YES NO Parking Req'mt <u>2</u> Special Conditions CENSUS TRAFFIC ANNX#
structure authorized by this application cannot be occupie Occupancy has been issued, if applicable, by the Building I hereby acknowledge that I have read this application and	red, in writing, by the Community Development Department. The ed until a final inspection has been completed and a Certificate of g Department (Section 305, Uniform Building Code). the information is correct; I agree to comply with any and all codes, o the project. I understand that failure to comply shall result in legal

Department Approval & C Taye Dibon	Date 1003
Additional water and/or sewer tap fee(s) are required: YES	NO W/O NO. / Stel9
Utility Accounting ABensley	Date ///0/03

VALID FOR SIX MONTHS FROM DATE OF ISSUANCE (Section 9-3-2C Grand Junction Zoning & Development Code)

(White: Planning)	(Yellow: Customer)	(Pink: Building Department)	(Goldenrod: Utility Accounting)
-------------------	--------------------	-----------------------------	---------------------------------

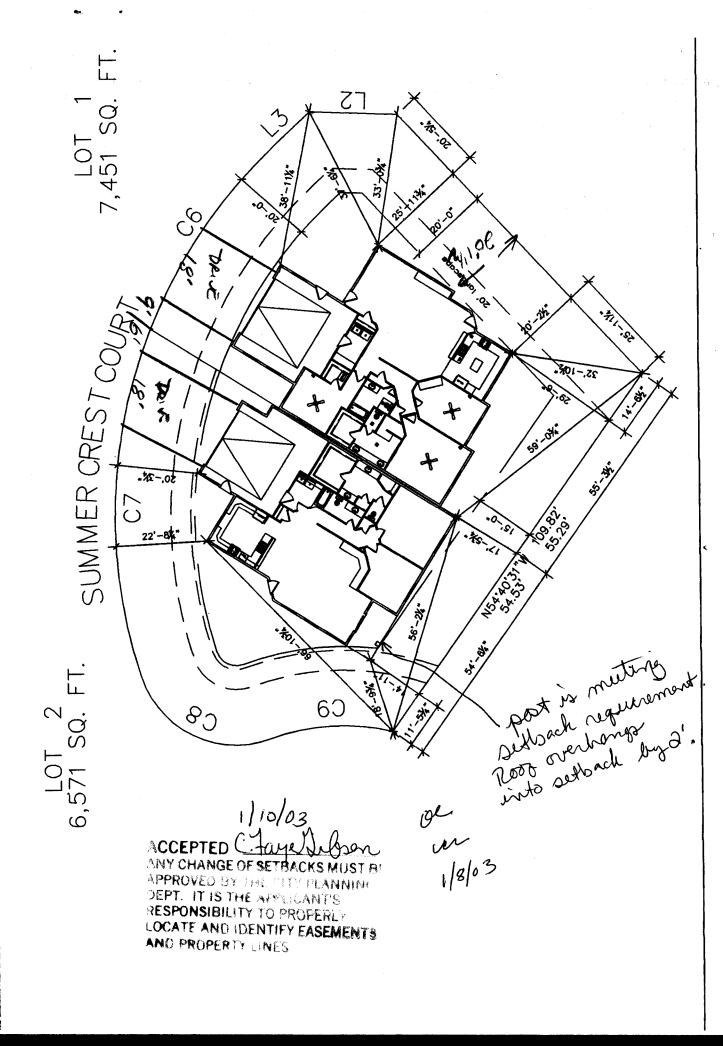

MICE: If is the responsibility of the sladder of owner to verify defined and darbarder fridt to construction.