

FEE \$ <u>10.00</u>
TCP \$ <u>500.00</u>
SIF \$ <u>298.00</u>

PLANNING CLEARANCE
(Single Family Residential and Accessory Structures)
Community Development Department

BLDG PERMIT NO. _____



Building Address 2808 Village Park Dr
Parcel No. 2943-063-44-017
Subdivision Village Park
Filing 1 Block 5 Lot 17

No. of Existing Bldgs _____ Proposed 1
Sq. Ft. of Existing Bldgs _____ Proposed 1807 #
Sq. Ft. of Lot / Parcel 5031 #
Sq. Ft. Coverage of Lot by Structures & Impervious Surface (Total Existing & Proposed) 1807 #

OWNER INFORMATION:

Name Sonshine II Construction
Address 2350 G ROAD
City / State / Zip Grand Junction CO 81505

DESCRIPTION OF WORK & INTENDED USE:

- New Single Family Home (*check type below)
- Interior Remodel Addition
- Other (please specify): _____

APPLICANT INFORMATION:

Name Sonshine II Construction
Address 2350 G ROAD
City / State / Zip Grand Junction CO 81505
Telephone 255-8853

***TYPE OF HOME PROPOSED:**

- Site Built Manufactured Home (UBC)
- Manufactured Home (HUD)
- Other (please specify): _____

NOTES: _____

REQUIRED: One plot plan, on 8 1/2" x 11" paper, showing all existing & proposed structure location(s), parking, setbacks to all property lines, ingress/egress to the property, driveway location & width & all easements & rights-of-way which abut the parcel.

THIS SECTION TO BE COMPLETED BY COMMUNITY DEVELOPMENT DEPARTMENT STAFF	
ZONE <u>PD</u>	Maximum coverage of lot by structures <u>50%</u>
SETBACKS: Front <u>15' House</u> from property line (PL) <u>20' Garage</u>	Permanent Foundation Required: YES <u>X</u> NO _____
Side <u>5'</u> from PL Rear <u>10'</u> from PL	Parking Requirement <u>2</u>
Maximum Height of Structure(s) <u>32'</u>	Special Conditions <u>Engineered foundation required</u>
Voting District <u>D</u> Driveway Location Approval <u>uu</u> (Engineer's Initials)	

Modifications to this Planning Clearance must be approved, in writing, by the Community Development Department. The structure authorized by this application cannot be occupied until a final inspection has been completed and a Certificate of Occupancy has been issued, if applicable, by the Building Department (Section 305, Uniform Building Code).

I hereby acknowledge that I have read this application and the information is correct; I agree to comply with any and all codes, ordinances, laws, regulations or restrictions which apply to the project. I understand that failure to comply shall result in legal action, which may include but not necessarily be limited to non-use of the building(s).

Applicant Signature D J McK Date 10-6-03

Department Approval NA U/KSW Date 10/31/03

Additional water and/or sewer tap fee(s) are required: YES <input checked="" type="checkbox"/> NO <input type="checkbox"/>	W/O No. <u>16701</u>
Utility Accounting <u>Q</u>	Date <u>10-31-03</u>


VALID FOR SIX MONTHS FROM DATE OF ISSUANCE (Section 2.2.C.1 Grand Junction Zoning & Development Code)
(White: Planning) (Yellow: Customer) (Pink: Building Department) (Goldenrod: Utility Accounting)

NOTICE:

- IT IS THE RESPONSIBILITY OF THE BUILDER OR OWNER TO VERIFY ALL DETAILS AND DIMENSIONS PRIOR TO CONSTRUCTION.
- USE OF THIS PLAN CONSTITUTES BUILDER AND OR HOME OWNERS ACCEPTANCE OF THESE TERMS.
- ALL DIMENSIONS ARE TO FACE OF STUD UNLESS OTHERWISE NOTED.
- WALLS ARE DRAWN AS 3-1/2" THICK FOR 2x4 WALLS AND 5-1/2" FOR 2x6 WALLS.
- THIS PLAN HAS NOT BEEN ENGINEERED BY AUTODRAFT. SEE SEPARATE DRAWINGS BY OTHERS FOR ENGINEERING DATA.

BLOCK 5
 LOT 17
 5031 sf

SETBACKS:
 FRONT SB TO GARAGE 20' (15' TO HOUSE)
 SIDE SB 5'
 REAR SB BY GRAND VIEW 25'
 REAR SB BY DAWN 20'
 REAR SB BY VILLAGE PARK 10'

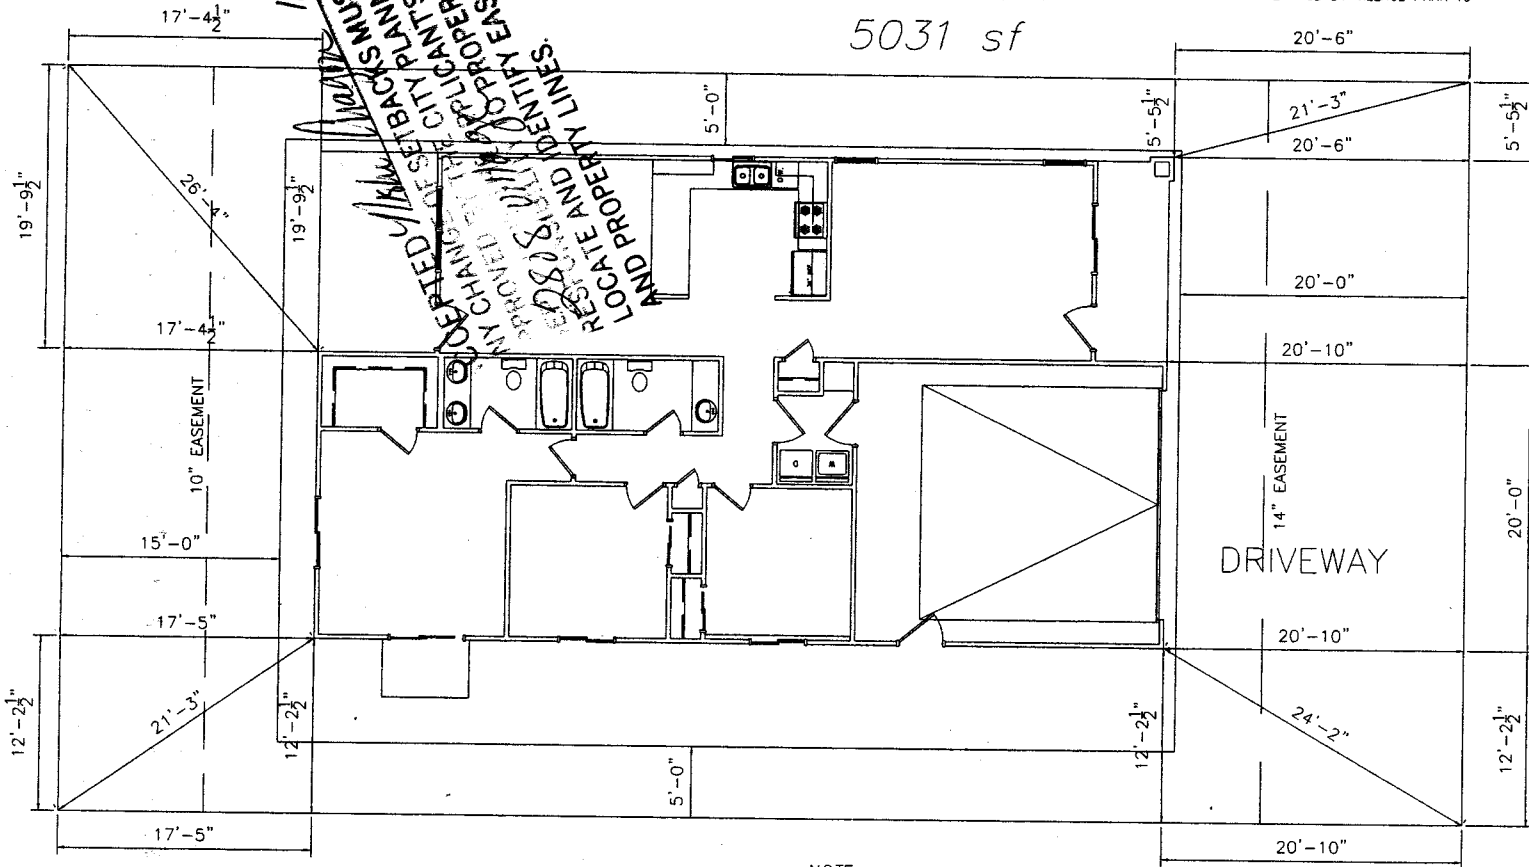

ACCEPTED/PAID FOR
 MY CHANGING CITY PLANNING
 APPLICATIONS
 LOCATE AND IDENTIFY EASEMENTS
 AND PROPERTY LINES.
 RESUBMIT TO THE CITY PLANNING
 DEPARTMENT FOR REVIEW
 9/18/03

Ok
 W
 10/1/03

NOTE:
 DIMENSIONS PULLED TO BRICK LEDGE
 VERIFY WITH FLOORPLAN


NOTE:
 BUILDER TO VERIFY
 ALL SETBACK AND EASEMENT
 ENCROACHMENTS PRIOR
 TO CONSTRUCTION

THE CHAMBERLAIN

VILLAGE PARK DRIVE

REVISIONS	
A	
B	
C	
D	
E	
F	
G	
H	

AUTODRAFT
 COMPUTER AIDED DRAFTING
 GRAND JUNCTION, CO (970) 241-6782

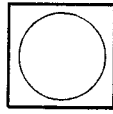

VILLAGE PARK
 THE CHAMBERLAIN

DRAWN BY
 AUTODRAFT
 FILE NAME
 CAD FILE
 DATE
 9-16-03
 SCALE
 1/4" = 1'-0"
SITE