

FEE \$	10.00
TCP \$	500.00
SIF \$	292.00

PLANNING CLEARANCE
 (Single Family Residential and Accessory Structures)
Community Development Department

BLDG PERMIT NO. _____



Your Bridge to a Better Community

BLDG ADDRESS 2864 YARROW SQ. FT. OF PROPOSED BLDGS/ADDITION 1484

TAX SCHEDULE NO. 2943-191-27-001 SQ. FT. OF EXISTING BLDGS -0-

SUBDIVISION White Willow TOTAL SQ. FT. OF EXISTING & PROPOSED 1484

FILING 1 BLK 7 LOT 1 NO. OF DWELLING UNITS:
 Before: 0 After: 1 this Construction

(1) OWNER TML ENTERPRISES INC NO. OF BUILDINGS ON PARCEL
 Before: 0 After: 1 this Construction

(1) ADDRESS P.O. Box 2569 USE OF EXISTING BUILDINGS N/A

(1) TELEPHONE 245-9271 DESCRIPTION OF WORK & INTENDED USE NEW HOME CONST.

(2) APPLICANT TML ENTERPRISES INC TYPE OF HOME PROPOSED:
 Site Built Manufactured Home (UBC)
 Manufactured Home (HUD)
 Other (please specify) _____

(2) ADDRESS P.O. Box 2569

(2) TELEPHONE 245-9271

REQUIRED: One plot plan, on 8 1/2" x 11" paper, showing all existing & proposed structure location(s), parking, setbacks to all property lines, ingress/egress to the property, driveway location & width & all easements & rights-of-way which abut the parcel.

THIS SECTION TO BE COMPLETED BY COMMUNITY DEVELOPMENT DEPARTMENT STAFF

ZONE RSF-4 Maximum coverage of lot by structures 50%

SETBACKS: Front 20' from property line (PL) Permanent Foundation Required: YES NO
 or _____ from center of ROW, whichever is greater

Side 7' from PL, Rear 25' from PL Parking Req'mt 2

Maximum Height 35' Special Conditions Engineered foundation required

CENSUS _____ TRAFFIC _____ ANNEX# _____

Modifications to this Planning Clearance must be approved, in writing, by the Community Development Department. The structure authorized by this application cannot be occupied until a final inspection has been completed and a Certificate of Occupancy has been issued, if applicable, by the Building Department (Section 305, Uniform Building Code).

I hereby acknowledge that I have read this application and the information is correct; I agree to comply with any and all codes, ordinances, laws, regulations or restrictions which apply to the project. I understand that failure to comply shall result in legal action, which may include but not necessarily be limited to non-use of the building(s).

Applicant Signature [Signature] Date 10/6/03


Department Approval NA [Signature] Date 10/15/03

Additional water and/or sewer tap fee(s) are required:	YES	NO	W/O No. <u>10/15/03</u>
Utility Accounting	<u>[Signature]</u>	Date	<u>10/15/03</u>


VALID FOR SIX MONTHS FROM DATE OF ISSUANCE (Section 9-3-2C Grand Junction Zoning & Development Code)

(White: Planning) (Yellow: Customer) (Pink: Building Department) (Goldenrod: Utility Accounting)

AM
10/6/03

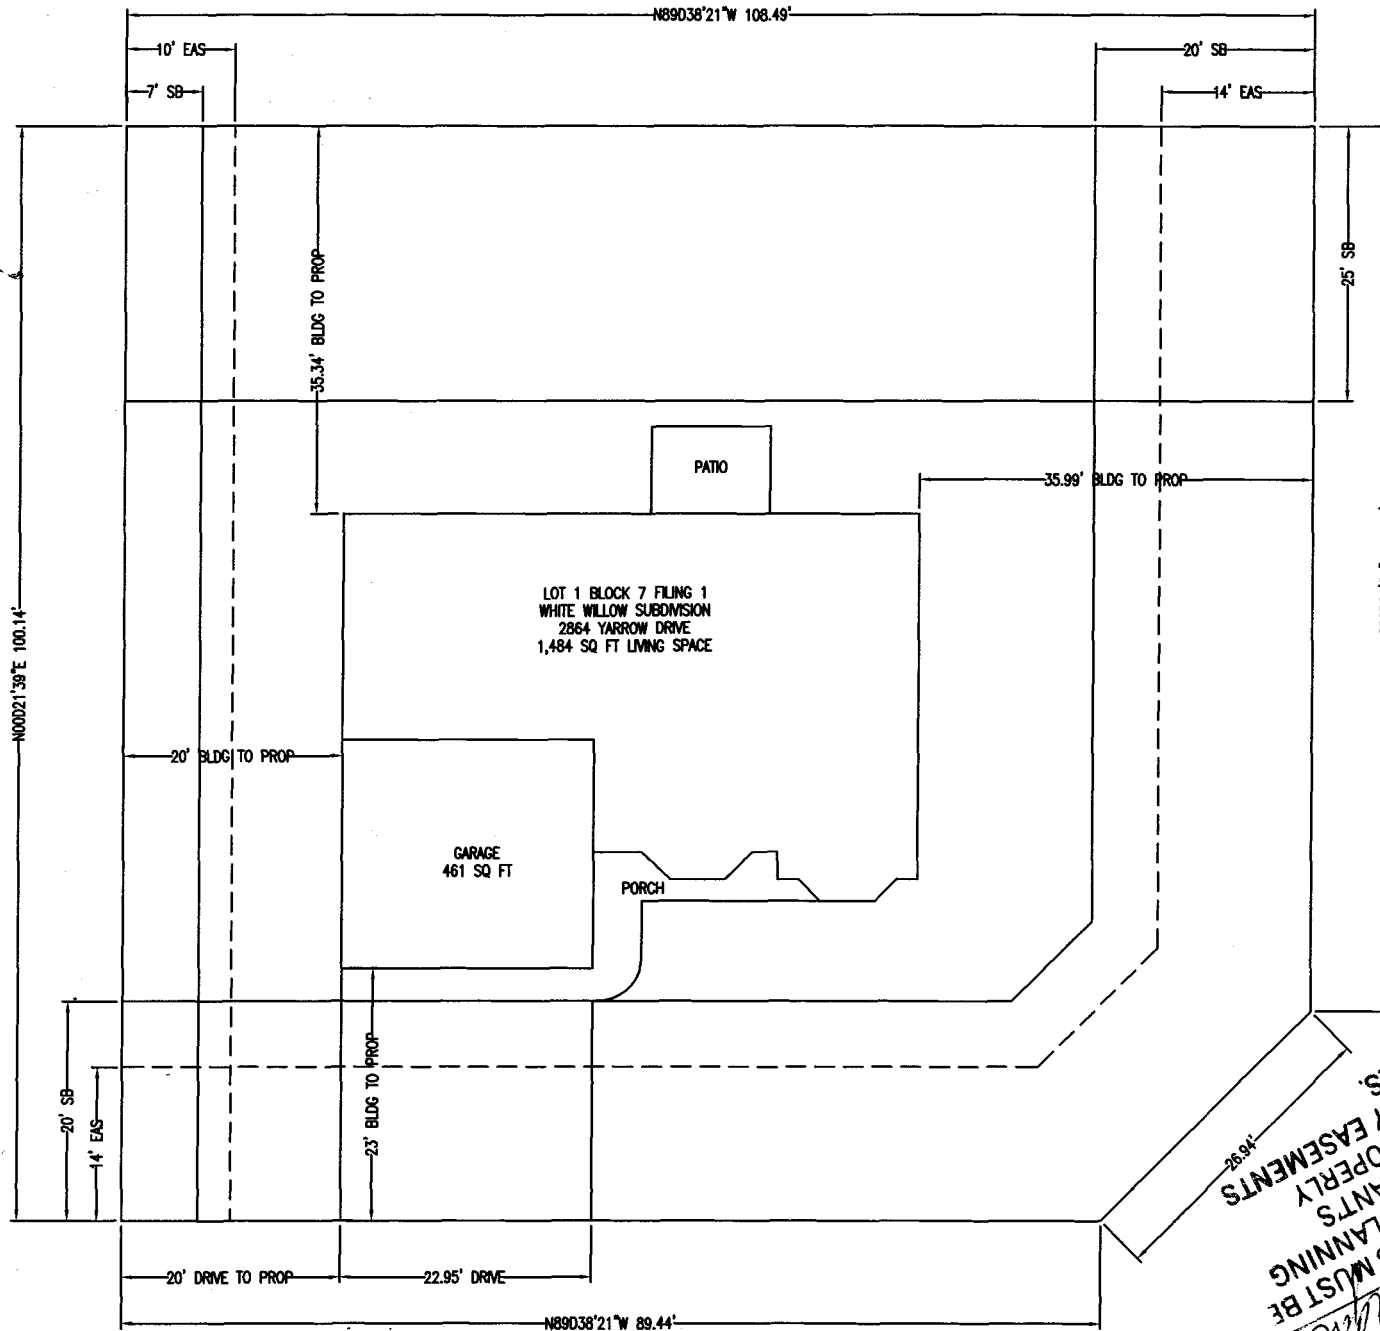

YARROW DRIVE

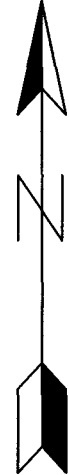

SORREL STREET

ACCEPTED OF SETBACKS MUST BE
APPROVED BY THE CITY PLANNING
DEPARTMENT IS THE APPLICANTS
RESPONSIBILITY TO PROPERLY
LOCATE AND IDENTIFY EASEMENTS
AND PROPERTY LINES.
Michelle Mason
10-16-03