
| FEE\$ /0.00° | PLANNING CLEA | RANCE BLDG PEI | RMIT NO. |
|--|--|---|--|
| TCP\$ | (Single Family Residential and Ad | | |
| SIF\$ | Community Developme | nt Department () | |
| Building Address | 699 26 20 | No. of Existing Bldgs | No. Proposed |
| Parcel No. 2945 | 7-031 -00-001 | Sq. Ft. of Existing Bldgs 1200 | Sq. Ft. Proposed 7t |
| Subdivision | | Sq. Ft. of Lot / Parcel O. GG& Acker | |
| Filing E | Block Lot | Sq. Ft. Coverage of Lot by Struct | tures & Impervious Surface |
| OWNER INFORMATION: | | (Total Existing & Proposed) DESCRIPTION OF WORK & INTENDED USE: | |
| Name FENNELL | | | |
| Address <u>699</u> | | New Single Family Home (*ct Interior Remodel | neck type below) LAddition |
| City / State / Zin | .J. CO 81506 | Other (please specify): | |
| City / State / Zip G. D. CO &/ JO6 APPLICANT INFORMATION: | | *TYPE OF HOME PROPOSED: | |
| | ATION: ARECSSON | Site Built Manufactured Home (HUD) | Manufactured Home (UBC) |
| | HAVOY HILL CT | Other (please specify): | |
| | .J. Co 8/506 | NOTES: | |
| | 7797 - 986-1313 | NOTES. | |
| REQUIRED: One plot plan, on 8 1/2" x 11" paper, showing all existing & proposed structure location(s), parking, setbacks to all | | | |
| | | | |
| property lines, ingress/ | egress to the property, driveway locatio | n & width & all easements & rights-c | of-way which abut the parcel. |
| THIS SECTION | | n & width & all easements & rights-o | of-way which abut the parcel. TMENT STAFF |
| THIS SECTIONS OF THE SECTIONS OF THE SECTIONS OF THE SECTION OF TH | Pegress to the property, driveway location of the COMPLETED BY COMM | n & width & all easements & rights-on MUNITY DEVELOPMENT DEPAR Maximum coverage of lot by structure. | of-way which abut the parcel. TMENT STAFF ctures 200 |
| THIS SECTIONS SETBACKS: Front | FION TO BE COMPLETED BY COMM | MUNITY DEVELOPMENT DEPAR Maximum coverage of lot by stru Permanent Foundation Required | of-way which abut the parcel. TMENT STAFF ctures 200 |
| THIS SECTIONS OF THE SECTIONS OF THE SECTIONS OF THE SECTION OF TH | FIGURE TO THE PROPERTY, driveway location FION TO BE COMPLETED BY COMP | n & width & all easements & rights-on MUNITY DEVELOPMENT DEPAR Maximum coverage of lot by structure. | of-way which abut the parcel. TMENT STAFF ctures 200 |
| THIS SECTIONS SETBACKS: Front | FION TO BE COMPLETED BY COMM from property line (PL) Rear from PL | MUNITY DEVELOPMENT DEPAR Maximum coverage of lot by stru Permanent Foundation Required | of-way which abut the parcel. TMENT STAFF ctures 200 |
| THIS SECTION SETBACKS: Front Side / 5 from | FION TO BE COMPLETED BY COMM from property line (PL) PL Rear 30' from PL ructure(s) 55' Driveway | MUNITY DEVELOPMENT DEPAR Maximum coverage of lot by strue Permanent Foundation Required Parking Requirement | of-way which abut the parcel. TMENT STAFF ctures 200 |
| THIS SECTIONS ZONE SETBACKS: Front Side Side | from property line (PL) PL Rear 30′ from PL ructure(s) Driveway Location Approval | Maximum coverage of lot by strue Permanent Foundation Required Parking Requirement Special Conditions in writing, by the Community Deventil a final inspection has been cores. | of-way which abut the parcel. TMENT STAFF ctures |
| THIS SECTONE ZONE SETBACKS: Front Side | PL Rear 30' from PL Driveway Location Approval (Engineer's Initials) anning Clearance must be approved, this application cannot be occupied u | Maximum coverage of lot by strue Permanent Foundation Required Parking Requirement Special Conditions in writing, by the Community Deventil a final inspection has been corpartment (Section 305, Uniform Buinformation is correct; I agree to corproject. I understand that failure to | Plopment Department. The inpleted and a Certificate of illding Code). |
| THIS SECTONE ZONE SETBACKS: Front Side | PL Rear from PL Tucture(s) (Engineer's Initials) anning Clearance must be approved, this application cannot be occupied usued, if applicable, by the Building De that I have read this application and the ations or restrictions which apply to the debut not accessarily be limited to not apply to the state of the property, and the state of the property of the state of the property of the state of the property of t | Maximum coverage of lot by strue Permanent Foundation Required Parking Requirement Special Conditions in writing, by the Community Deventil a final inspection has been corpartment (Section 305, Uniform Buinformation is correct; I agree to corproject. I understand that failure to | Plopment Department. The inpleted and a Certificate of illding Code). |
| THIS SECTONE ZONE SETBACKS: Front Side | from property, driveway location of the property, driveway location of the property, driveway location of the property line (PL) The property line (P | Maximum coverage of lot by strue Permanent Foundation Required Parking Requirement Special Conditions in writing, by the Community Deventil a final inspection has been corpartment (Section 305, Uniform Buinformation is correct; I agree to corproject. I understand that failure to n-use of the building(s). | Plopment Department. The inpleted and a Certificate of illding Code). |
| THIS SECTONE ZONE SETBACKS: Front Side | PL Rear from PL Tucture(s) (Engineer's Initials) anning Clearance must be approved, this application cannot be occupied usued, if applicable, by the Building De that I have read this application and the ations or restrictions which apply to the debut not accessarily be limited to not apply to the state of the property, and the state of the property of the state of the property of the state of the property of t | Maximum coverage of lot by strue Permanent Foundation Required Parking Requirement Special Conditions in writing, by the Community Deventil a final inspection has been corpartment (Section 305, Uniform Buinformation is correct; I agree to corpoject. I understand that failure to n-use of the building(s). Date | Plopment Department. The inpleted and a Certificate of illding Code). |
| THIS SECTONE ZONE SETBACKS: Front Side | from property line (PL) from property line (PL) PL Rear 30 from PL ructure(s) (Engineer's Initials) anning Clearance must be approved, this application cannot be occupied usued, if applicable, by the Building De that I have read this application and the ations or restrictions which apply to the debut not accessarily be limited to not | Maximum coverage of lot by strue Permanent Foundation Required Parking Requirement Special Conditions in writing, by the Community Deventil a final inspection has been corpartment (Section 305, Uniform Buinformation is correct; I agree to conproject. I understand that failure to n-use of the building(s). Date Date | Interest which abut the parcel. TMENT STAFF Ctures OOO YES NO Plopment Department. The inpleted and a Certificate of inding Code). Imply with any and all codes, o comply shall result in legal |

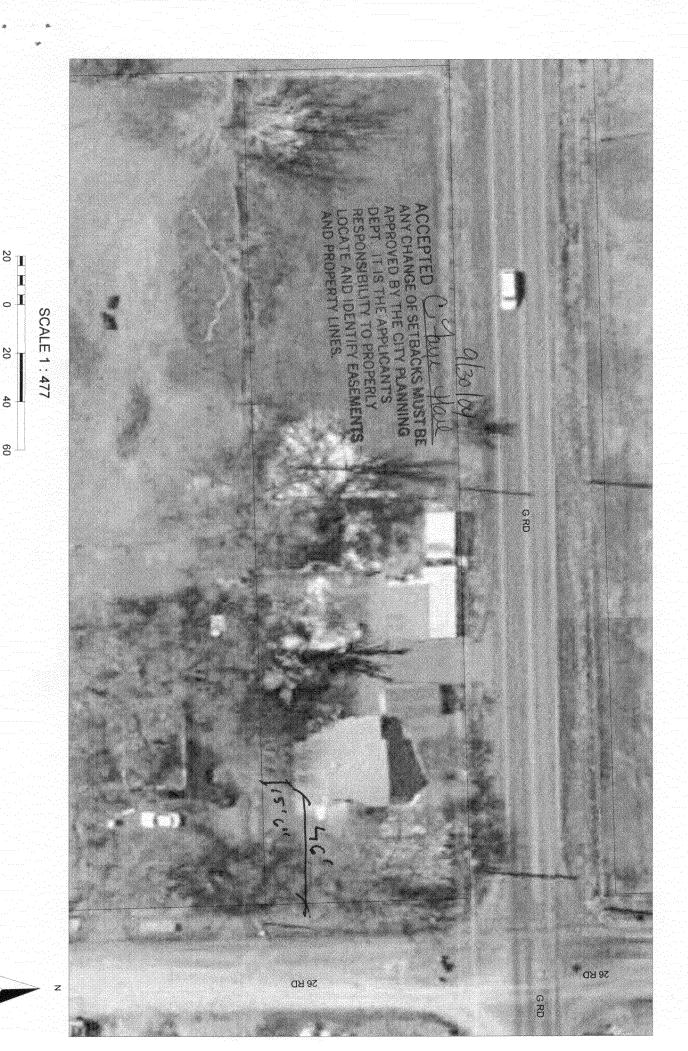

0

40

60

FEET 20