

FEE \$	10.00
TCP \$	1500.00
SIF \$	292.00

**PLANNING CLEARANCE**  
 (Single Family Residential and Accessory Structures)  
Community Development Department

BLDG PERMIT NO. \_\_\_\_\_

Building Address 3094 ABERDEEN  
 Parcel No. 2943-161-29-001  
 Subdivision YAKOTA WEST  
 Filing 2 Block 3 Lot 1

No. of Existing Bldgs 0 No. Proposed 1  
 Sq. Ft. of Existing Bldgs \_\_\_\_\_ Sq. Ft. Proposed 1550  
 Sq. Ft. of Lot / Parcel 7322  
 Sq. Ft. Coverage of Lot by Structures & Impervious Surface (Total Existing & Proposed) \_\_\_\_\_

**OWNER INFORMATION:**

Name G&R WEST LLC  
 Address 474 BISMARCK ST  
 City / State / Zip GRAND JUNCTION, CO 81504

**DESCRIPTION OF WORK & INTENDED USE:**

New Single Family Home (\*check type below)  
 Interior Remodel  Addition  
 Other (please specify): \_\_\_\_\_

**APPLICANT INFORMATION:**

Name \_\_\_\_\_  
 Address \_\_\_\_\_  
 City / State / Zip \_\_\_\_\_  
 Telephone (970) 255-8164

**TYPE OF HOME PROPOSED:**

Site Built  Manufactured Home (UBC)  
 Manufactured Home (HUD)  
 Other (please specify): \_\_\_\_\_

NOTES: \_\_\_\_\_

**REQUIRED: One plot plan, on 8 1/2" x 11" paper, showing all existing & proposed structure location(s), parking, setbacks to all property lines, ingress/egress to the property, driveway location & width & all easements & rights-of-way which abut the parcel.**

THIS SECTION TO BE COMPLETED BY COMMUNITY DEVELOPMENT DEPARTMENT STAFF			
ZONE <u>RMF-5</u>	Maximum coverage of lot by structures <u>60%</u>		
SETBACKS: Front <u>20'</u> from property line (PL)	Permanent Foundation Required: YES <input checked="" type="checkbox"/> NO <input type="checkbox"/>		
Side <u>5'</u> from PL Rear <u>25'</u> from PL	Parking Requirement <u>2</u>		
Maximum Height of Structure(s) <u>35'</u>	Special Conditions <u>Foundation observation</u>		
Voting District <u>"C"</u>	Driveway Location Approval <u>OK per Rick Davis</u> (Engineer's Initials)	<u>report by a licensed Engineer is required for bldg construction.</u>	

Modifications to this Planning Clearance must be approved, in writing, by the Community Development Department. The structure authorized by this application cannot be occupied until a final inspection has been completed and a Certificate of Occupancy has been issued, if applicable, by the Building Department (Section 305, Uniform Building Code).


I hereby acknowledge that I have read this application and the information is correct; I agree to comply with any and all codes, ordinances, laws, regulations or restrictions which apply to the project. I understand that failure to comply shall result in legal action, which may include but not necessarily be limited to non-use of the building(s).

Applicant Signature [Signature] Date 11-19-04  
 Department Approval Dayleen Henderson Date 11-24-04

Additional water and/or sewer tap fee(s) are required: YES <input checked="" type="checkbox"/> NO <input type="checkbox"/>	W/O No. <u>1774</u>
Utility Accounting <u>[Signature]</u>	Date <u>11/24/04</u>

VALID FOR SIX MONTHS FROM DATE OF ISSUANCE (Section 2.2.C.1 Grand Junction Zoning & Development Code)  
 (White: Planning) (Yellow: Customer) (Pink: Building Department) (Goldenrod: Utility Accounting)

DRIVEWAY PLACEMENT

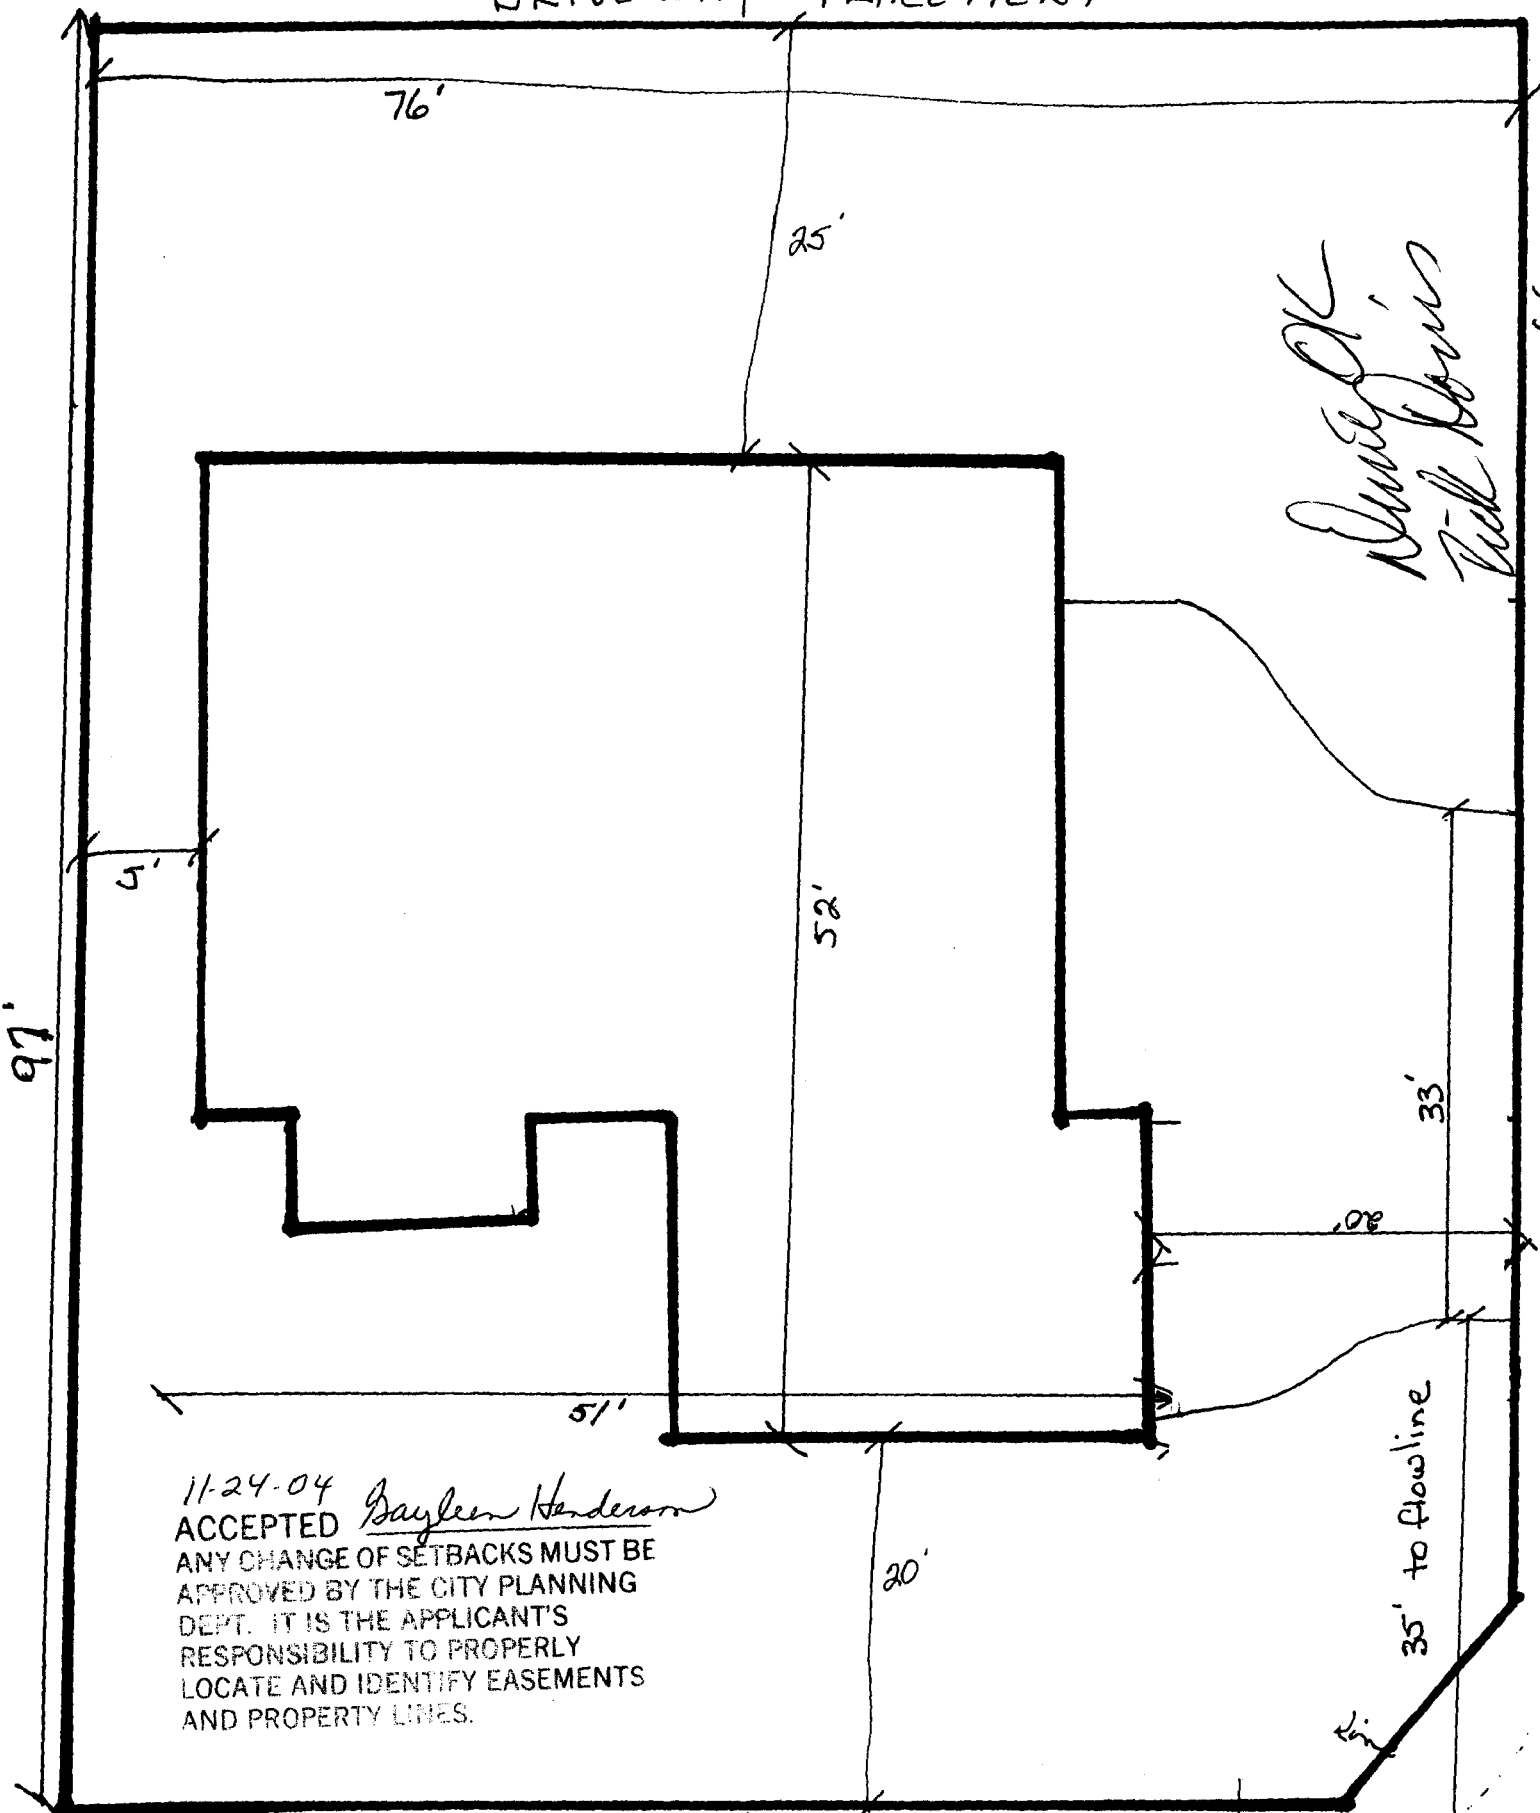

*Survey OK  
Tick Down*

11-23-04

11-24-04 *Gayleen Henderson*  
ACCEPTED  
ANY CHANGE OF SETBACKS MUST BE APPROVED BY THE CITY PLANNING DEPT. IT IS THE APPLICANT'S RESPONSIBILITY TO PROPERLY LOCATE AND IDENTIFY EASEMENTS AND PROPERTY LINES.

3094 ABERDEEN

G+R WEST 255-8164