

FEE \$	10.00
TCP \$	None
SIF \$	292.00

# PLANNING CLEARANCE <sup>N</sup>

(Single Family Residential and Accessory Structures)  
**Community Development Department**

BLDG PERMIT NO.
-----------------

Building Address 2507 Buchanan  
 Parcel No. 2945-032-10-016  
 Subdivision Colonial Heights  
 Filing 3 Block 2 Lot 16

No. of Existing Bldgs \_\_\_\_\_ No. Proposed ~~2~~ 1  
 Sq. Ft. of Existing Bldgs \_\_\_\_\_ Sq. Ft. Proposed 2290  
 Sq. Ft. of Lot / Parcel \_\_\_\_\_  
 Sq. Ft. Coverage of Lot by Structures & Impervious Surface (Total Existing & Proposed) \_\_\_\_\_

**OWNER INFORMATION:**

Name Sonshine II  
 Address 2350 G Road  
 City / State / Zip Grand Jet, CD 81505

**DESCRIPTION OF WORK & INTENDED USE:**

New Single Family Home (\*check type below)  
 Interior Remodel  Addition  
 Other (please specify): \_\_\_\_\_

**APPLICANT INFORMATION:**

Name Sonshine II  
 Address 2350 G Road  
 City / State / Zip Grand Jet, CD 81505  
 Telephone 255-8853

**\*TYPE OF HOME PROPOSED:**

Site Built  Manufactured Home (UBC)  
 Manufactured Home (HUD)  
 Other (please specify): \_\_\_\_\_

NOTES: \_\_\_\_\_

**REQUIRED: One plot plan, on 8 1/2" x 11" paper, showing all existing & proposed structure location(s), parking, setbacks to all property lines, ingress/egress to the property, driveway location & width & all easements & rights-of-way which abut the parcel.**

<b>THIS SECTION TO BE COMPLETED BY COMMUNITY DEVELOPMENT DEPARTMENT STAFF</b>	
ZONE <u>RMF-5</u>	Maximum coverage of lot by structures <u>60%</u>
SETBACKS: Front <u>20'</u> from property line (PL)	Permanent Foundation Required: YES <u>X</u> NO _____
Side <u>5'</u> from PL Rear <u>25'</u> from PL	Parking Requirement <u>2</u>
Maximum Height of Structure(s) <u>35'</u>	Special Conditions <u>Approval Letter required from Lic Eng.</u>
Voting District <u>B</u> Driveway Location Approval <u>NA</u> <small>(Engineer's Initials)</small>	<u>Flood Plain Permit approved.</u>

Modifications to this Planning Clearance must be approved, in writing, by the Community Development Department. The structure authorized by this application cannot be occupied until a final inspection has been completed and a Certificate of Occupancy has been issued, if applicable, by the Building Department (Section 305, Uniform Building Code).



I hereby acknowledge that I have read this application and the information is correct; I agree to comply with any and all codes, ordinances, laws, regulations or restrictions which apply to the project. I understand that failure to comply shall result in legal action, which may include but not necessarily be limited to non-use of the building(s).

Applicant Signature [Signature] Date 8-25-04  
 Department Approval NA Date \_\_\_\_\_

Additional water and/or sewer tap fee(s) are required:	YES <input checked="" type="checkbox"/>	NO <input type="checkbox"/>	W/O No. <u>7812</u>
Utility Accounting <u>[Signature]</u>	Date <u>12/23/04</u>		

VALID FOR SIX MONTHS FROM DATE OF ISSUANCE (Section 2.2.C.1 Grand Junction Zoning & Development Code)  
 (White: Planning) (Yellow: Customer) (Pink: Building Department) (Goldenrod: Utility Accounting)

# BUCHANAN DRIVE

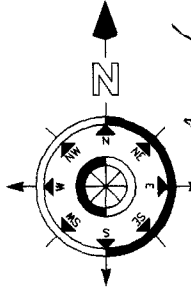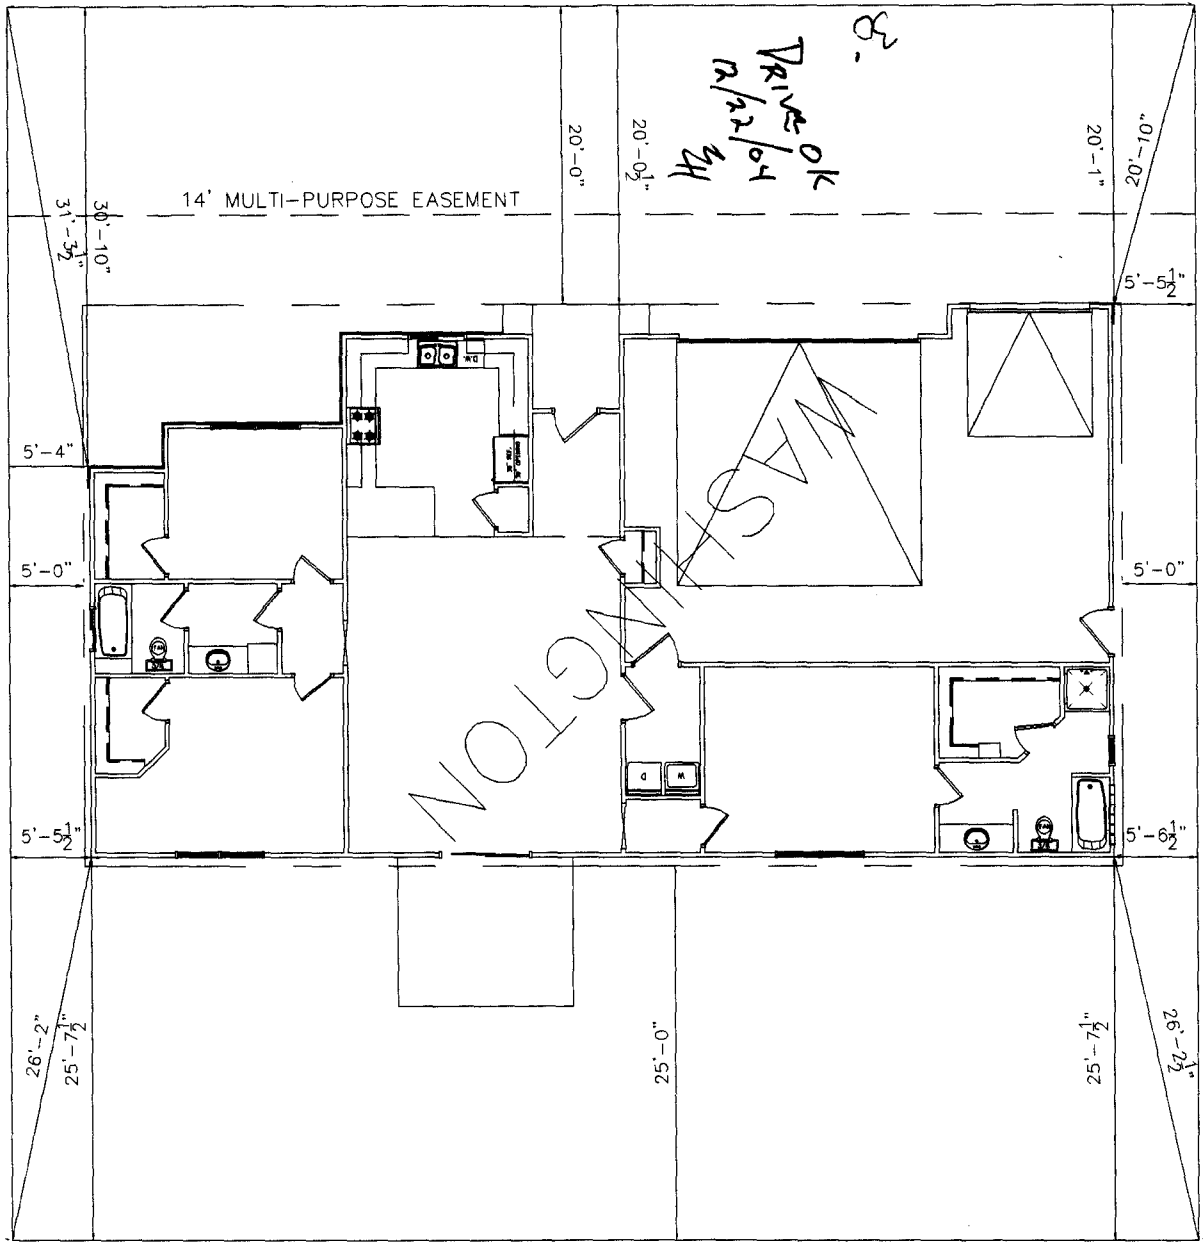

*ACCEPTED / Alan Chan 12/22/04*  
**ANY CHANGE OF SETBACKS MUST BE APPROVED BY THE CITY PLANNING DEPARTMENT. THE PLANNING DEPARTMENT ACCEPTS NO RESPONSIBILITY TO PROPERLY LOCATE AND IDENTIFY EASEMENTS AND PROPERTY LINES.**

NOTE:  
 GRADE MUST SLOPE AWAY FROM HOUSE 6" OF FALL IN THE FIRST 10' OF DISTANCE PER LOCAL BUILDING CODE.

NOTE:  
 DIMENSION LINES ARE PULLED FROM EDGE OF BRICK LEDGE. IF NO BRICK LEDGE EXISTS, DIMENSIONS WILL BE FROM EDGE OF FOUNDATION.

NOTE:  
 BUILDER TO VERIFY ALL SETBACK AND EASEMENT ENCROACHMENTS PRIOR TO CONSTRUCTION

SITE PLAN INFORMATION	
SUBDIVISION NAME	COLONIAL HEIGHTS- FILING 3
LOT NUMBER	16
BLOCK NUMBER	2
STREET ADDRESS	2507 BUCHANAN DRIVE
COUNTY	MESA
HOUSE SQ. FT.	?
LOT SIZE	6610 SF
SETBACKS USED	FRONT 20'
	SIDES 5'
	REAR 25'

**SCALE: N.T.S.**

FEDERAL EMERGENCY MANAGEMENT AGENCY  
 NATIONAL FLOOD INSURANCE PROGRAM  
**ELEVATION CERTIFICATE**

O.M.B. No. 3067-0077  
 Expires December 31, 2005

Important: Read the instructions on pages 1 - 7.

<b>SECTION A - PROPERTY OWNER INFORMATION</b>			For Insurance Company Use:		
BUILDING OWNER'S NAME <b>SONSHINE II CONSTRUCTION</b>			Policy Number		
BUILDING STREET ADDRESS (including Apt., Unit, Suite, and/or Bldg. No.) OR P.O. ROUTE AND BOX NO. <b>2507 Buchanan Drive</b>			Company NAIC Number		
CITY <b>GRAND JUNCTION</b>		STATE <b>CO</b>	ZIP CODE <b>81505</b>		
PROPERTY DESCRIPTION (Lot and Block Numbers, Tax Parcel Number, Legal Description, etc.) <b>LOT 16, BLK 2, COLONIAL HEIGHTS FILING III, BK 3573, PG'S 304-307 PARCEL # 2945-032-10-016</b>					
BUILDING USE (e.g., Residential, Non-residential, Addition, Accessory, etc. Use a Comments area, if necessary.) <b>RESIDENTIAL</b>					
LATITUDE/LONGITUDE (OPTIONAL) (##° - ##' - ##.##" or ###.###")		HORIZONTAL DATUM: <input checked="" type="checkbox"/> NAD 1927 <input type="checkbox"/> NAD 1983		SOURCE: <input type="checkbox"/> GPS (Type): _____ <input type="checkbox"/> USGS Quad Map <input checked="" type="checkbox"/> Other: <b>PLAT</b>	

**SECTION B - FLOOD INSURANCE RATE MAP (FIRM) INFORMATION**

B1. NFIP COMMUNITY NAME & COMMUNITY NUMBER <b>GRAND JUNCTION, COMMUNITY NUMBER 080117</b>		B2. COUNTY NAME <b>MESA</b>		B3. STATE <b>CO</b>	
B4. MAP AND PANEL NUMBER <b>0801170003</b>	B5. SUFFIX <b>E</b>	B6. FIRM INDEX DATE <b>1-06-1992 1992</b>	B7. FIRM PANEL EFFECTIVE/REVISED DATE <b>7-15-1992</b>	B8. FLOOD ZONE(S) <b>AO</b>	B9. BASE FLOOD ELEVATION(S) (Zone AO, use depth of flooding) <b>4590</b>

B10. Indicate the source of the Base Flood Elevation (BFE) data or base flood depth entered in B9.  
 FIS Profile  FIRM  Community Determined  Other (Describe): \_\_\_\_\_

B11. Indicate the elevation datum used for the BFE in B9:  NGVD 1929  NAVD 1988  Other (Describe): \_\_\_\_\_

B12. Is the building located in a Coastal Barrier Resources System (CBRS) area or Otherwise Protected Area (OPA)?  Yes  No Designation Date \_\_\_\_\_

**SECTION C - BUILDING ELEVATION INFORMATION (SURVEY REQUIRED)**

C1. Building elevations are based on:  Construction Drawings\*  Building Under Construction\*  Finished Construction  
 \*A new Elevation Certificate will be required when construction of the building is complete.

C2. Building Diagram Number 1 (Select the building diagram most similar to the building for which this certificate is being completed - see pages 6 and 7. If no diagram accurately represents the building, provide a sketch or photograph.)

C3. Elevations - Zones A1-A30, AE, AH, A (with BFE), VE, V1-V30, V (with BFE), AR, ARIA, ARIAE, ARIA1-A30, ARIA/H, ARIA/O  
 Complete items C3.-a-i below according to the building diagram specified in item C2. State the datum used. If the datum is different from the datum used for the BFE in Section B, convert the datum to that used for the BFE. Show field measurements and datum conversion calculation. Use the space provided or the Comments area of Section D or Section G, as appropriate, to document the datum conversion.  
 Datum **NAVD88** Conversion/Comments **NGVD1929 BFE 4590 + 3.0 = 4593.0 BFE NAVD88**

Elevation reference mark used \_\_\_\_\_ Does the elevation reference mark used appear on the FIRM?  Yes  No

a) Top of bottom floor (including basement or enclosure) **4594.00** ft.(m)

b) Top of next higher floor **N/A** ft.(m)

c) Bottom of lowest horizontal structural member (V zones only) **N/A** ft.(m)

d) Attached garage (top of slab) **N/A** ft.(m)


e) Lowest elevation of machinery and/or equipment servicing the building (Describe in a Comments area) **N/A** ft.(m)

f) Lowest adjacent (finished) grade (LAG) \_\_\_\_\_ ft.(m)

g) Highest adjacent (finished) grade (HAG) \_\_\_\_\_ ft.(m)

h) No. of permanent openings (flood vents) within 1 ft. above adjacent grade **N/A**

i) Total area of all permanent openings (flood vents) in C3,h **N/A** sq. in. (sq. cm)

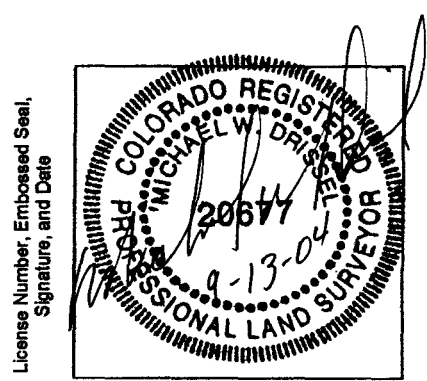

**SECTION D - SURVEYOR, ENGINEER, OR ARCHITECT CERTIFICATION**

This certification is to be signed and sealed by a land surveyor, engineer, or architect authorized by law to certify elevation information.  
 I certify that the information in Sections A, B, and C on this certificate represents my best efforts to interpret the data available.  
 I understand that any false statement may be punishable by fine or imprisonment under 18 U.S. Code, Section 1001.

CERTIFIER'S NAME **MICHAEL W. DRISSEL** LICENSE NUMBER **PLS 20677**

TITLE <b>PRESIDENT/PLS</b>	COMPANY NAME <b>DH SURVEYS INC</b>
ADDRESS <b>118 OURAY AVENUE</b>	CITY <b>GRAND JUNCTION</b>
SIGNATURE <i>[Signature]</i>	STATE <b>CO</b>
	ZIP CODE <b>81501</b>
	DATE <b>9-13-04</b>
	TELEPHONE <b>(970)245-8749</b>

**IMPORTANT: In these spaces, copy the corresponding information from Section A.**

BUILDING STREET ADDRESS (Including Apt., Unit, Suite, and/or No.) OR P.O. ROUTE AND BOX NO.

2507 Buchanan Drive

CITY  
GRAND JUNCTION

STATE  
CO

ZIP CODE  
81505

For Insurance Company Use:

Policy Number

Company NAIC Number

**SECTION D - SURVEYOR, ENGINEER, OR ARCHITECT CERTIFICATION (CONTINUED)**

Copy both sides of this Elevation Certificate for (1) community official, (2) insurance agent/company, and (3) building owner.

COMMENTS

Check here if attachments

**SECTION E - BUILDING ELEVATION INFORMATION (SURVEY NOT REQUIRED) FOR ZONE AO AND ZONE A (WITHOUT BFE)**

For Zone AO and Zone A (without BFE), complete items E1 through E4. If the Elevation Certificate is intended for use as supporting information for a LOMA or LOMR-F, Section C must be completed.

- E1. Building Diagram Number (Select the building diagram most similar to the building for which this certificate is being completed - see pages 6 and 7. If no diagram accurately represents the building, provide a sketch or photograph.)
- E2. The top of the bottom floor (including basement or enclosure) of the building is \_\_\_ ft.(m) \_\_\_ in.(cm)  above or  below (check one) the highest adjacent grade. (Use natural grade, if available).
- E3. For Building Diagrams 6-8 with openings (see page 7), the next higher floor or elevated floor (elevation b) of the building is \_\_\_ ft.(m) \_\_\_ in.(cm) above the highest adjacent grade. Complete items C3.h and C3.i on front of form.
- E4. The top of the platform of machinery and/or equipment servicing the building is \_\_\_ ft.(m) \_\_\_ in.(cm)  above or  below (check one) the highest adjacent grade. (Use natural grade, if available).
- E5. For Zone AO only: If no flood depth number is available, is the top of the bottom floor elevated in accordance with the community's floodplain management ordinance?  
 Yes  No  Unknown. The local official must certify this information in Section G.

**SECTION F - PROPERTY OWNER (OR OWNER'S REPRESENTATIVE) CERTIFICATION**

The property owner or owner's authorized representative who completes Sections A, B, C (Items C3.h and C3.i only), and E for Zone A (without a FEMA-issued or community-issued BFE) or Zone AO must sign here. The statements in Sections A, B, C, and E are correct to the best of my knowledge.

PROPERTY OWNER'S OR OWNER'S AUTHORIZED REPRESENTATIVE'S NAME

SONSHINE CONSTRUCTION II

ADDRESS  
2350 G ROAD

CITY  
GRAND JUNCTION

STATE  
CO ZIP CODE  
81505

SIGNATURE

*[Handwritten Signature]*

DATE  
9/14/04

TELEPHONE  
970-255-8853

COMMENTS

Check here if attachments

**SECTION G - COMMUNITY INFORMATION (OPTIONAL)**

The local official who is authorized by law or ordinance to administer the community's floodplain management ordinance can complete Sections A, B, C (or E), and G of this Elevation Certificate. Complete the applicable item(s) and sign below.

- G1.  The information in Section C was taken from other documentation that has been signed and embossed by a licensed surveyor, engineer, or architect who is authorized by state or local law to certify elevation information. (Indicate the source and date of the elevation data in the Comments area below.)
- G2.  A community official completed Section E for a building located in Zone A (without a FEMA-issued or community-issued BFE) or Zone AO.
- G3.  The following information (Items G4-G9) is provided for community floodplain management purposes.

G4. PERMIT NUMBER FLP-2004-214	G5. DATE PERMIT ISSUED 9/30/04	G6. DATE CERTIFICATE OF COMPLIANCE/OCCUPANCY ISSUED
-----------------------------------	-----------------------------------	---

- G7. This permit has been issued for:  New Construction  Substantial Improvement
- G8. Elevation of as-built lowest floor (including basement) of the building is: 4594 ft. (m) Datum: NAV 88
- G9. BFE or (in Zone AO) depth of flooding at the building site is: 4593 ft. (m) Datum: NAV 88

LOCAL OFFICIAL'S NAME Rick Dorris	TITLE Development Engineer
COMMUNITY NAME City of Grand Junction	TELEPHONE 970-256-4034
SIGNATURE <i>[Handwritten Signature]</i>	DATE 9-30-04
COMMENTS	

Check here if attachments